




16

21A

17

18

19

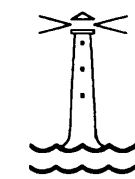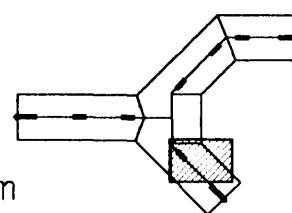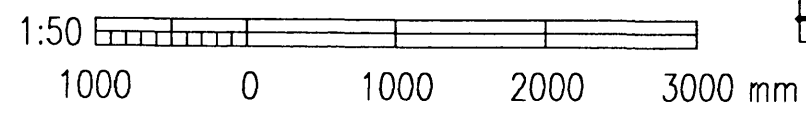

Teikn. nr.	Tilvitun á teikningu	Br.	Dags.	Eðli breytingar	Yr.	Sp.
		B1	25.04.94	Eldvörn og merkingar	AJM	

**AJM**-Lagnahönnun  
 Arnar J. Magnússon,  
 Löngumýri 26, 210 Garðabæ,  
 s. 65 73 12 - fax. 65 73 12.

25 JAN. 1995  
 ÁSKILID, ELSA  
 TEIKNING ÓCILD

HVALEYRARSKÓLI, 2. ÁFANGI			
LAGNIR FRÁVEITULAGNIR EFRI GRUNNLACNIR FYRIR BÖÐ OG BUNINGSKLEFA			
Dagsetning	Verk nr.	Teikn. nr.	Mætti-vorði
21.03.1994	94.01	2.14-B1	1:50