
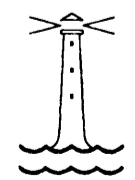
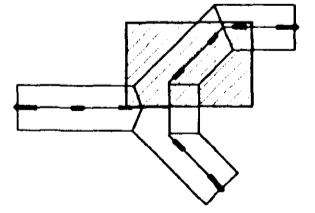


06 SEPT. 1995

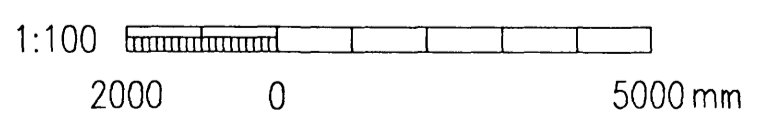

Teikn. nr.	Tilvisun á teikningu	Br.	Dags.	Eðli breytingar	Yf.	Sp.
B1			17.08.95	Reyndarteikning	AJM	

AJM-Lagnahönnun
 Arnar J. Magnússon,
 Langumýri 26, 210 Garðabæ,
 s. 65 73 12 - fax. 65 73 12.

HVALEYRARSKÓLI, 2. ÁFANGI
 LAGNIR
 SNJÓBRÆDSLULAGNIR
 TENGING VID FYRRI ÁFANGA

12.05.95 94.01 2.29-B1 1:100

Arnar Magnússon