




Slaufa I (195 m)
 Slaufa J (175 m)
 Slaufa K (165 m)
 Slaufa L (230 m)
 Slaufa M (230 m)
 Slaufa N (230 m)

Á frams eru lokar, en
 á bakrás eru stillilokar
 og hitamælur.

Slaufa A (185 m)
 Slaufa B (190 m)
 Slaufa C (205 m)
 Slaufa D (185 m)

Á frams eru lokar, en
 á bakrás eru stillilokar
 og hitamælur.

25 JAN. 1995
ÁSKILD, ELÐRI
TEIKNING OGILD

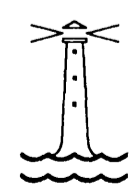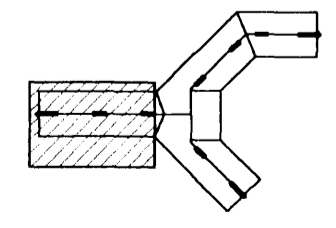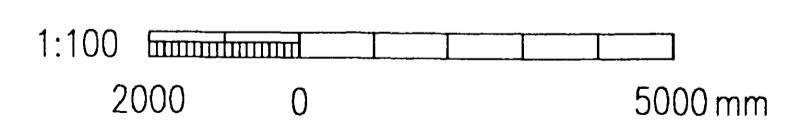

Teikn. nr.	Tilvisun á teikningu	Br.	Dags.	Eðli breytingar	Yr.	Sp.
		B1	24.06.94	Snjóbræðsla sett í tröppur	AJM	

AJM-Lagnahönnun
 Arnar J. Magnússon,
 Langumýri 26, 210 Garðabæ,
 s. 65 73 12 - fax. 65 73 12.

HVALEYRARSKÓLI, 2. ÁFANGI
 LAGNIR
 SNJÓBRÆDSLULAGNIR
 VESTAN OG SUNNAN VÍÐ VESTURÁLMI

Dagsetning 28.04.1994 Vorkr. 94.01 Teikn. nr. 2.27-B1 Málsvæði 1:100

Arnar Magnússon