




BS3
105 121 SNID

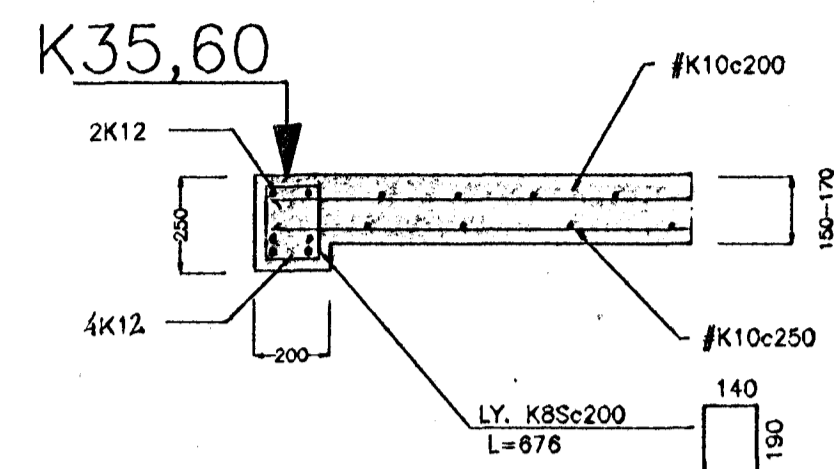


TL1
105 121 SNID

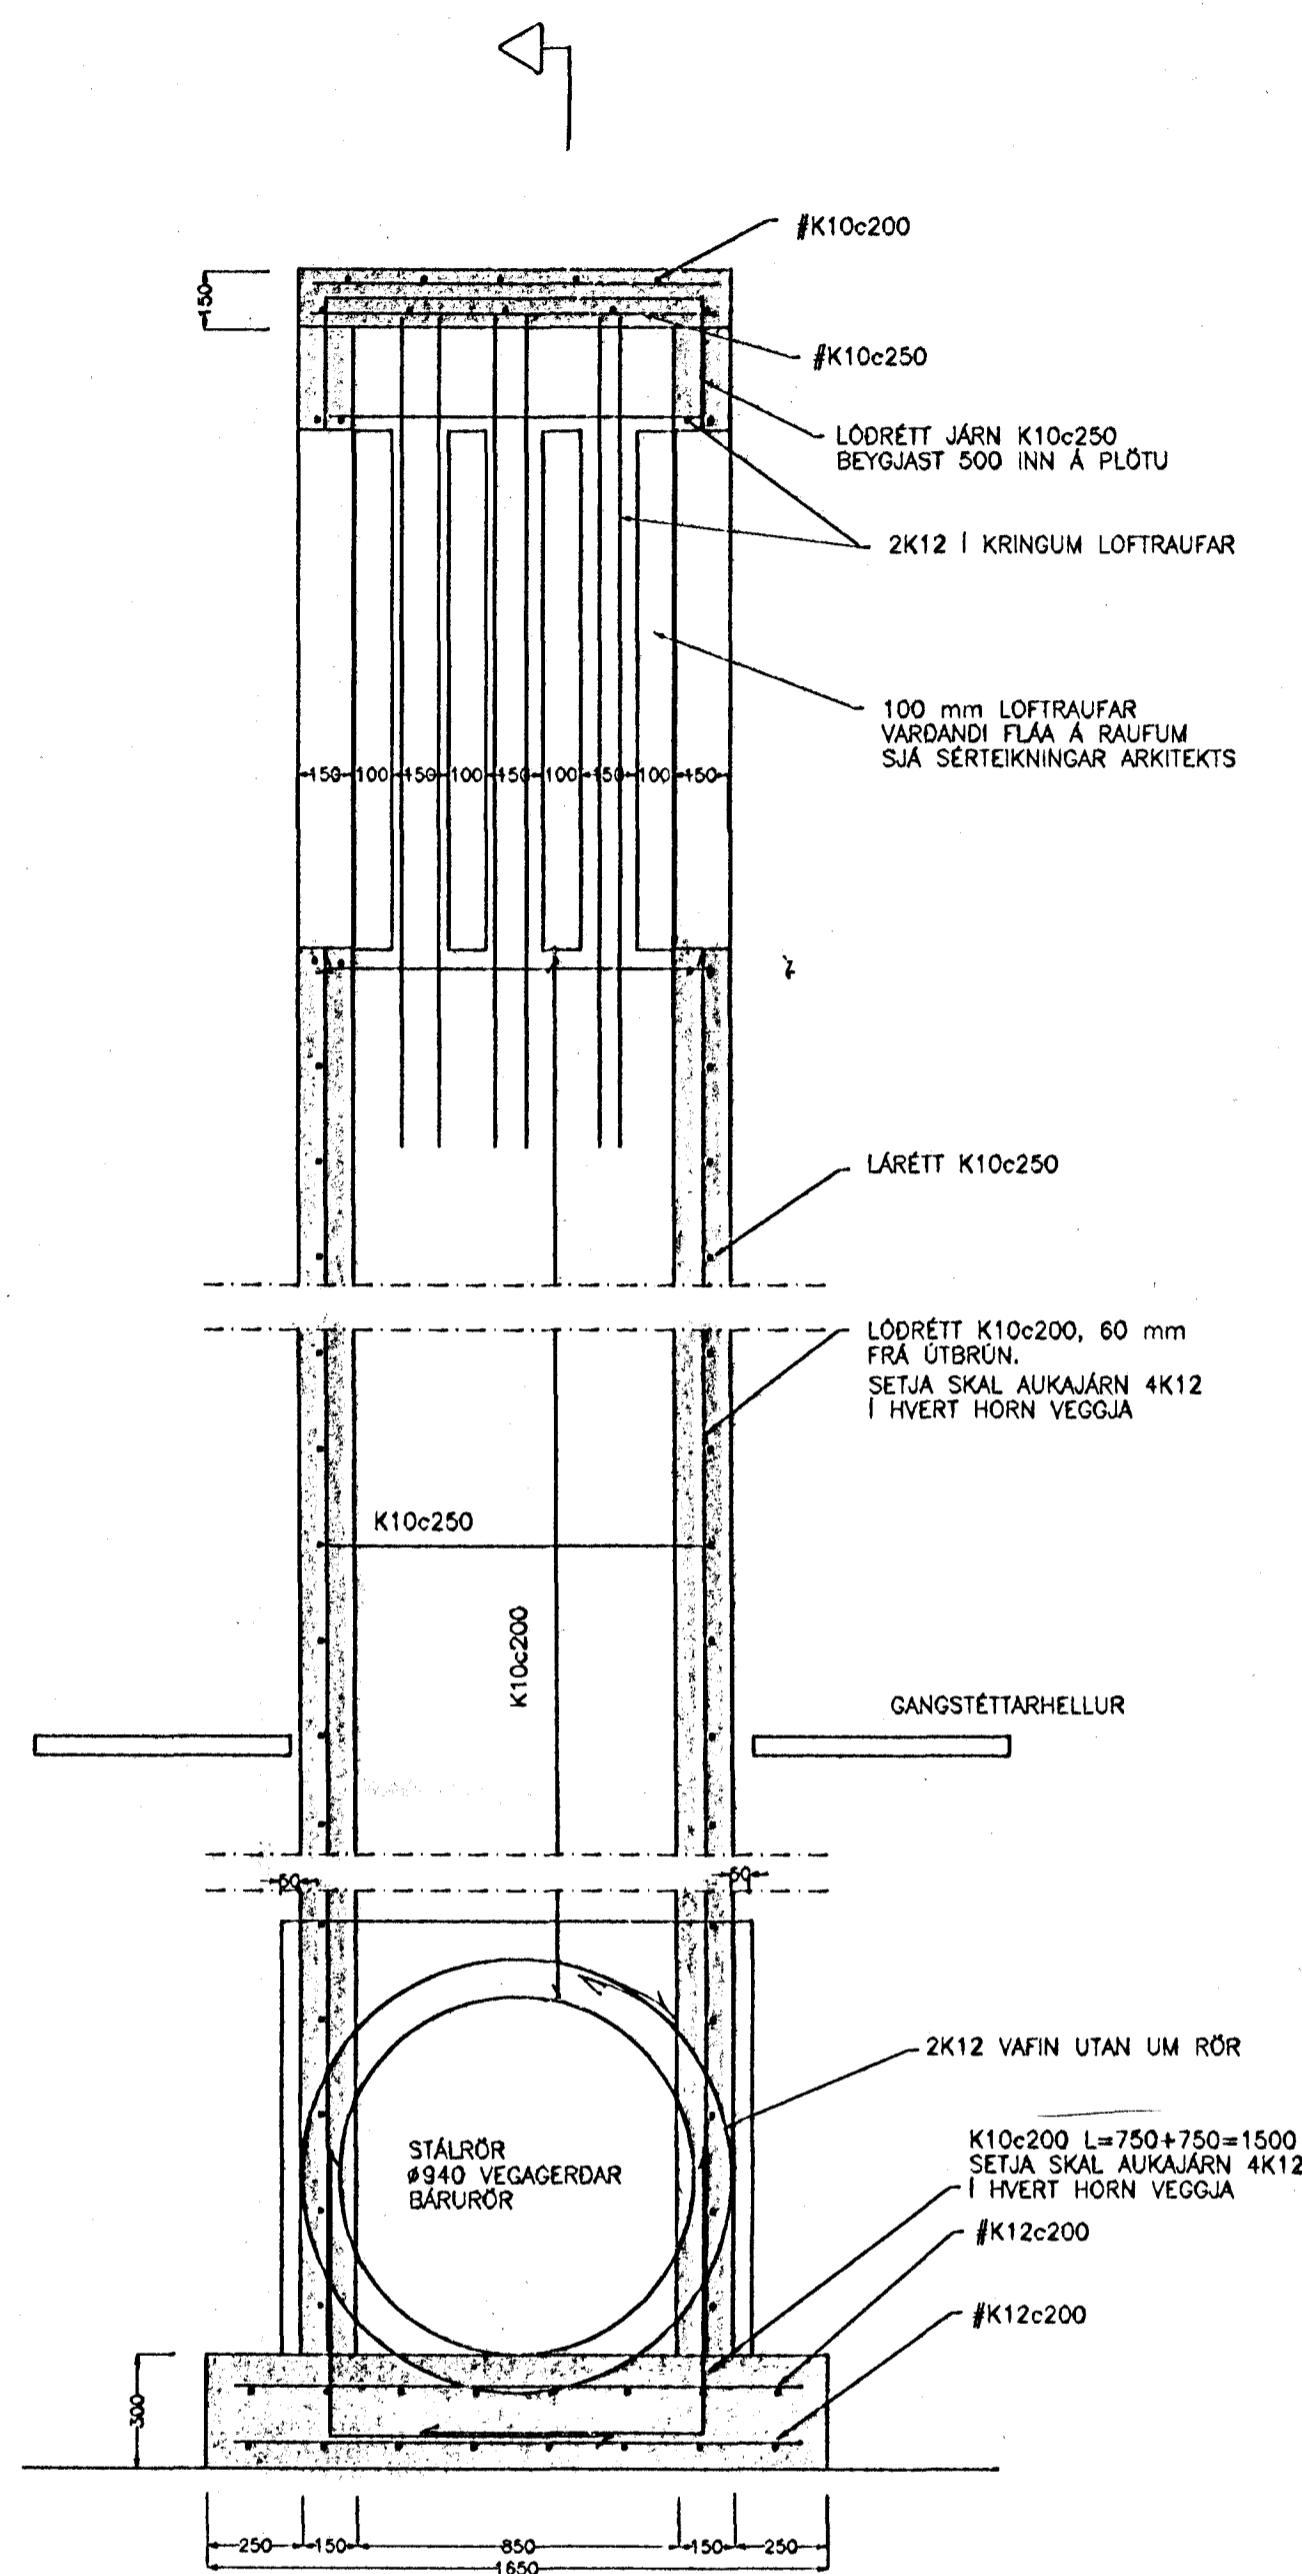


TL2
105 121 SNID

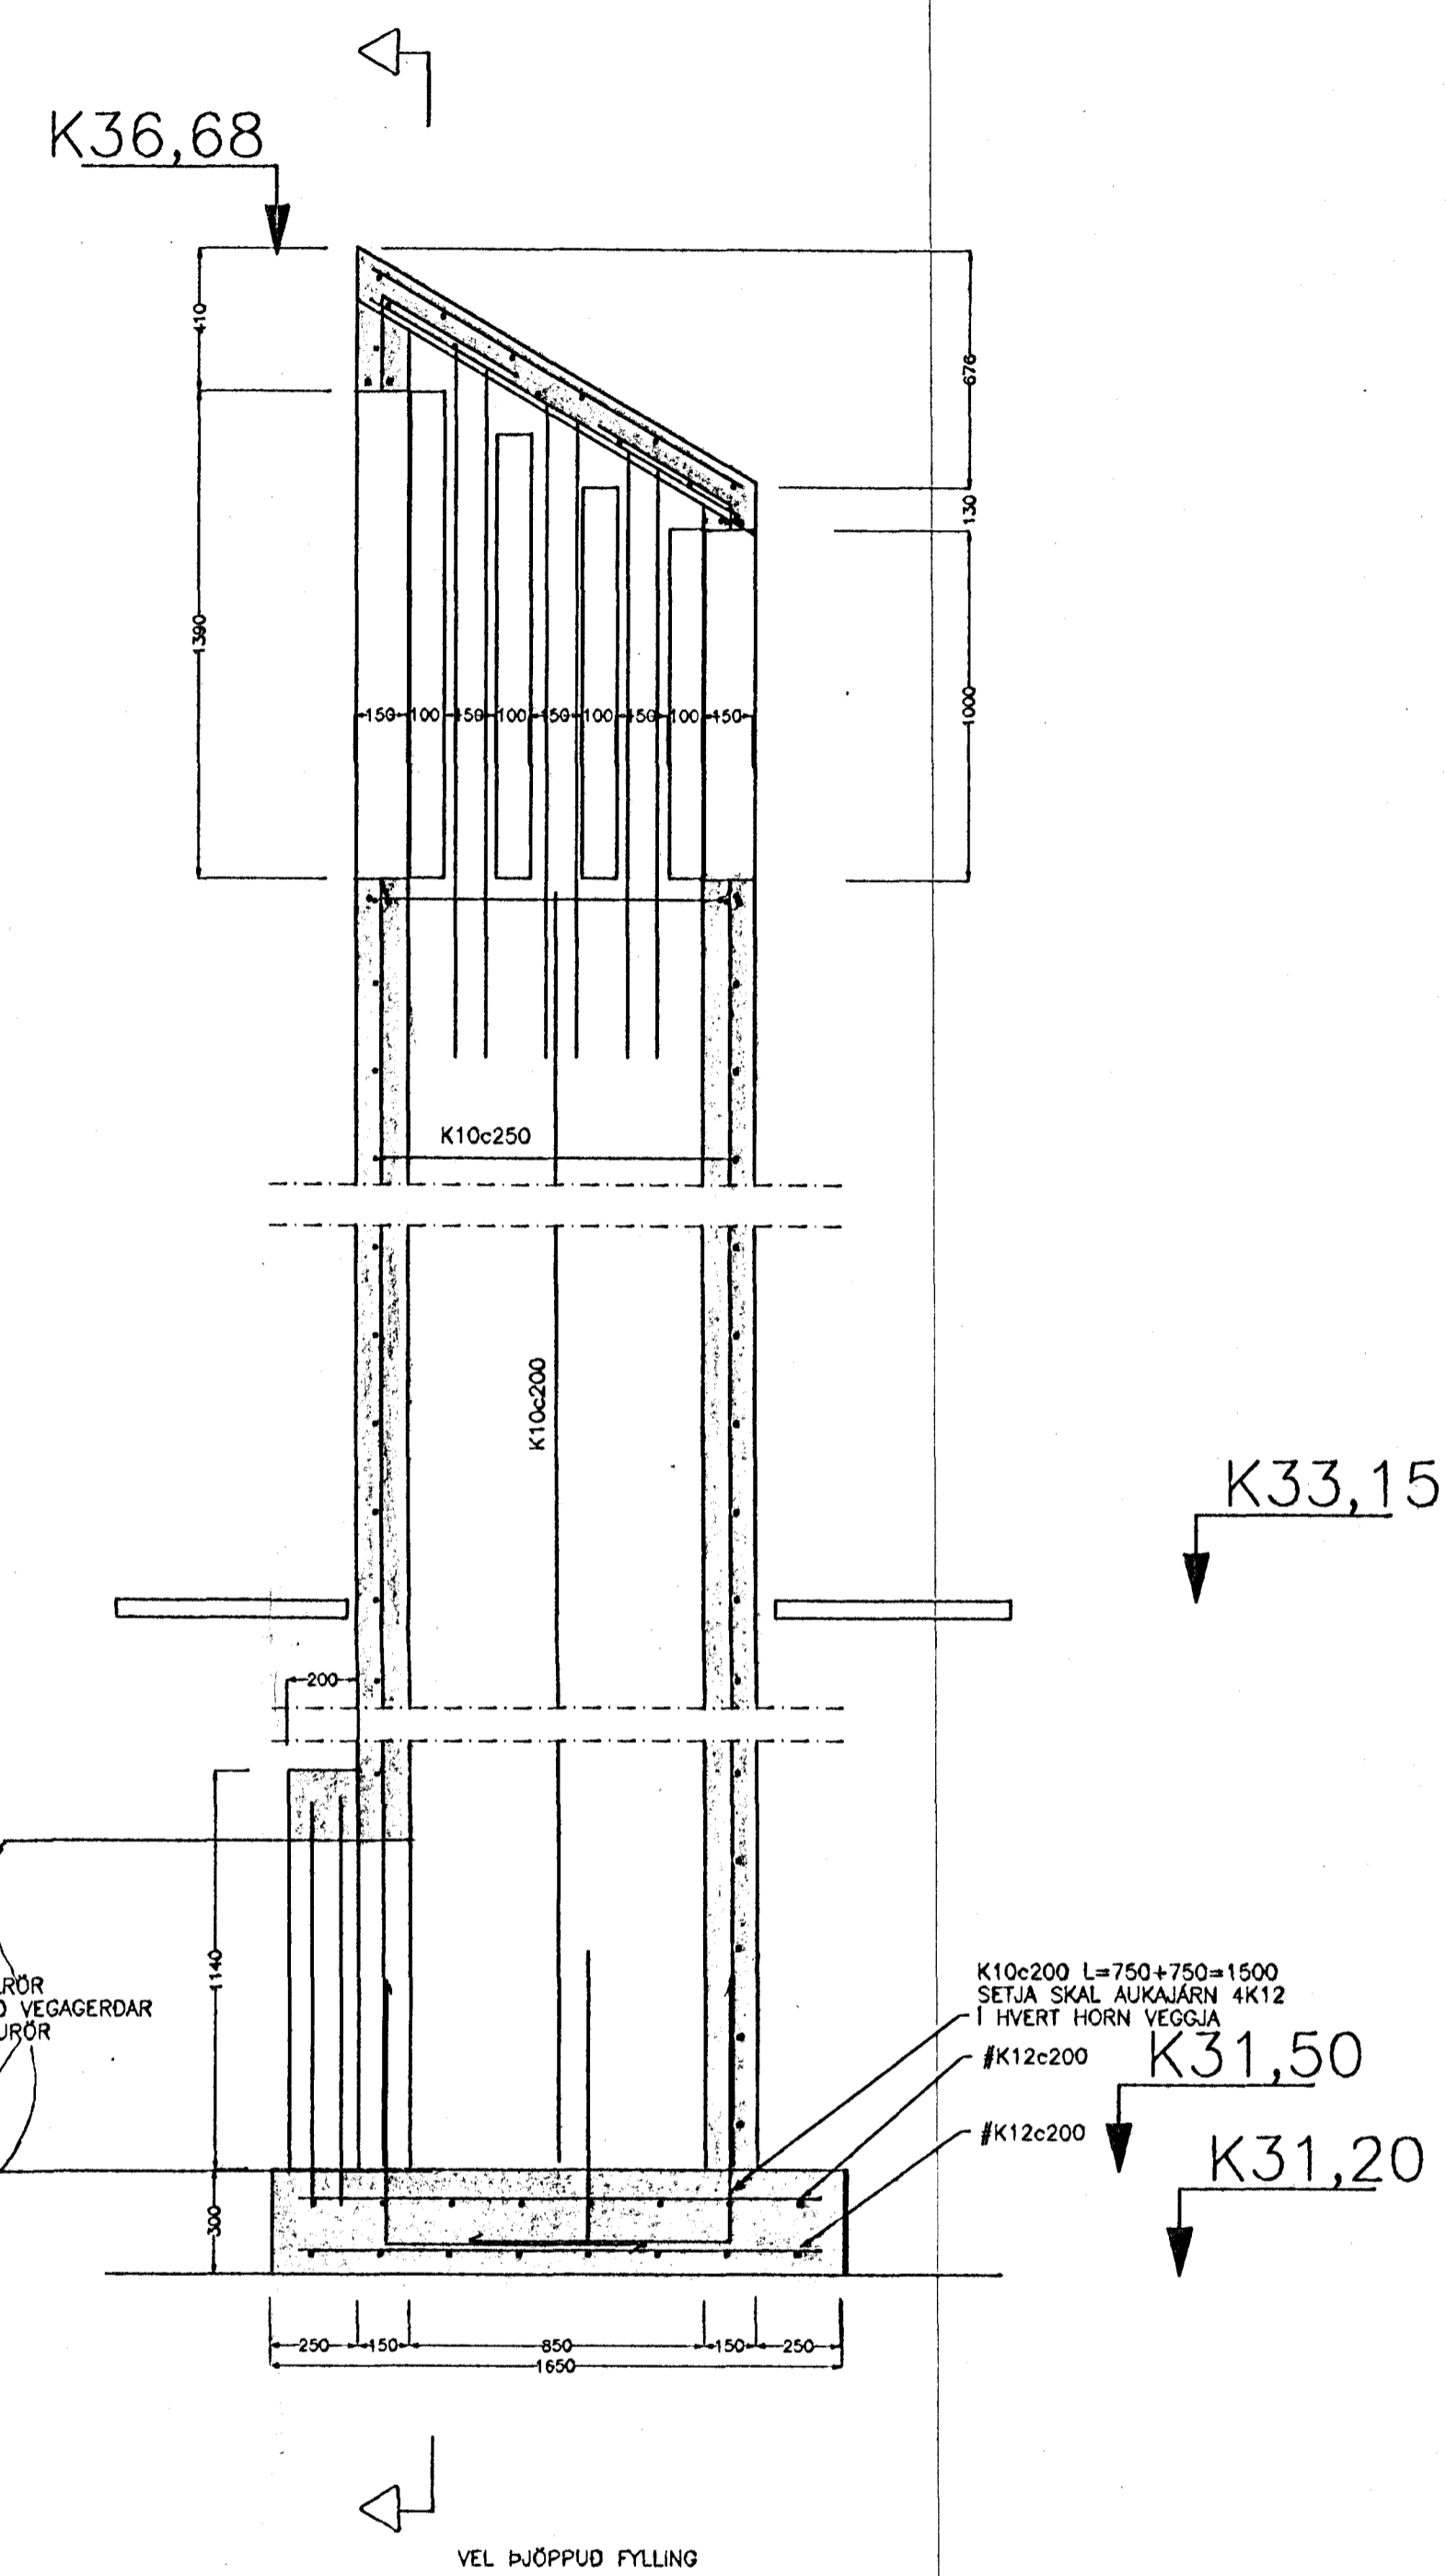


U26
105 121 SNID

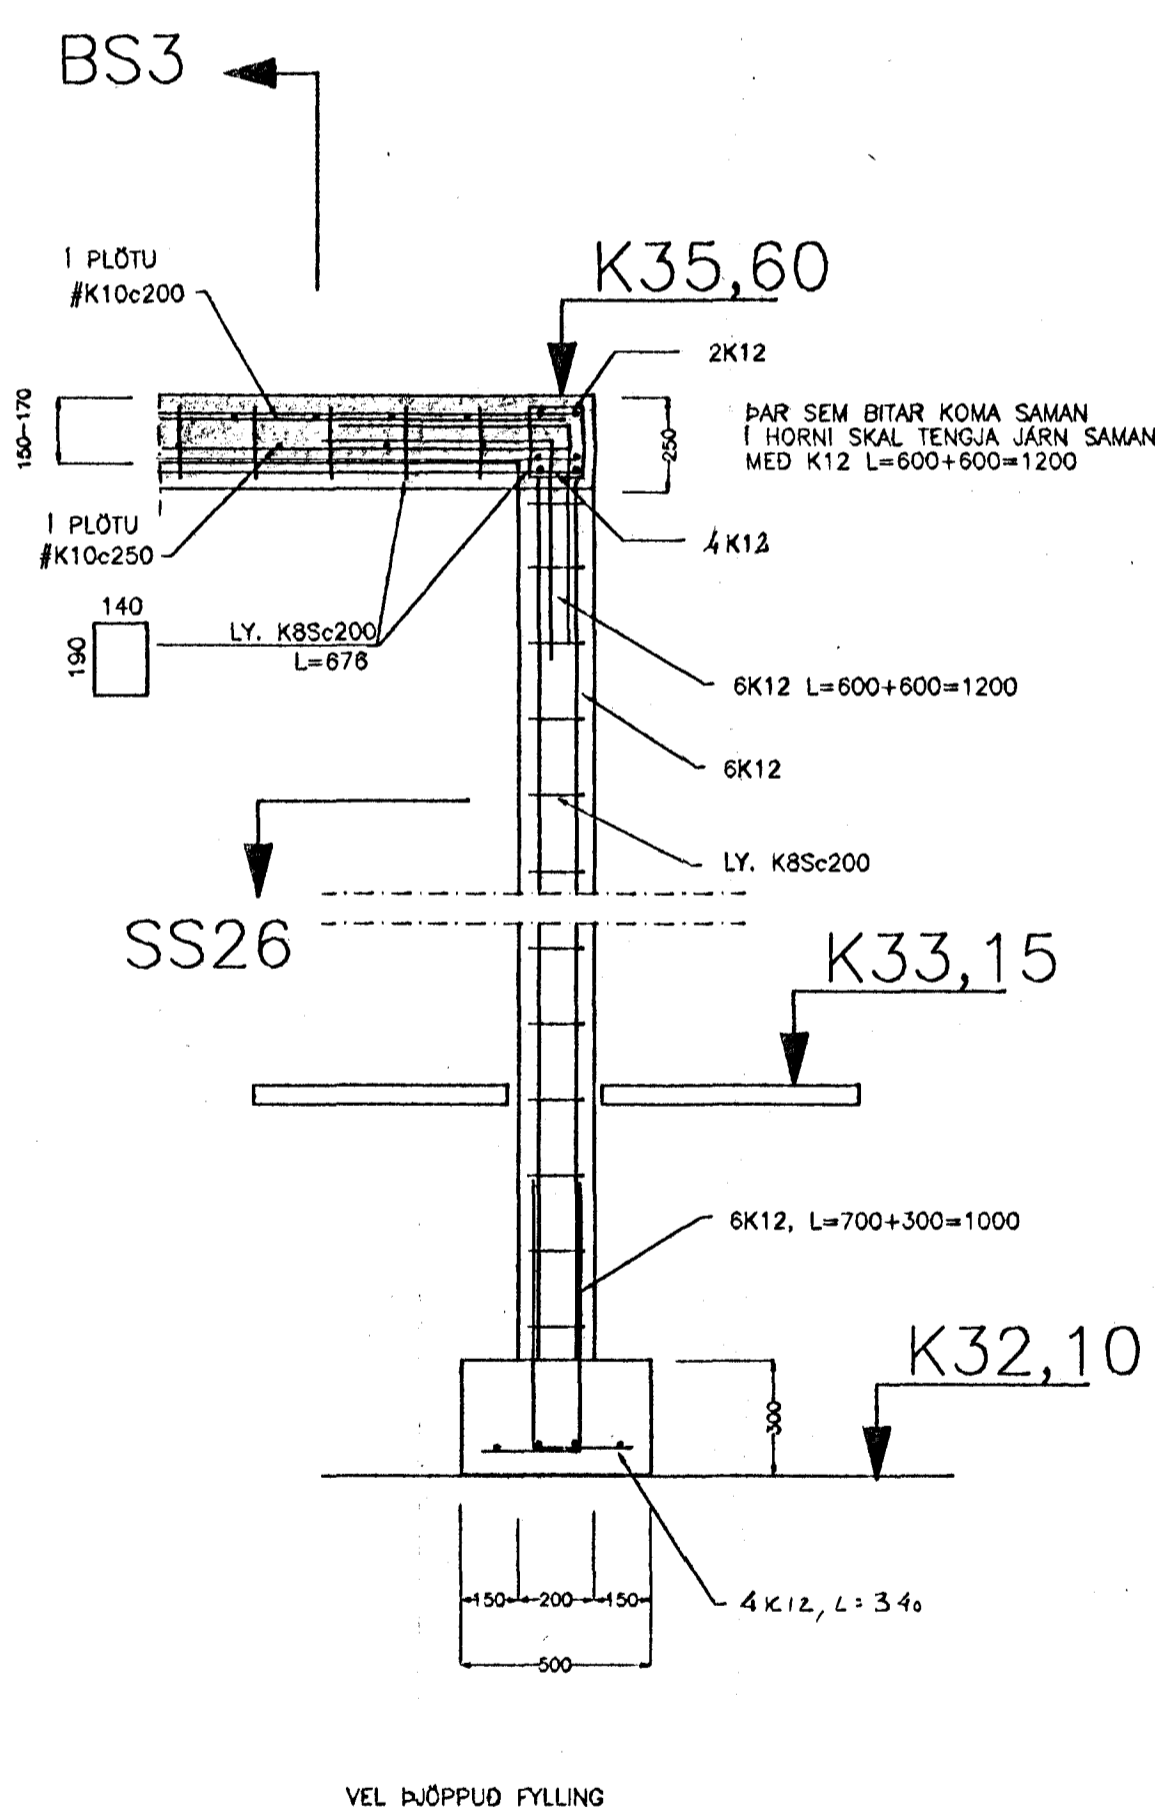

SS26
105 121 SNID

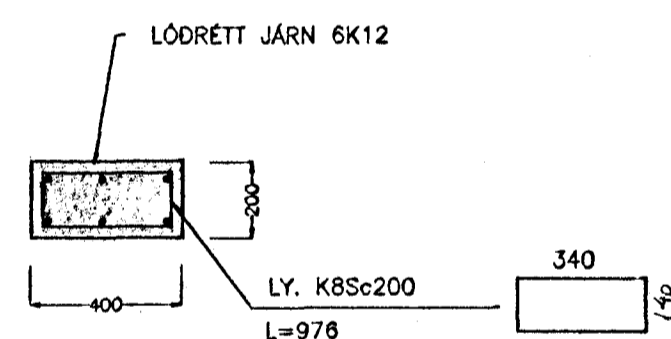

TILVÍSUN:
Teikning nr. 100, alm. skýringar.
Teikningar nr. 101 til 117
Teikning nr. 121

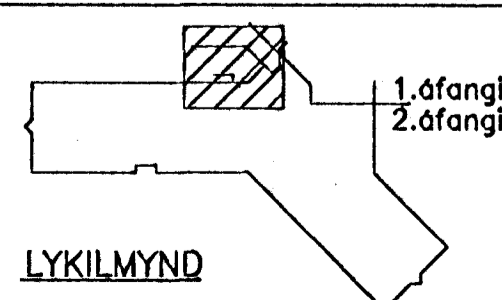

I			
H			
G			
F			
E			
D			
C			
B			
A	10-3-94	BS3, 4K12 í önd 2. áfangi	EE
DAGS.	BREYTING		SAMP.

HVALEYRARSKÓLI
HAFNARFIRÐI, 2. áfangi.
ALVERKTAKI:
FRÍÐJÓN OG VIDAR H.F.

EINAR EINARSSON TÆKNIFRÆÐINGUR, BREIÐVANGUR 6
kennitala 1610504769, sími 660788
TEIKN.NR. 133 A
BITAR OG SÚLUR
SNID,
M.K.V. 1:20
DAGS. feb.1994
SAMP. Einar Einarsson

ÁSKILIÐ, ELÐRI
TEIKNING OGILD

