


ÁSKILIÐ, ELÐRI
TEIKNING ÓGILD

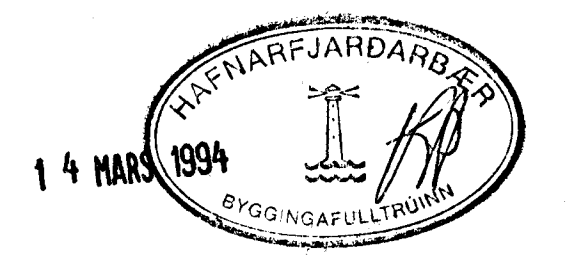

| | | |
|-------|----------|------------------|
| I | | |
| H | | |
| G | | |
| F | | |
| D | | |
| C | | |
| B | 6.3.74 | U8, U9, U10 |
| A | 25.1.74 | A8, A9, E1-BOLTA |
| DAGS. | BREYTING | SAMP. |

HVALEYRARRSKÓLI
HAFNARFIRÐI, 2.áfangi.
ALVERKTAKI:
FRÍDJÓN OG VIÐAR H.F.

EINAR EINARSSON TEKNIPRÆDINGUR, BREIDVANGUR 8
kennitala 1510504789, sími 650788
TEKJ.NR. 111 B
UNDIRSTÖÐUR U8, U9, U10
SNID
HANNAD EE
TEKJAD EE
YFIRF.
MXY. 1:20
DAGS. JAN.1994
SAMP. Einar Einarsson