
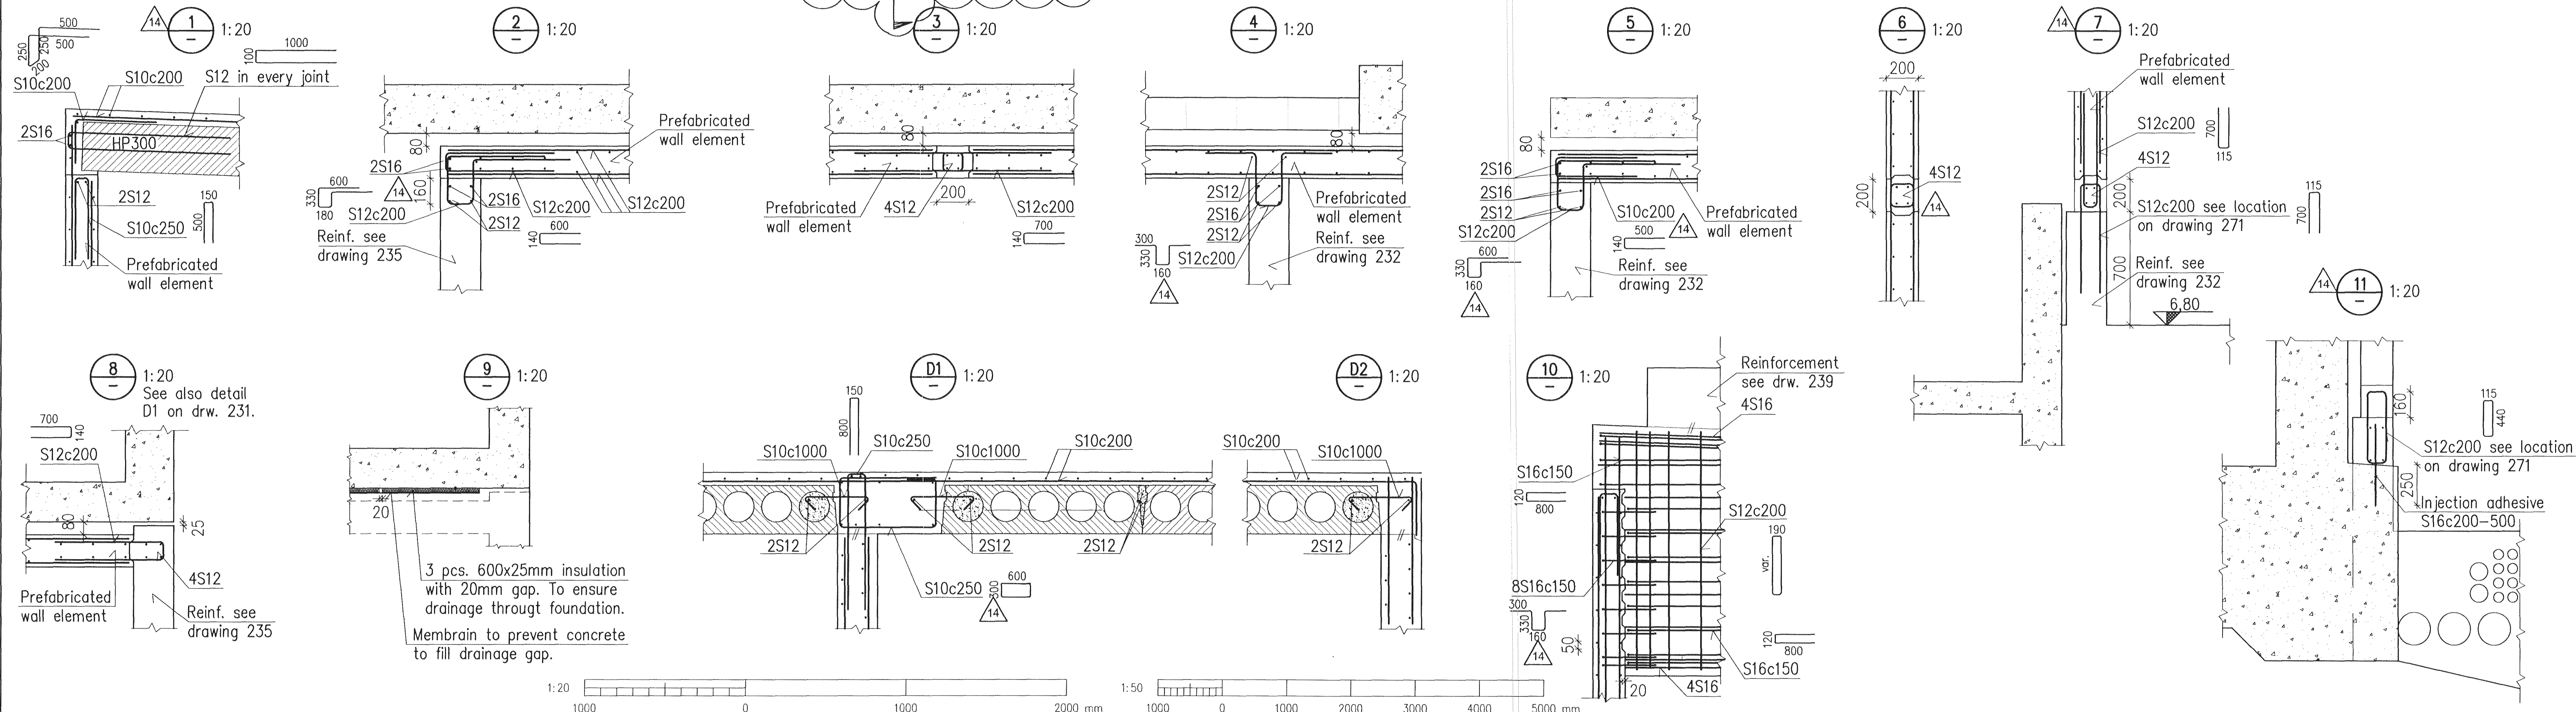


Núli Indriðason
 81 656441-3545

A 231 1:50

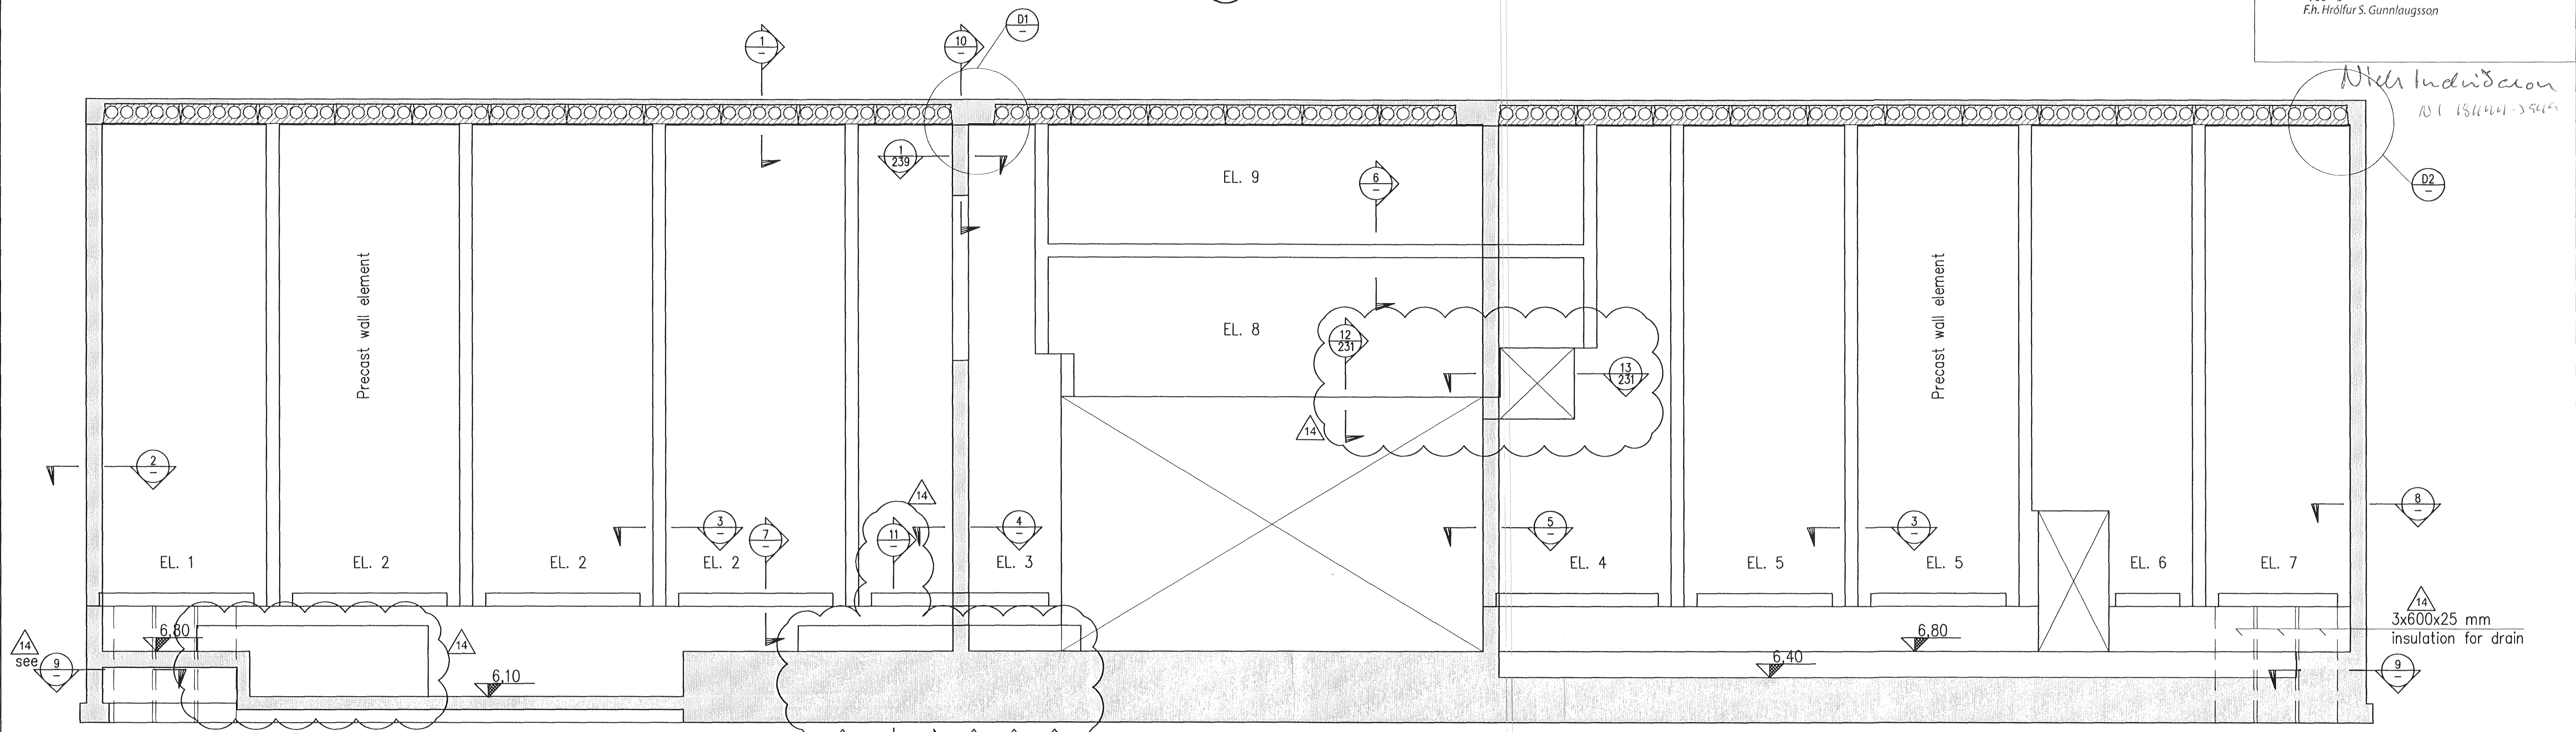

Skýringar:
 Legend:
 Precast wall elements see drawings 271-275.
 Location of stirrups connecting precast element are shown on drawing 271.

Fig. nr / Rev. no.	Þýðing / Description	Dagsetning / Date	Man/Þka / Des/Þra	HRV / Dkt	Notk. ísm / Sigl. ísm	Notk. ísm / Sigl. ísm
14	Section 11 and section marking 12, 13 added, sections and D1 changed	11.03.03	HS/LDB	NI	ÓS	
13	Section marking, section 10	11.01.18	HS/LDB	NI	ÓS	
12	General revision	10.12.22	HS/LDB	NI	ÓS	
11	Issued for construction	10.05.06	HS/LDB	NI	ÓS	

This drawing is the property of Rio Tinto Alcan Iceland Ltd. and handed out for personal use only. It may neither be copied nor made available to others without permission of Rio Tinto Alcan Iceland Ltd. The receiver is liable for any misuse.

Starf: A1 Mkv.: 1:20, 1:50
 Dimensions without tolerances according to ISO 2768-1 medium.

HRV ENGINEERING

Dagsetning / Date	2008.10.01
Manað / Designed	HS
Teikn / Drawn	LDB
Verktaki / Supplier	HRV
Tekn. nr. verktaka / Supplier drw. no.	IDP-410-CA-015-233
Samþykkt / Approved	NI
HRV / Chkd	NI
HRV / Part of:	

IDP410-RECTIFIER BUILDINGS	Flokkur nr.: / Blað nr.:	Nasta bl. nr.:
A5/S1	4011	
WALLS SIDE VIEW 1/3, DETAILS & SECTION	Kostna. nr. - Ccno. / Búnr. - Eqno	
REINFORCEMENT	AKS	
Rio Tinto Alcan	Tekn. nr. ISAL / Drw. no. of ISAL	Breyt./Rev.:
	IS-222 Hafnarfjarður Ísland	C
	ISAL Yfirforð og skilá, dags / ISAL Checked, date	ISAL Samþykkt, dags / ISAL Approved, date