


Samþykkt þann
 05 APR 2011
 Byggingarútlitunni í Hafnarfirði
 F.h. Hrófur S. Gunnlaugsson

Níels Indriðason
 Ní 13044-3144

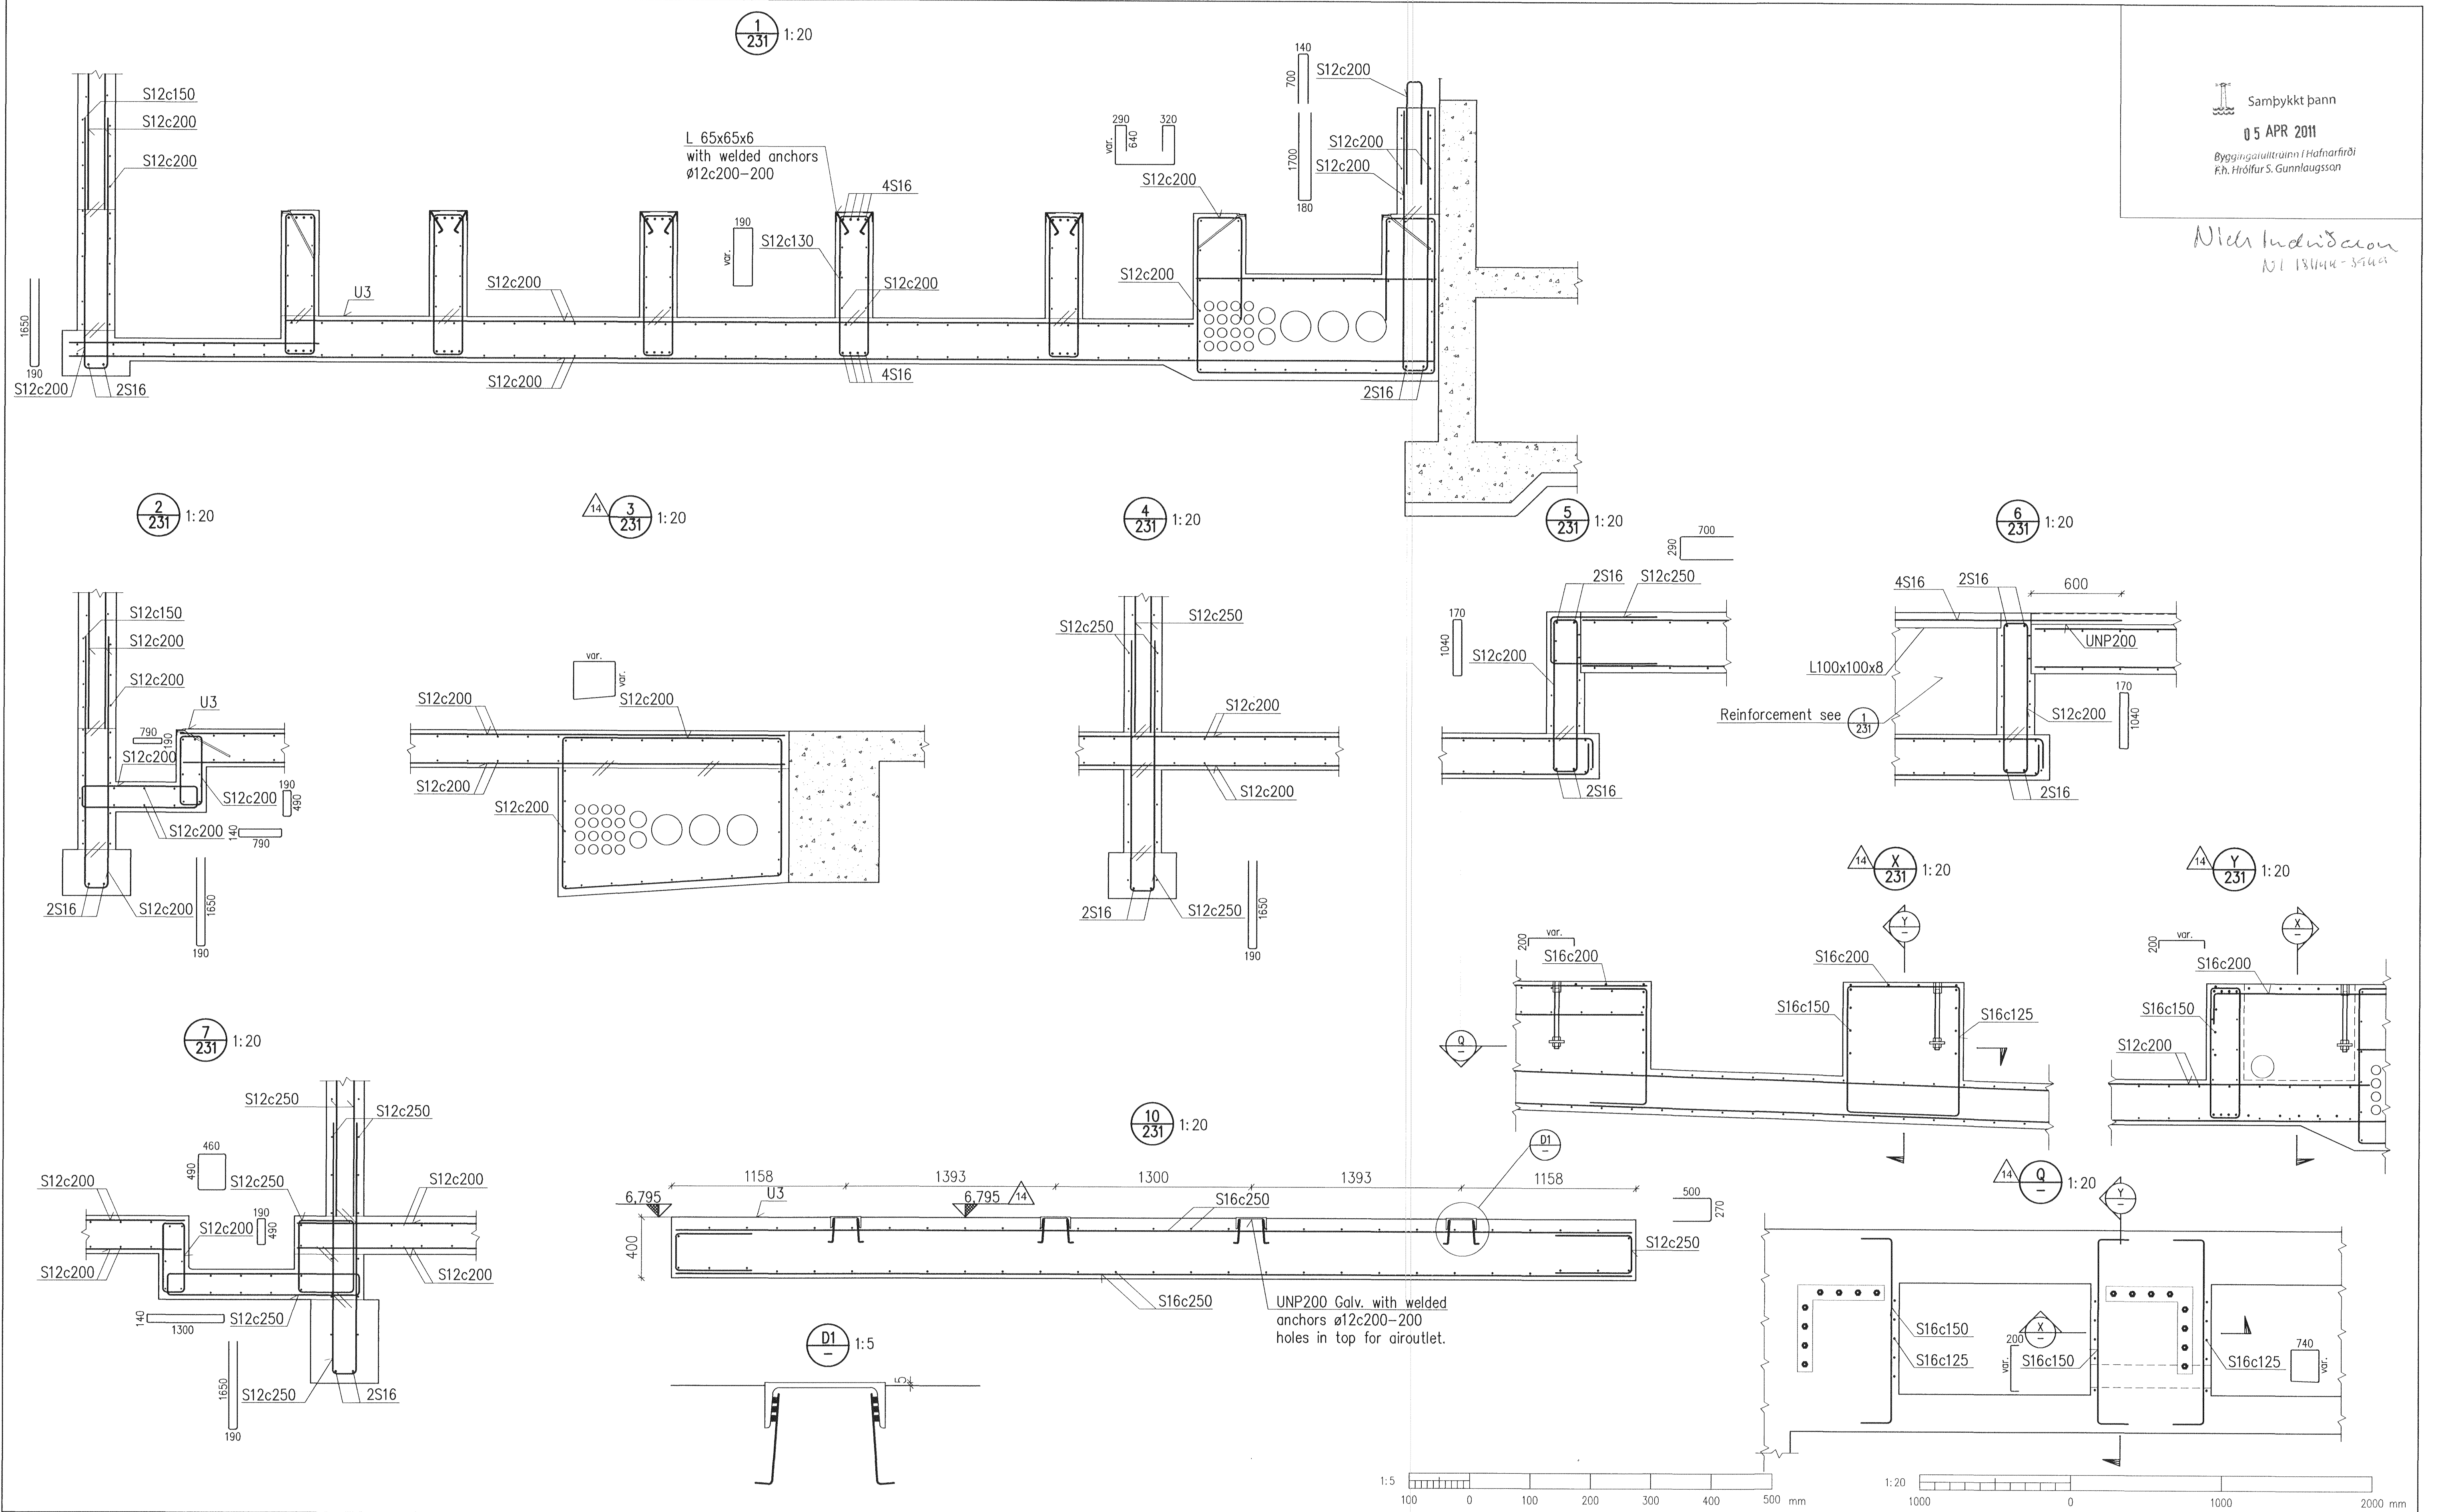

Skýringar: Legend:				This drawing is the property of Rio Tinto Alcan Iceland Ltd. and handed out for personal use only. It may neither be copied nor made available to others without permission of Rio Tinto Alcan Iceland Ltd. The receiver is liable for any misuse. Starð: A1 Mkv: 1:5, 1:20 Formst: Scale: Dimensions without tolerances according to ISO 2768-1 medium.		Dagssetning / Date: 2008.10.01 Hönnað / Designed: HS Tökn / Drawn: LDB Verktaki / Supplier: HRV Töknunarklaða / Supplier drwno: IDP-410-CA-015-232 Samþykkt / Approved: NI Hluti af: / Part of:		IDP410-RECTIFIER BUILDINGS A5/S1 SECTIONS REINFORCEMENT RioTintoAlcan ISAL Yfirbú og skráð, dags / ISAL Checked, date ISAL Samþykkt, dags / ISAL Approved, date		Flakur nr.: Blað nr.: Kostn.nr.-Ceno. / Búnr.-Eqno 4011 AKS ISAL Töknun. ISAL /Drwno. of ISAL Breyt./Rev. Alcan Iceland Ltd. Straumsvík IS-222 Hafnarfordur Ísland C	
Þlg nr	Lýsing	Dagssetning	Hor./Hn	Yfir	Netk	Netk	Netk				
Rev no	Description	Date	Des/Drw	Ord	hain	hain	hain				
14	Sections X, Y and Q added, section 3 changed	11.03.03	HS/LDB	NI	OS						
13	Sections 1, 3 and 7 changed	10.12.22	HS/LDB	NI	OS						
12	General revision	10.09.30	HS/LDB	NI	OS						
11	Issued for construction	10.05.06	HS/LDB	NI	OS						