Samþykkt þann
05 APR 2011
Byggingafulltrúinn í Hafnarfirði
F.h. Hrólfur S. Gunnlaugsson

Nich Indríðason
NI 131144-3944

C 224 SECTION

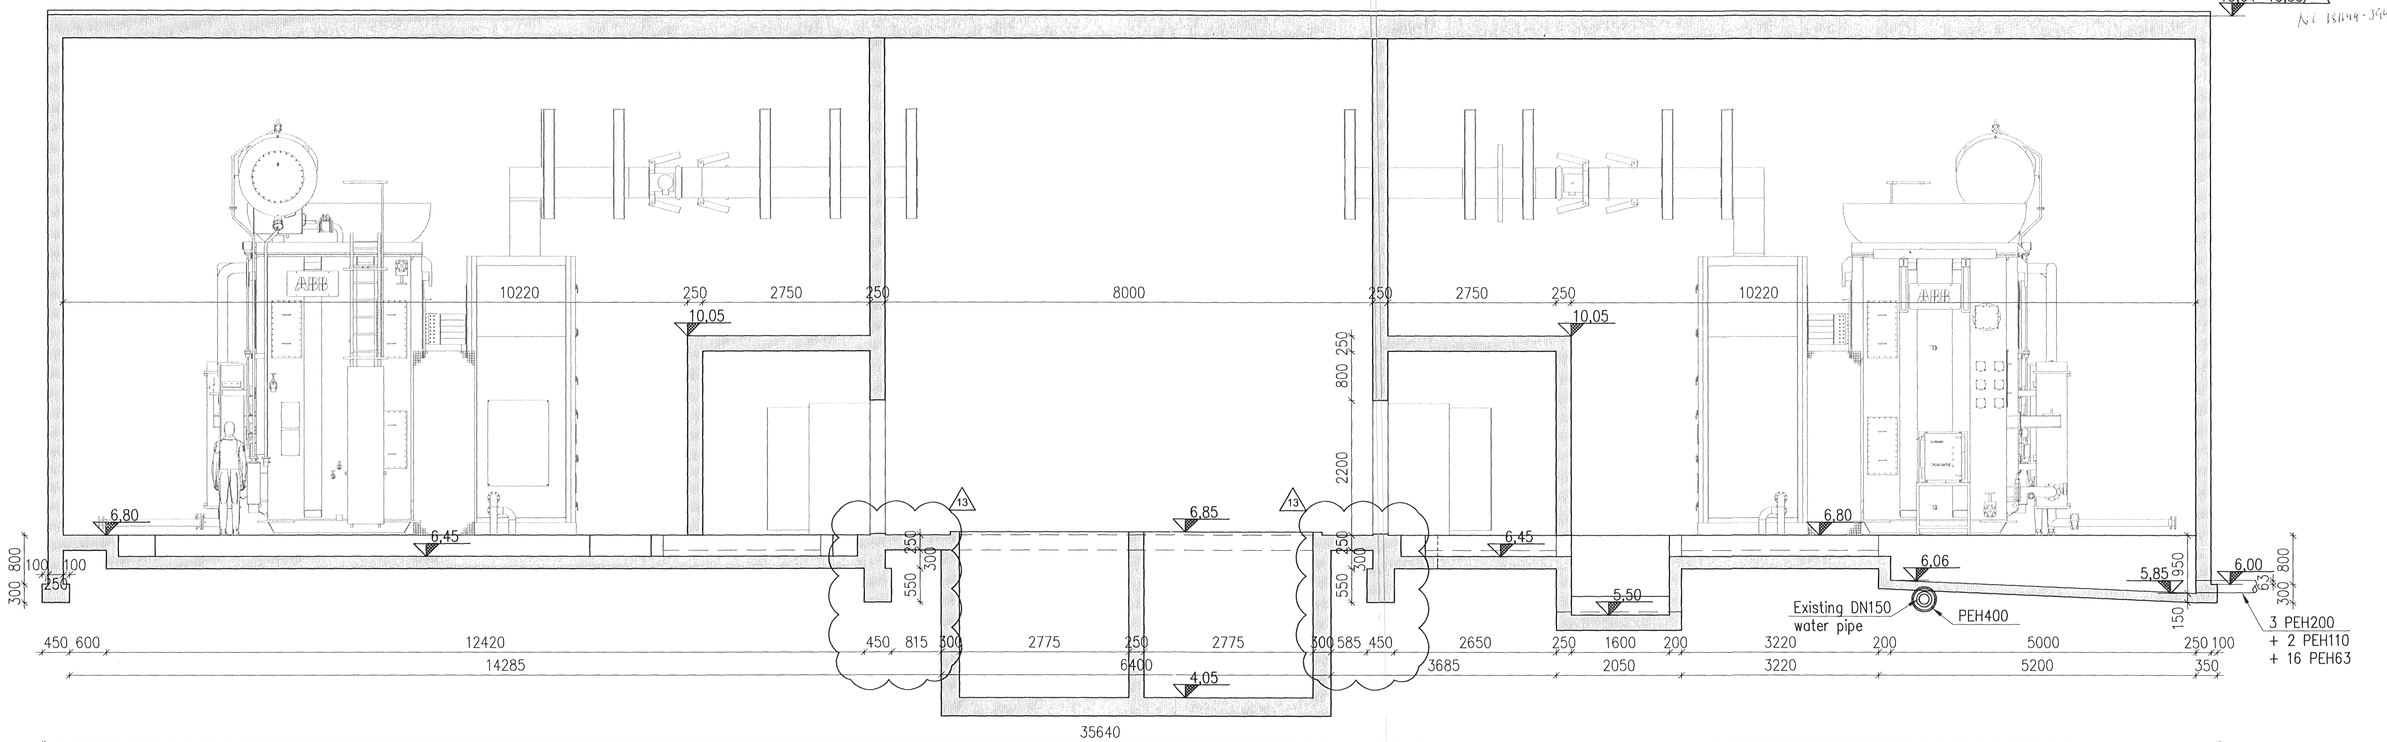

D 224 SECTION

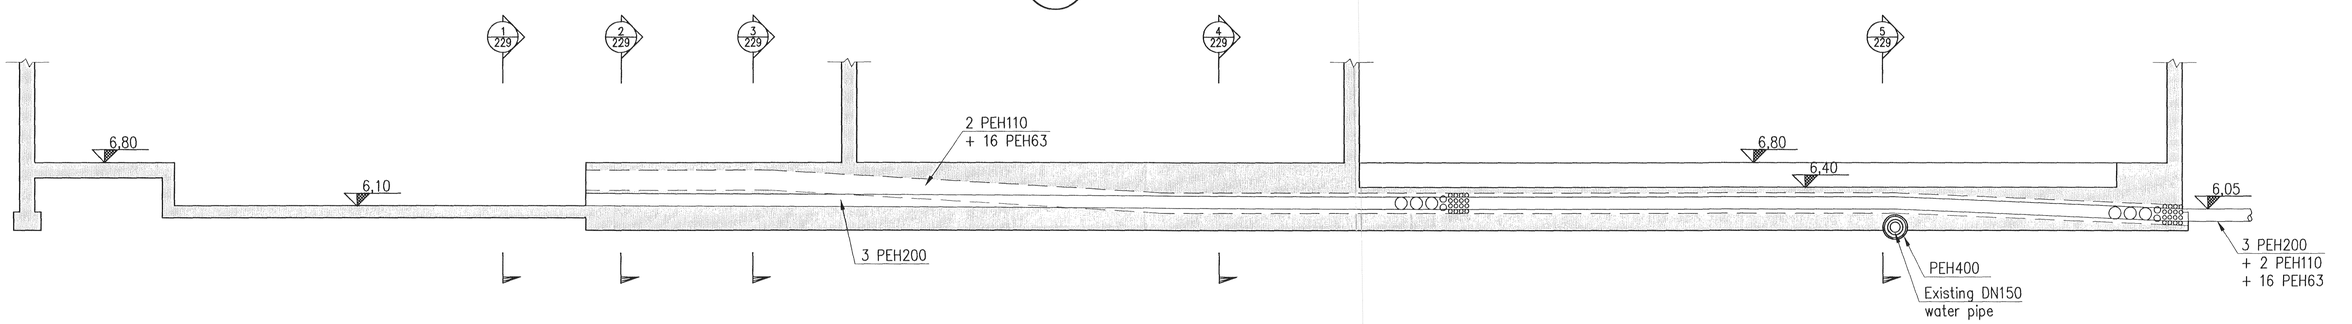

1:50 1000 0 1000 2000 3000 4000 5000 mm

Skýringar:
Legend:

Útg nr Rev no	Lýsing Description	Dagsetning Date	Han/Tkn Des/Drw	Yfirf Ckd	Notk heim Suppl Rel	Notk heim ISAL Rel
13	Foundation added, elevation text changed	11.03.03	HS/LDB	NI	ÓS	
12	General revision	10.12.22	HS/LDB	NI	ÓS	
11	Issued for construction	10.05.06	HS/LDB	NI	ÓS	

This drawing is the property of Rio Tinto Alcan Iceland Ltd. and handed out for personal use only. It may neither be copied nor made available to others without permission of Rio Tinto Alcan Iceland Ltd. The receiver is liable for any misuse.

Stærð: Format: A1 Mkv.: Scale: 1:50
Dimensions without tolerances according to ISO 2768-1 medium.

HRV ENGINEERING

Dagsetning / Date: 2009.01.22
Hannað / Designed: HS
Teikn / Drawn: LDB
Verktaki / Supplier: HRV
Teikn.nr.verktaka / Supplier drw.no.: IDP-410-CA-015-228
Samþykkt / Approved: NI
Yfirf / Chkd: NI
Hluti af: / Part of:

IDP410-RECTIFIER BUILDINGS
A5/S1
SECTIONS C AND D

Teg.teikningar / Dwg. type: FORM WORK

Rio Tinto Alcan
ISAL
Alcan Iceland Ltd
Straumsvik
IS-222 Hafnarfjordur
Iceland

ISAL Yfirfarið og skráð, dags / ISAL Checked, date
ISAL Samþykkt, dags / ISAL Approval, date

Flokkur nr.: Blað nr.: Næsta bl.nr.:
Kostn.nr.-Ccno. / Bún.nr.-Eq.no: 4011
AKS
Teikn.nr. ISAL /Drw.no. of ISAL
Breyt./Rev.: C

C:\IDP\01 IDP\400 – Reduction\410 Substation\Drawings\Civil\IDP-410-CA-015-228.dwg