



A SECTION, 1:50
224

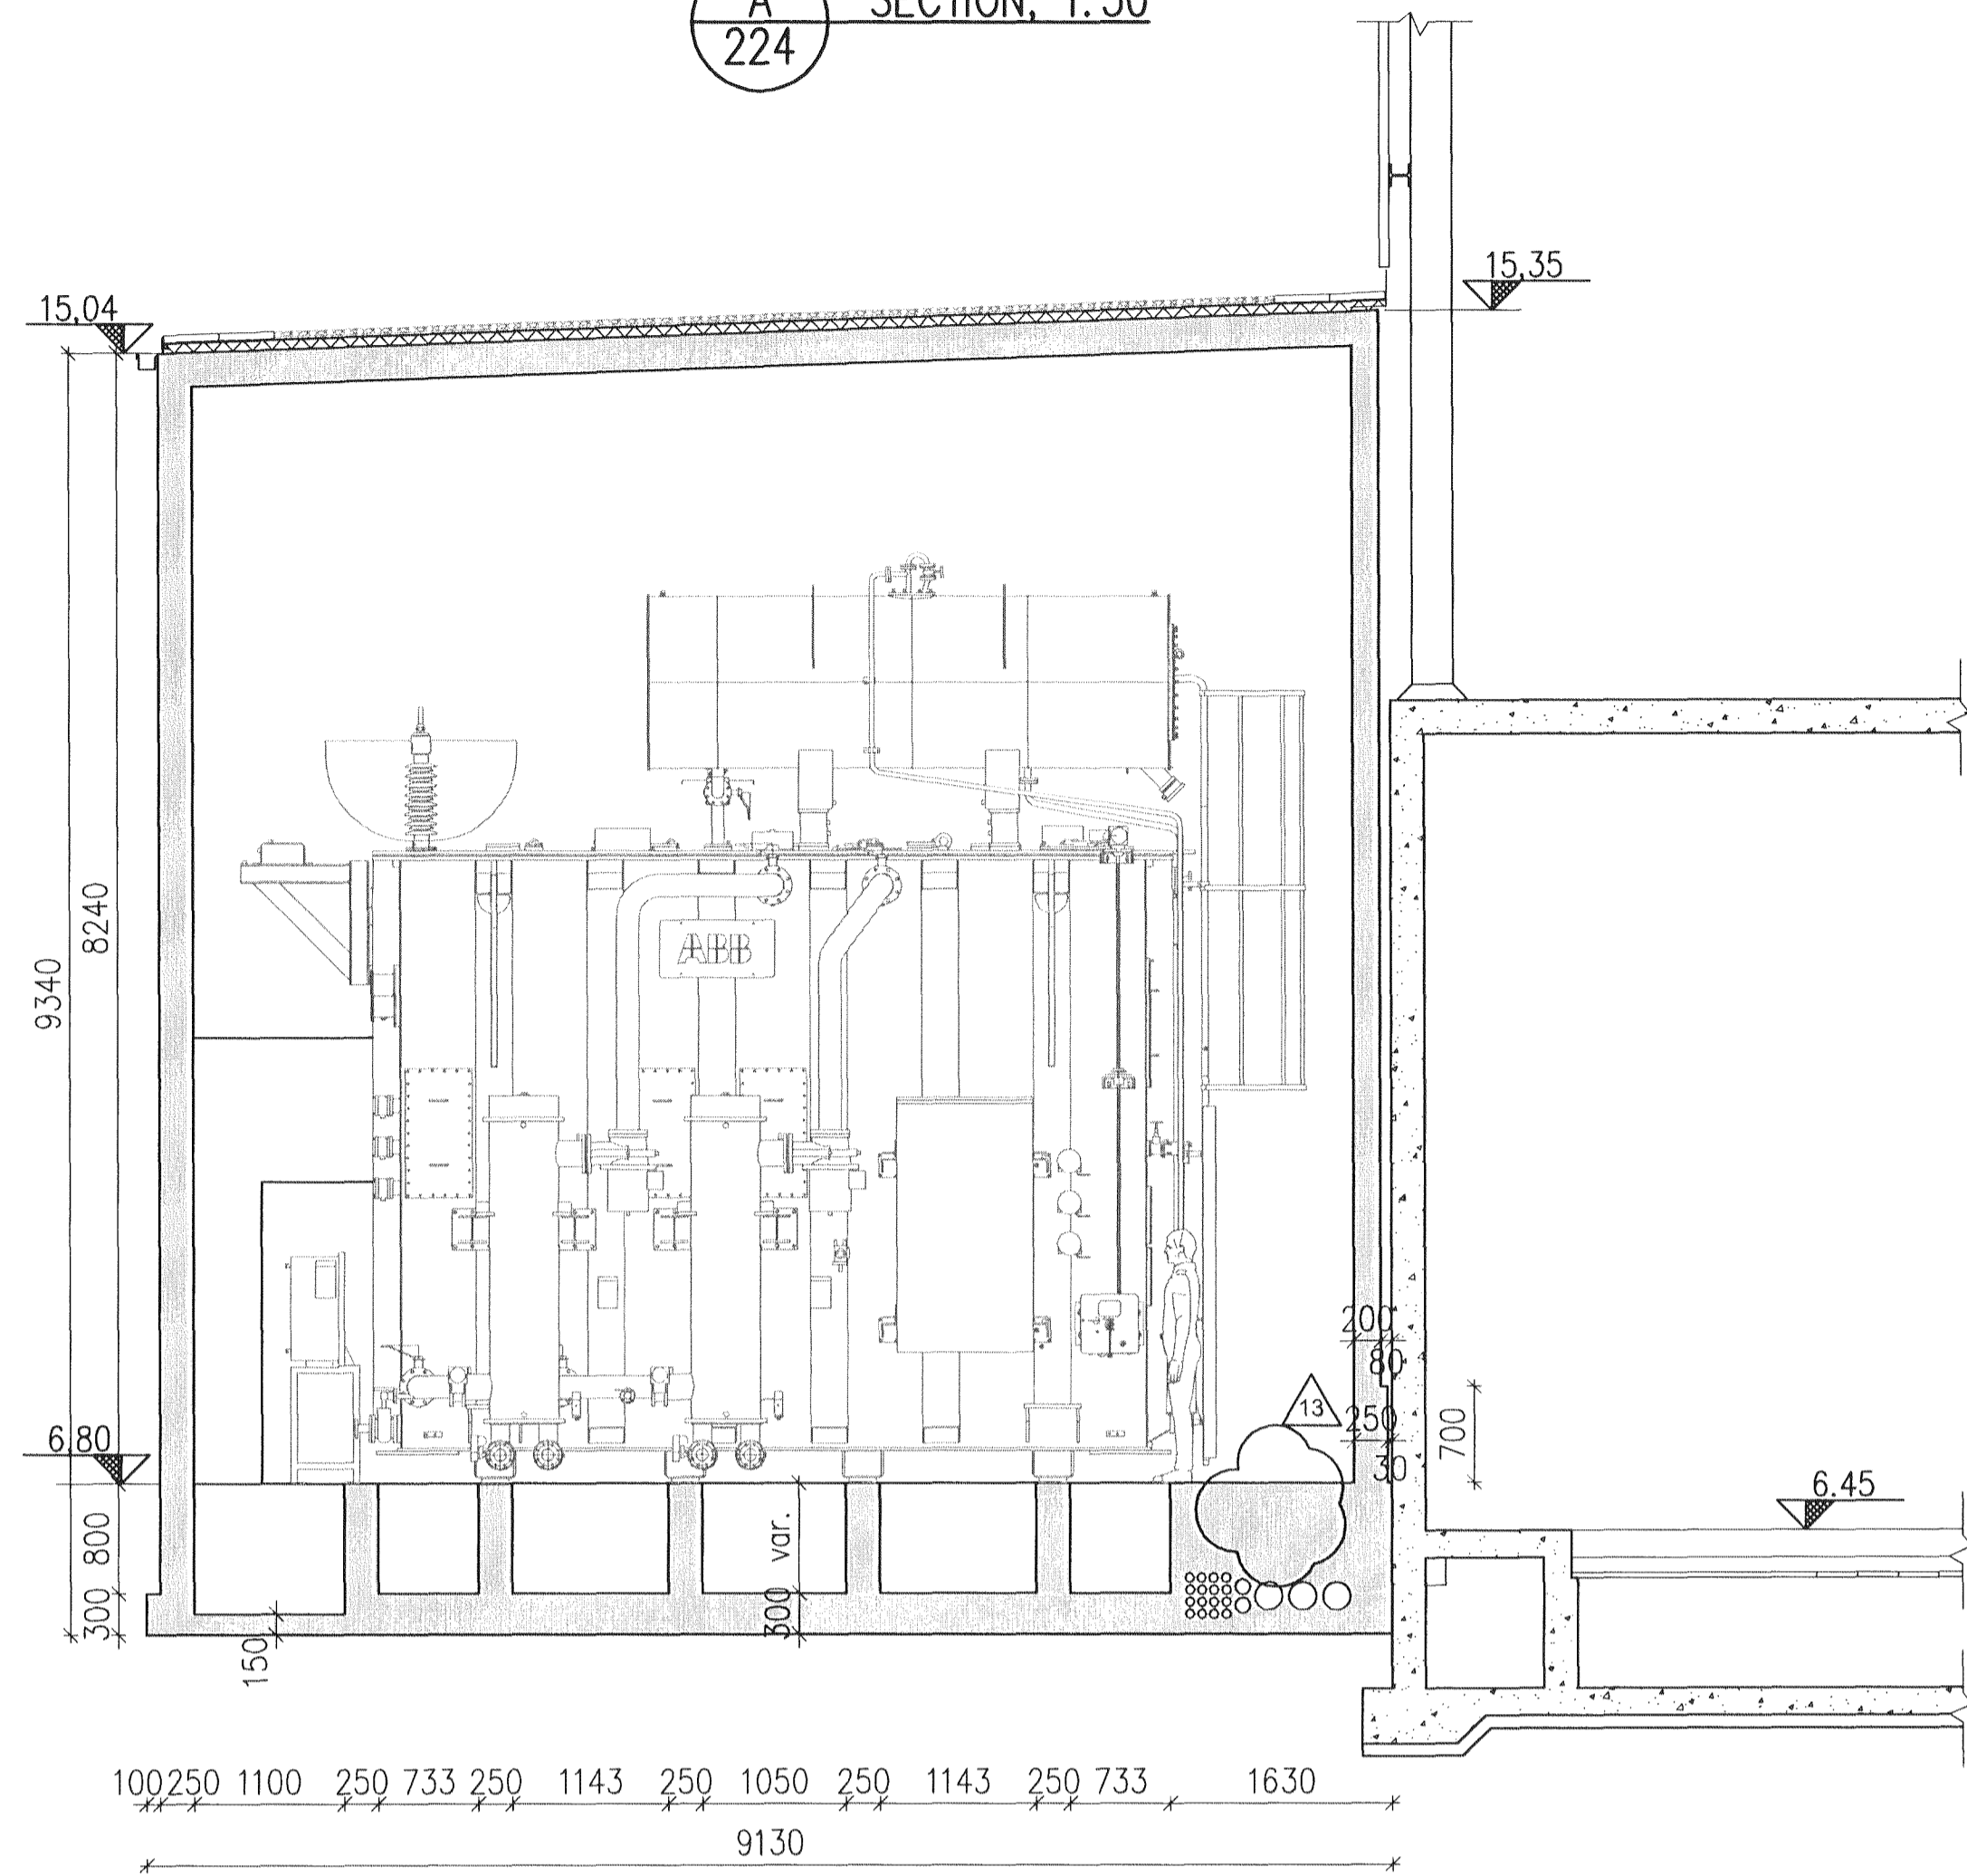



B SECTION, 1:50
224

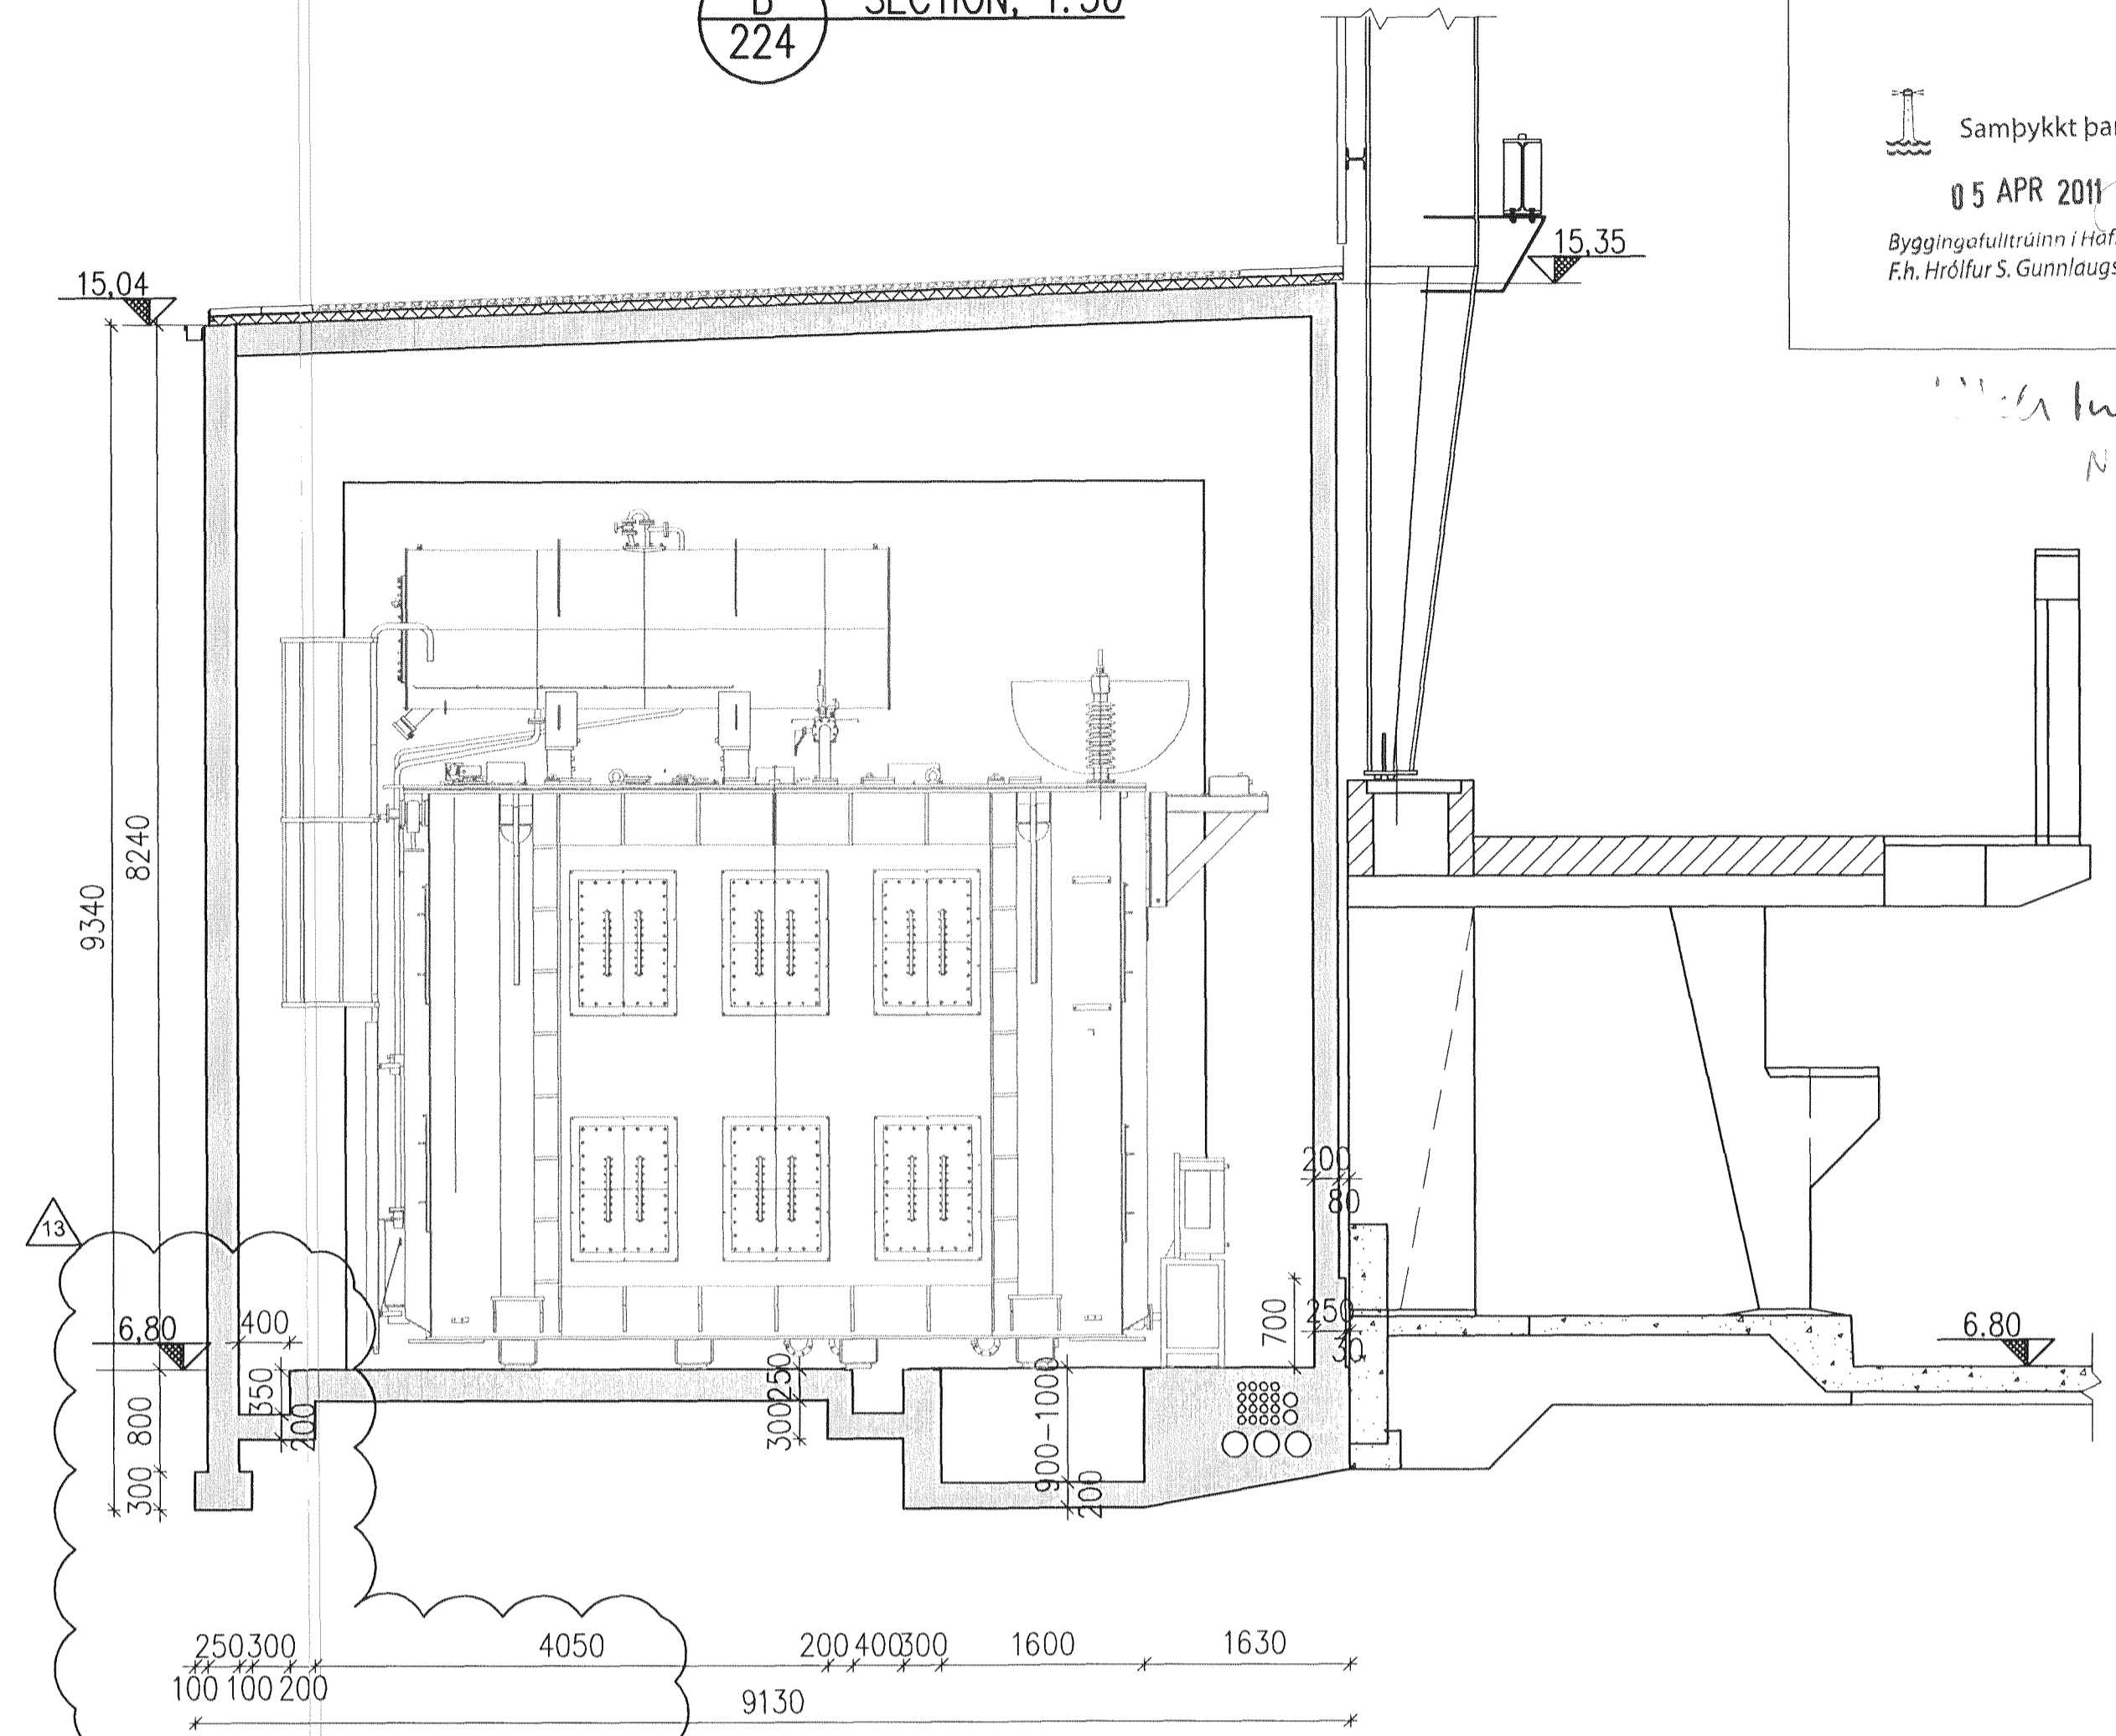

Samþykkt þann
05 APR 2011
Byggingefulltrúinn í Háfrarfróð
F.h. Hrólfur S. Gunnlaugsson

Ólafur Indriðason
N1 181144-3949


E SECTION, 1:20
224

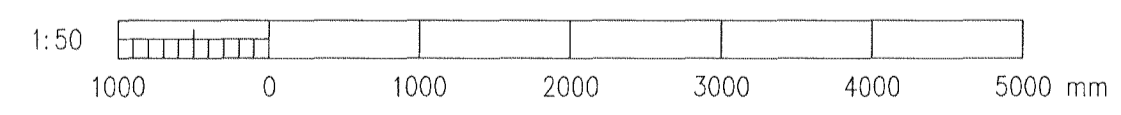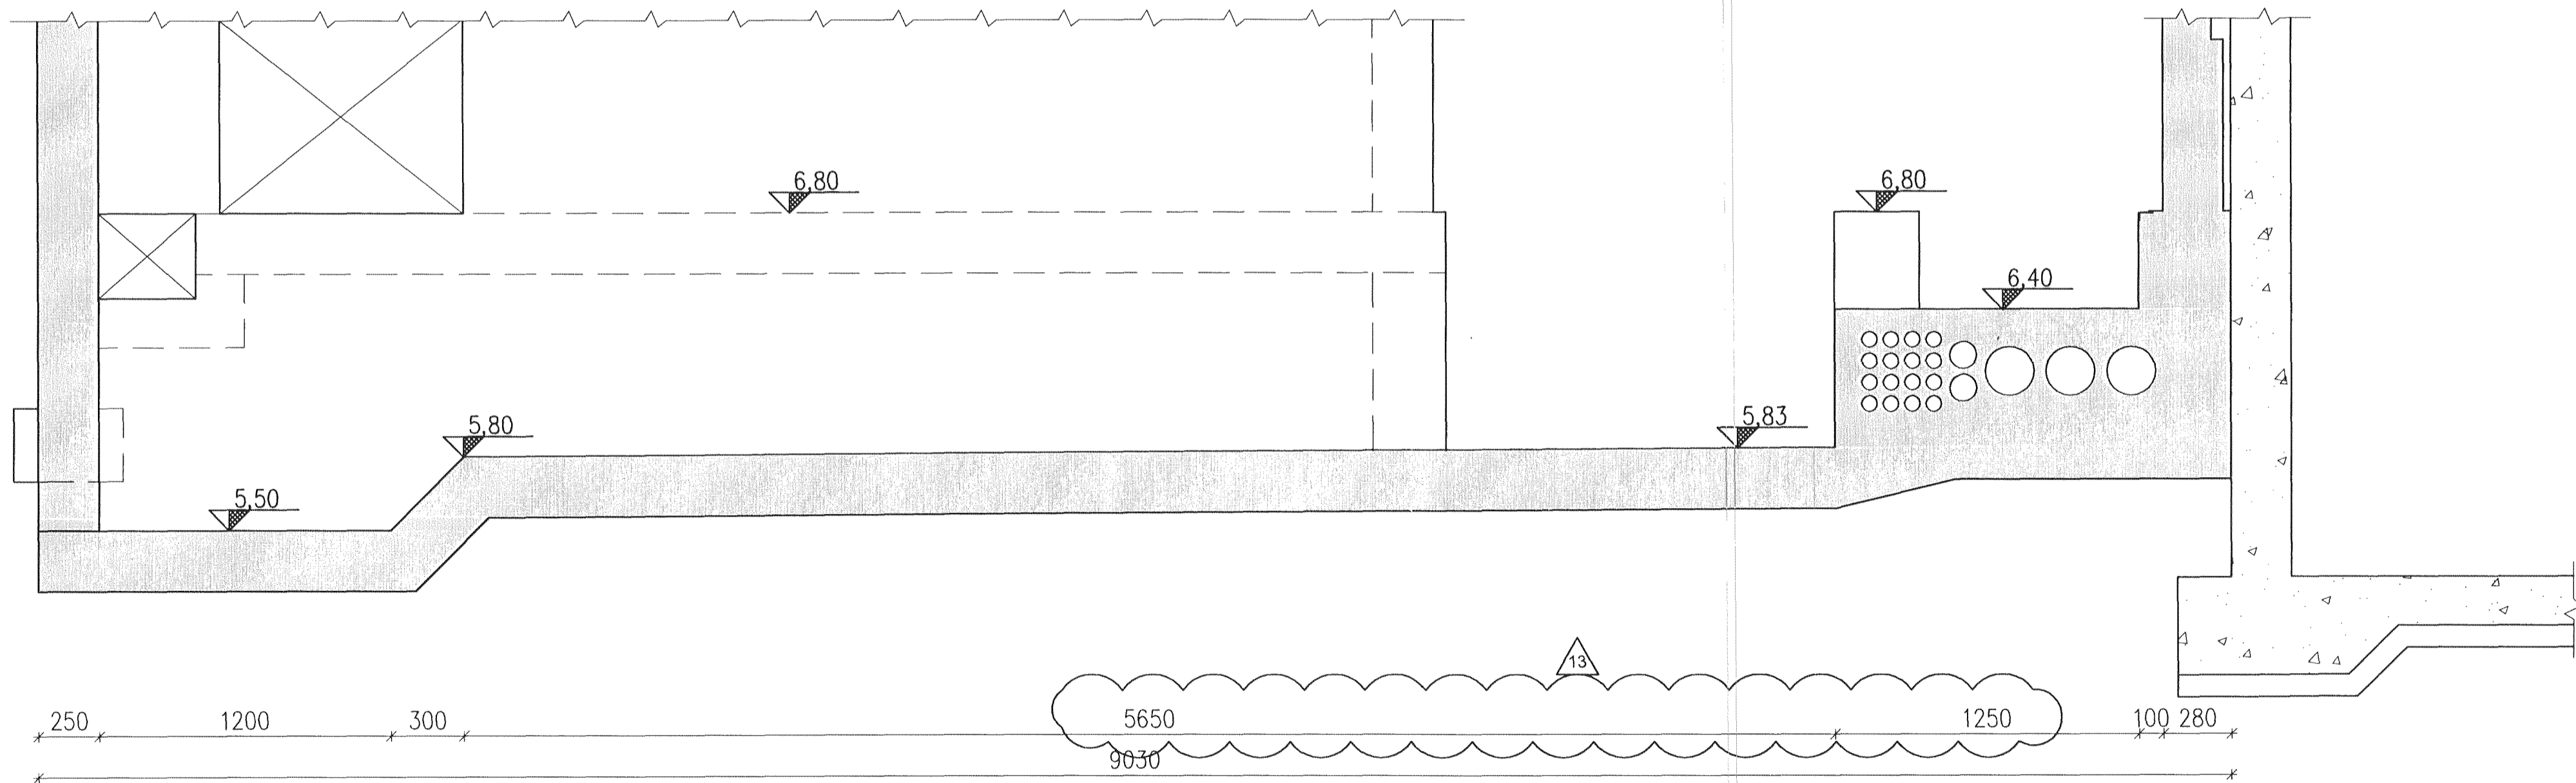

Skýringar:
Legend:

Útg nr / Rev no	Lýsing / Description	Dagsetning / Date	Hor / Rn / Des / Drw	Yfir / Chkd	Notk heim / Suppl Rel	Notk heim / ISAL Rel	Stærð / Format: A1	Mkv. / Scale: 1:20, 1:50
13	Minor revisions	11.01.18	HS/LDB	NI	ÓS			
12	General revision	10.12.22	HS/LDB	NI	ÓS			
11	Issued for construction	10.05.06	HS/LDB	NI	ÓS			

This drawing is the property of Rio Tinto Alcan Iceland Ltd. and handed out for personal use only. It may neither be copied nor made available to others without permission of Rio Tinto Alcan Iceland Ltd. The receiver is liable for any misuse.

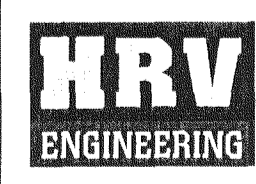

Dagsetning / Date: 2009.01.22
 Teknab / Drawn: LDB
 Hamnað / Designed: HS
 Yfir / Chkd: NI
 Verktaki / Supplier: HRV
 Tekn.nr.verktaka / Supplier drw.no: IDP-410-CA-015-227
 Samþykkt / Approved: NI
 Flúti af / Part of:

IDP410-RECTIFIER BUILDINGS
 A5/S1
 SECTIONS A, B and E
 Form Work
 Rio Tinto Alcan
 ISAL Tífróð og skráð, dags / ISAL Checked, date
 ISAL Samþykkt, dags / ISAL Approval, date