



Samþykkt þann
 05 APR 2011
 Byggingaráttvæðing í Hafnarfirði
 F.h. Hrólfur S. Gunnlaugsson

Neli Indriðason
 N1 13144-3948

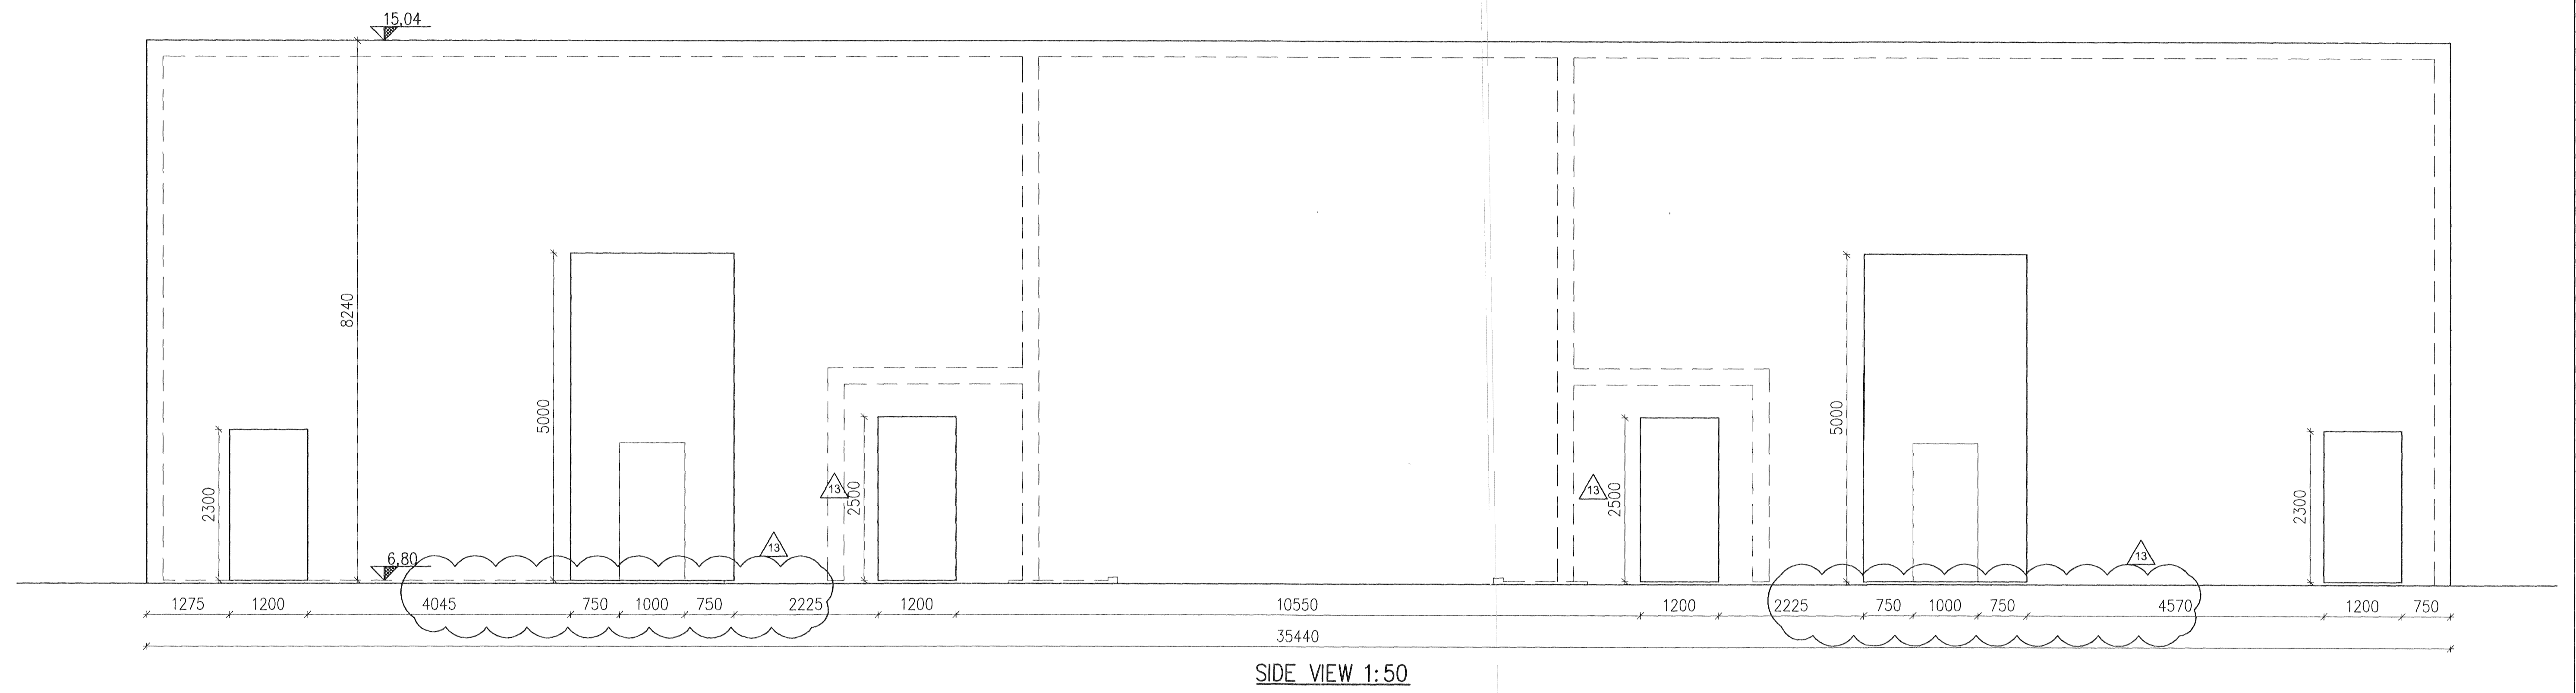

SIDE VIEW 1:50

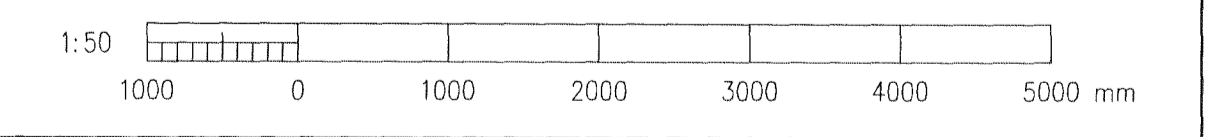

Skýringar:
 Legend:

13	Doors changed	11.01.18	HS/LDB	NI	ÓS
12	Door size changed and dimensions added	10.12.22	HS/LDB	NI	ÓS
11	Issued for construction	10.05.06	HS/LDB	NI	ÓS
Ólg nr / Rev no	Lýsing / Description	Dagsetning / Date	Höfundur / Des/Drw	Yfirl / Ovd	Notk heim / Suppl hel

This drawing is the property of Rio Tinto Alcan Iceland Ltd. and handed out for personal use only. It may neither be copied nor made available to others without permission of Rio Tinto Alcan Iceland Ltd. The receiver is liable for any misuse.

Ólg nr / Rev no	Lýsing / Description	Dagsetning / Date	Höfundur / Des/Drw	Yfirl / Ovd	Notk heim / Suppl hel	Stærð / Format: A1	Mkv. / Scale: 1:50
-----------------	----------------------	-------------------	--------------------	-------------	-----------------------	--------------------	--------------------

	Dagsetning / Date 2009.01.22	Teiknað / Drawn LDB	IDP410-RECTIFIER BUILDINGS A5/S1 SIDE VIEW 1/2	Flokkur nr. /	Bláð nr. /	Nesta bl. nr. /
	Hannað / Designed HS	Yfirl / Chkd NI		Kostn.nr.-Ccmo. / Blm.nr.-Eqno 4011	AKS	
Verktaki / Supplier HRV	Teg.teikningar / Dwg. type: FORM WORK			ISAL	ISAL	Breyt./Rev.
Tekn.nr.verktaka / Supplier drw.no. IDP-410-CA-015-225 Samþykkt / Approved NI	ISAL IS-222 Hafnarfordur Ísland			ISAL / Drw.no. of ISAL	C	
Húti of. / Part of:	ISAL Yfirbú og skráð, dags / ISAL Checked, date		ISAL Samþykkt, dags / ISAL Approved, date			