

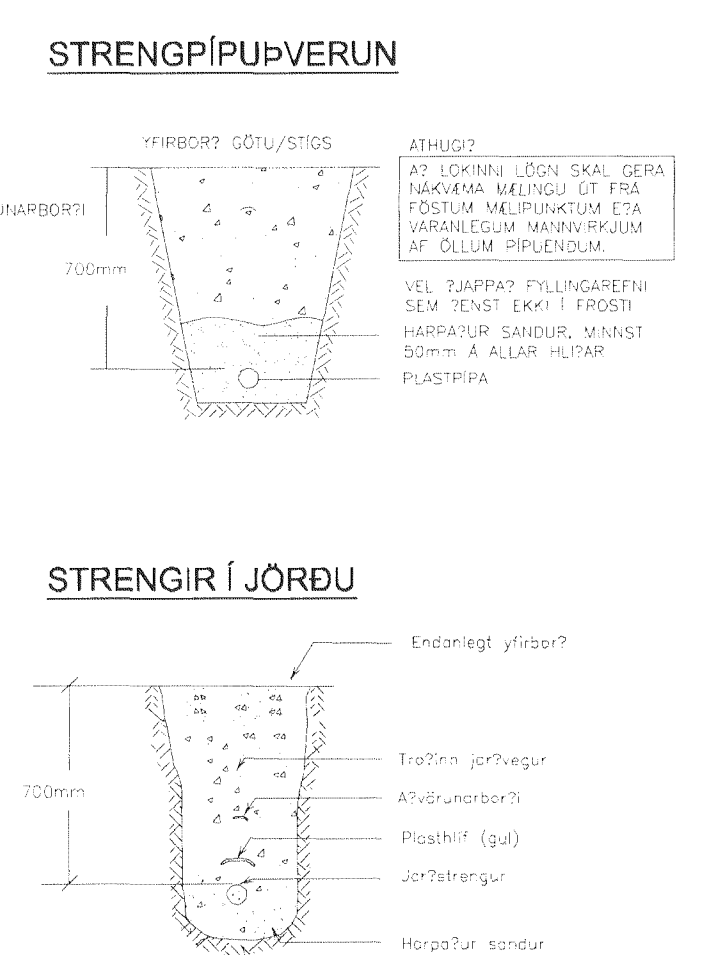
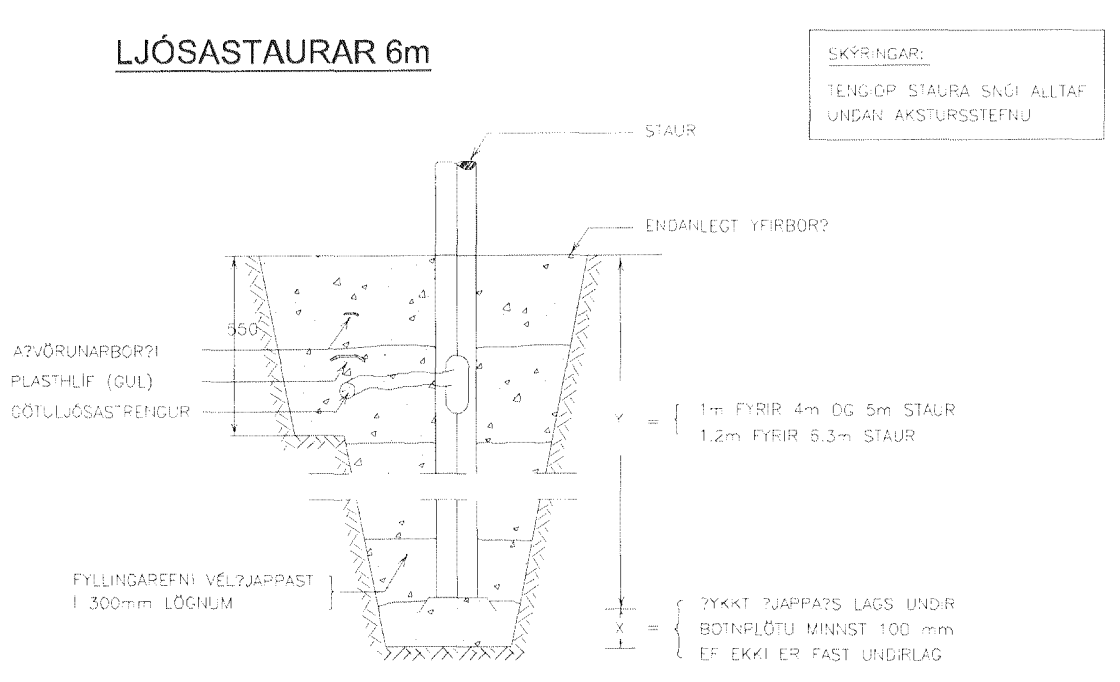
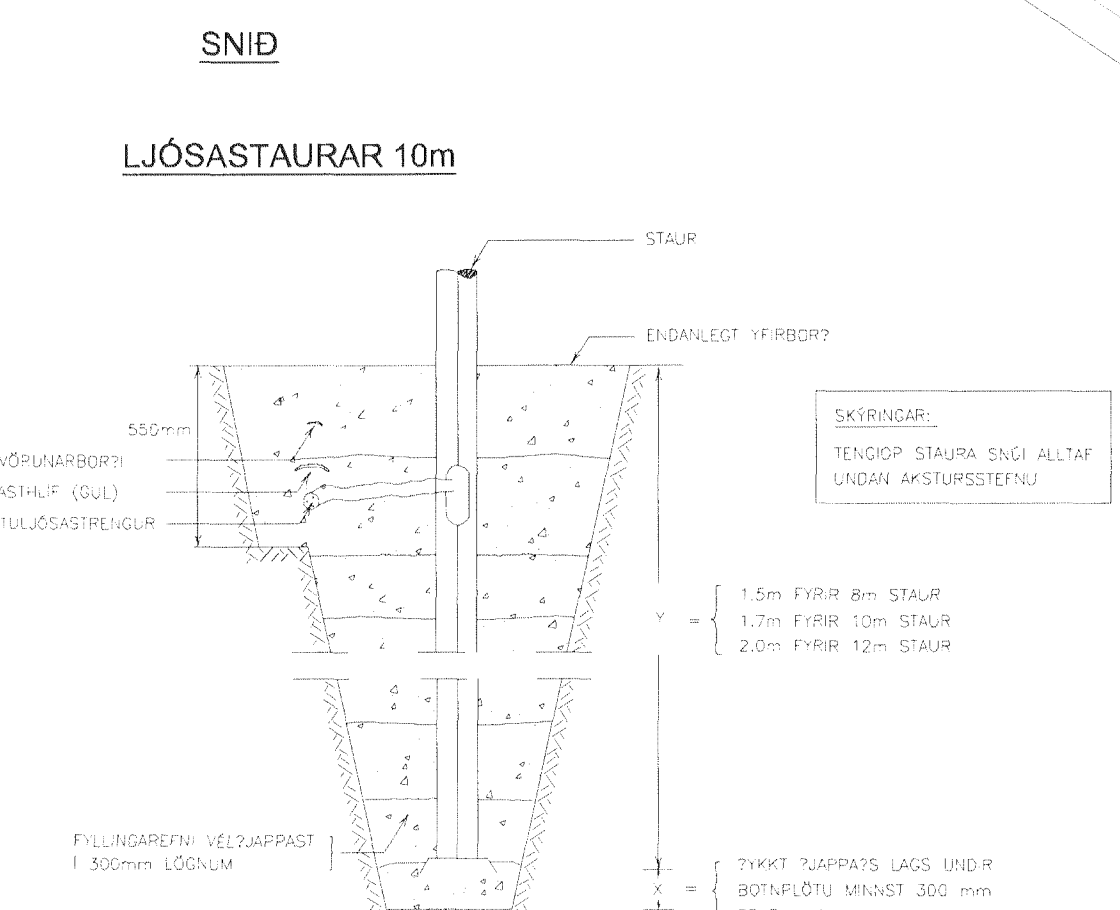


AUSTUR	NORDUR	AUSTUR	NORDUR		
R01/10	351669.922	396875.402	R36	Tekinn niður	
R02/10	351661.318	396889.559	R37	351670.952	396895.623
R03/6	351647.596	396910.492	R38	351680.066	396890.493
R04/6	351658.510	396935.745	R39	351683.179	396885.364
R05/6	351614.142	396893.466	R40	351689.150	396890.345
R06/6	351624.990	396916.427	R41	351695.130	396893.984
R07/6	351635.215	396939.699	R42	351701.110	396897.623
R08/10	351692.414	396859.561	R43	351707.083	396901.255
R09/10	351667.466	396821.817	R44	351712.308	396905.733
R10/10	351639.634	396792.869	R45	351712.062	396912.518
R11/10	351605.707	396772.274	R46	351711.462	396919.492
R12/10	351566.651	396748.564	R47	351710.862	396926.466
R13/10	351617.128	396789.913	R48	351681.080	396881.872
R14	351639.812	396833.094	R49	351678.910	396875.216
R15/10	351572.723	396764.941	R50	351632.603	396953.165
R16/10	351587.670	396796.590	R51	351635.248	396954.480
R17/10	351602.695	396828.357	R52	351637.920	396955.363
R18/10	351617.720	396860.048	R53	351640.698	396955.816
R19/10	351661.597	396994.598	R54	351643.409	396955.712
R20/10	351670.195	396969.650	R55/10	351683.513	396921.675
R21/10	351685.587	396942.468	R56/10	351679.782	396906.068
R22	351629.979	396957.332	R57/10	351708.046	396930.589
R23	351635.222	396959.833	R58	EKKI HNITASETTIR	
R24	351641.155	396961.650	R59	EKKI HNITASETTIR	
R25	351646.735	396962.618	R60/10	351652.374	396903.344
R26	351651.223	396965.342	BR1	351673.225	396932.000
R27	351655.710	396968.066	BR2	351688.060	396944.290
R28	351672.920	396978.512	BR3	351658.382	396964.197
R29	351677.194	396981.107	BR4	351673.953	396974.451
R30	351681.468	396983.701	BR5	351685.557	396989.248
R31	351685.625	396986.225	BR6	351692.333	396914.524
R32/10	351691.760	396969.891	BR7	351638.207	396837.126
R33/10	351710.895	396846.947	BR11A	351637.900	396996.527
R34/10	351736.900	396861.657	BR12	351623.891	396961.741
R35/10	351760.330	396875.353			

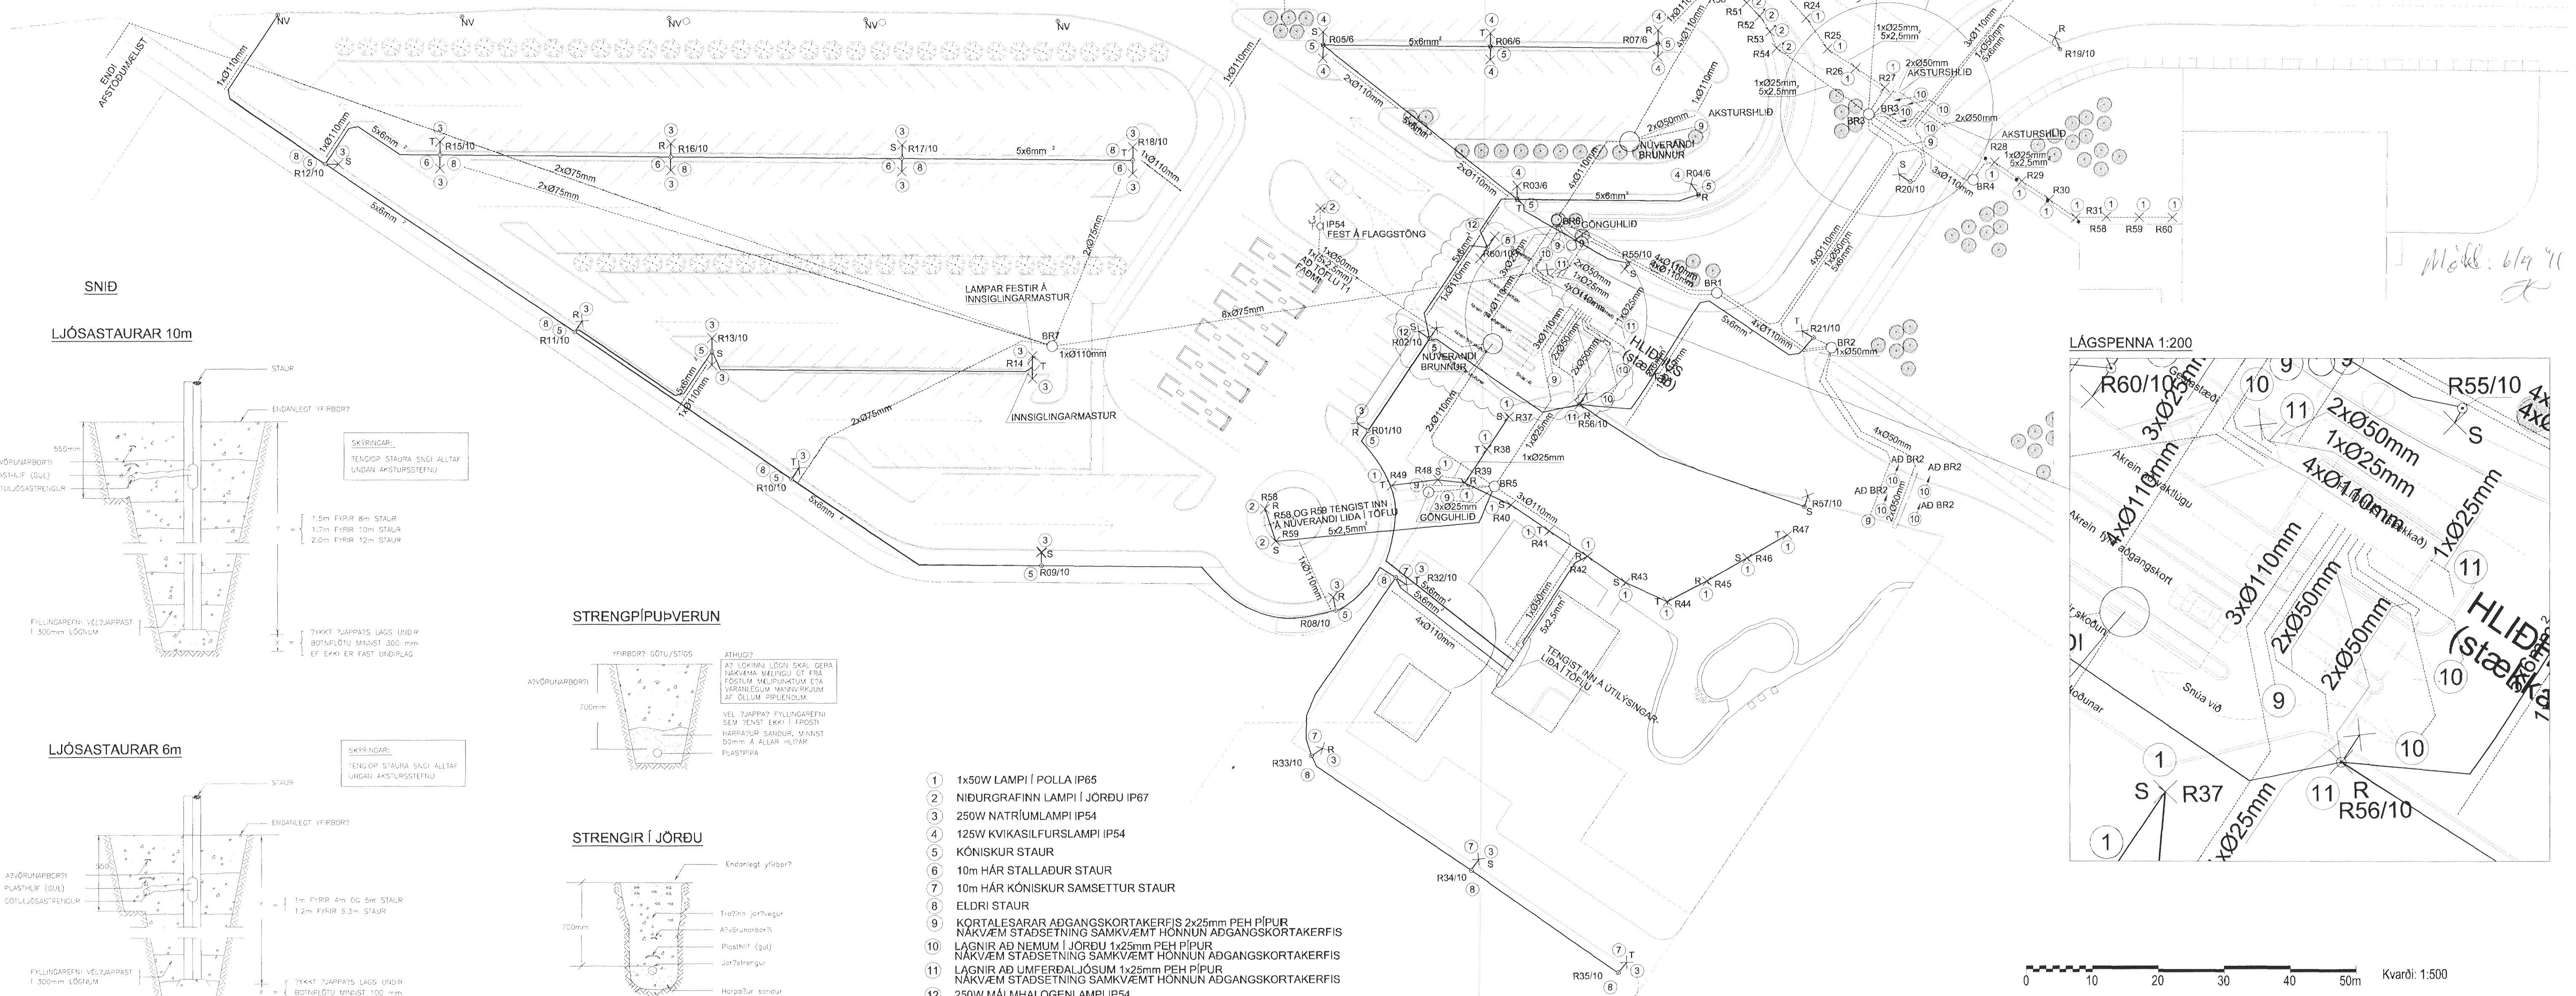

- 1 1x50W LAMPI Í POLLA IP65
- 2 NIDURGRAFINN LAMPI Í JÖRÐU IP67
- 3 250W NATRÍUMLAMPI IP54
- 4 125W KVIKASILFURSLAMPI IP54
- 5 KÓNISKUR STAUR
- 6 10m HÁR STALLADUR STAUR
- 7 10m HÁR KÓNISKUR SAMSETTUR STAUR
- 8 ELDRI STAUR
- 9 KORTALESARAR ADGANGSKORTAKERFIS 2x25mm PEH PÍPUR NÁKVÆM STADSETNING SAMKVÆMT HÖNNUN ADGANGSKORTAKERFIS
- 10 LAGNIR AD NEMUM Í JÖRÐU 1x25mm PEH PÍPUR NÁKVÆM STADSETNING SAMKVÆMT HÖNNUN ADGANGSKORTAKERFIS
- 11 LAGNIR AD UMFERDALJÓSUM 1x25mm PEH PÍPUR NÁKVÆM STADSETNING SAMKVÆMT HÖNNUN ADGANGSKORTAKERFIS
- 12 250W MÁLMHALOGENLAMPI IP54

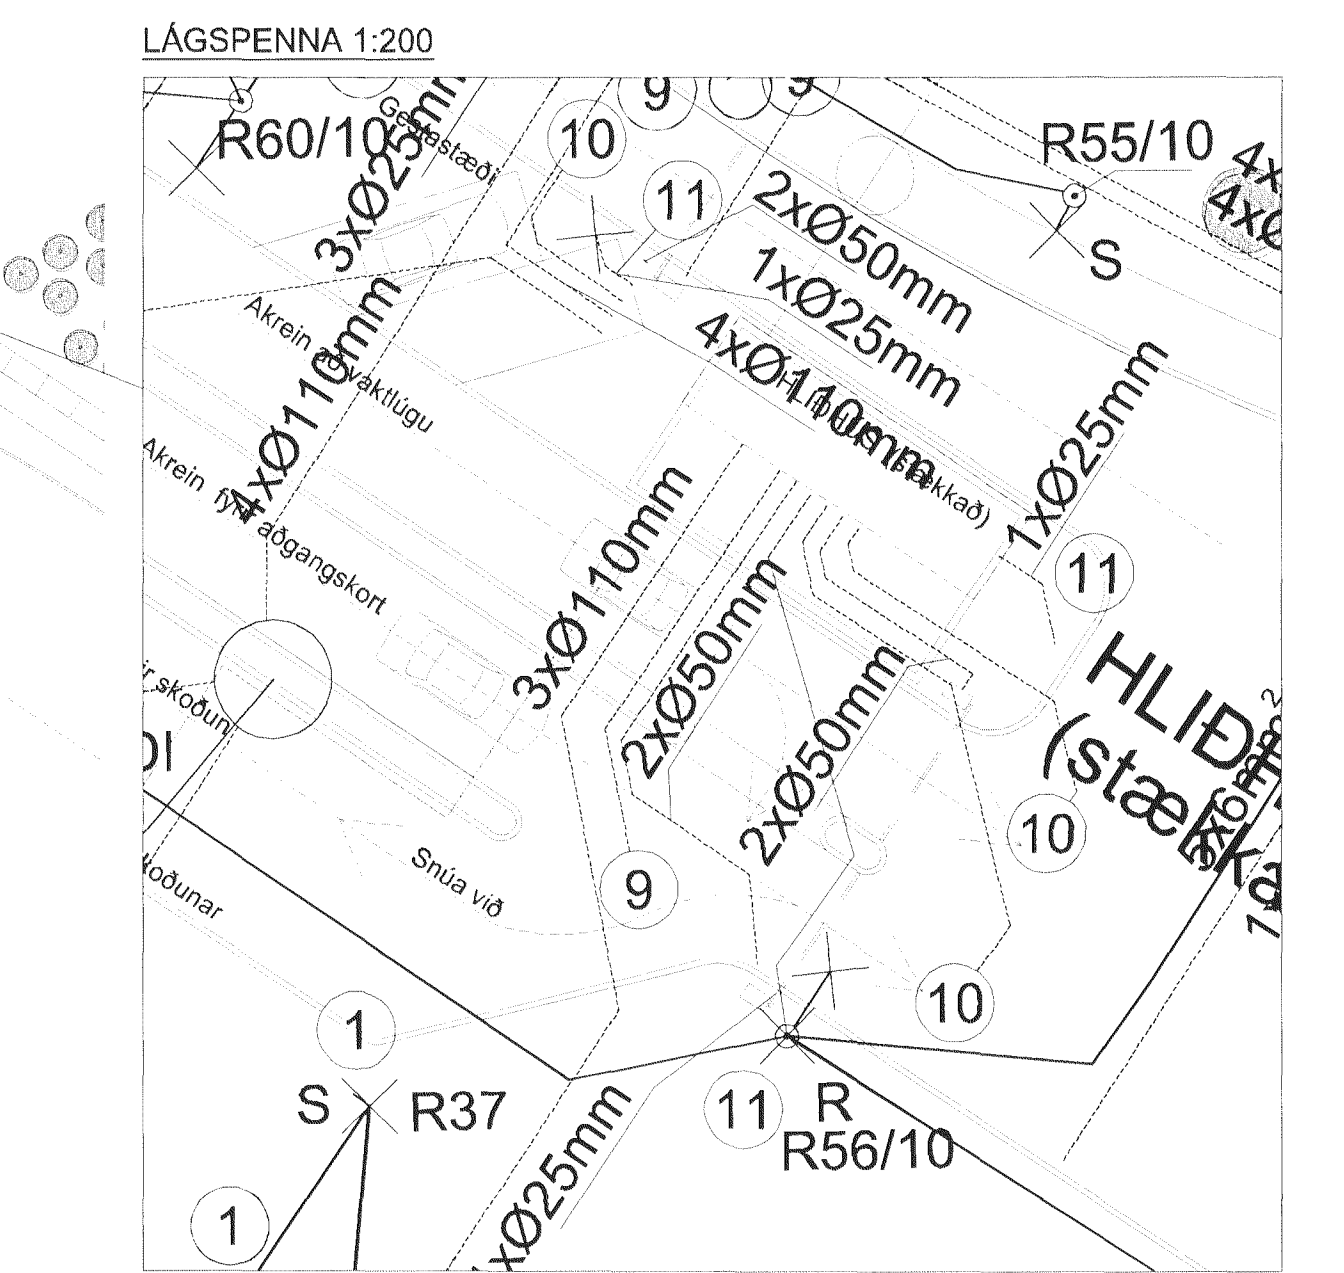

Kvarði: 1:500

Útskýringar:
 Explanations:

R2/10	HÆÐ Á STAUR
	NUMÉR Á STAUR
	RAFMAGN

ATHUGASEMDIR

NV	NUVERANDI MASTUR
BR2	NUMÉR BRUNNS
	LAGNABRUNNUR FYRIR RAFMAGN

Nr. / No.	Breyting / Revision	Dags. / Date	Sampykkt / Approved	Notk. heimil. / Released
F	FÆRSLA VEGNA STÆKKUNAR HJÓLDEIS	15.04.11	BSC	
E	LÝSING VÍÐ LISTAVERK	22.03.06		
D	YMSAR BRÉYTINGAR	14.10.05		
C	FJÖLGLUN LJÓSASTAURA	10.08.05		
B	FJÖLGLUN RÖÐRA VÍÐ GÖNGUHLÍÐ	26.07.05		
A	VERKTEKNING	21.06.05		

This drawing is the property of Rio Tinto Alcan Iceland Ltd and handed out for personal use only. It may neither be copied nor made available to others without permission of Rio Tinto Alcan Iceland Ltd. The receiver is liable for any misuse.

Starf. Formát: A1 Máv. Skala: 200:1:500


VSB VERKFRÆÐISTOFTA

Háttur / Object:	ADKOMA ALCAN	Alfgr. / Eign / Material:	RAFORKUVIRKI-LAGNIR Í LÓÐ	Abcd
Dagsetning / Date:	06.05.2005	Skr. / Eign. / heild / Total / Weight / Weight (kg):		
Handað / Designed:	BSC	Flékkur nr. / Blað nr. / Next bl. no.:	00	00
Teknað / Drawn:	BSC	Kostnaður - Acc. No. / Búnaður - Eq. No.:		
Stjórnað / Checked:	ÓC	4200 UZ10		
Stjórnað / Checked:	ÓC	168866		
Teknað / Drawn:	BSC	F		
Stjórnað / Checked:	ÓC			