


1 ALFBERG

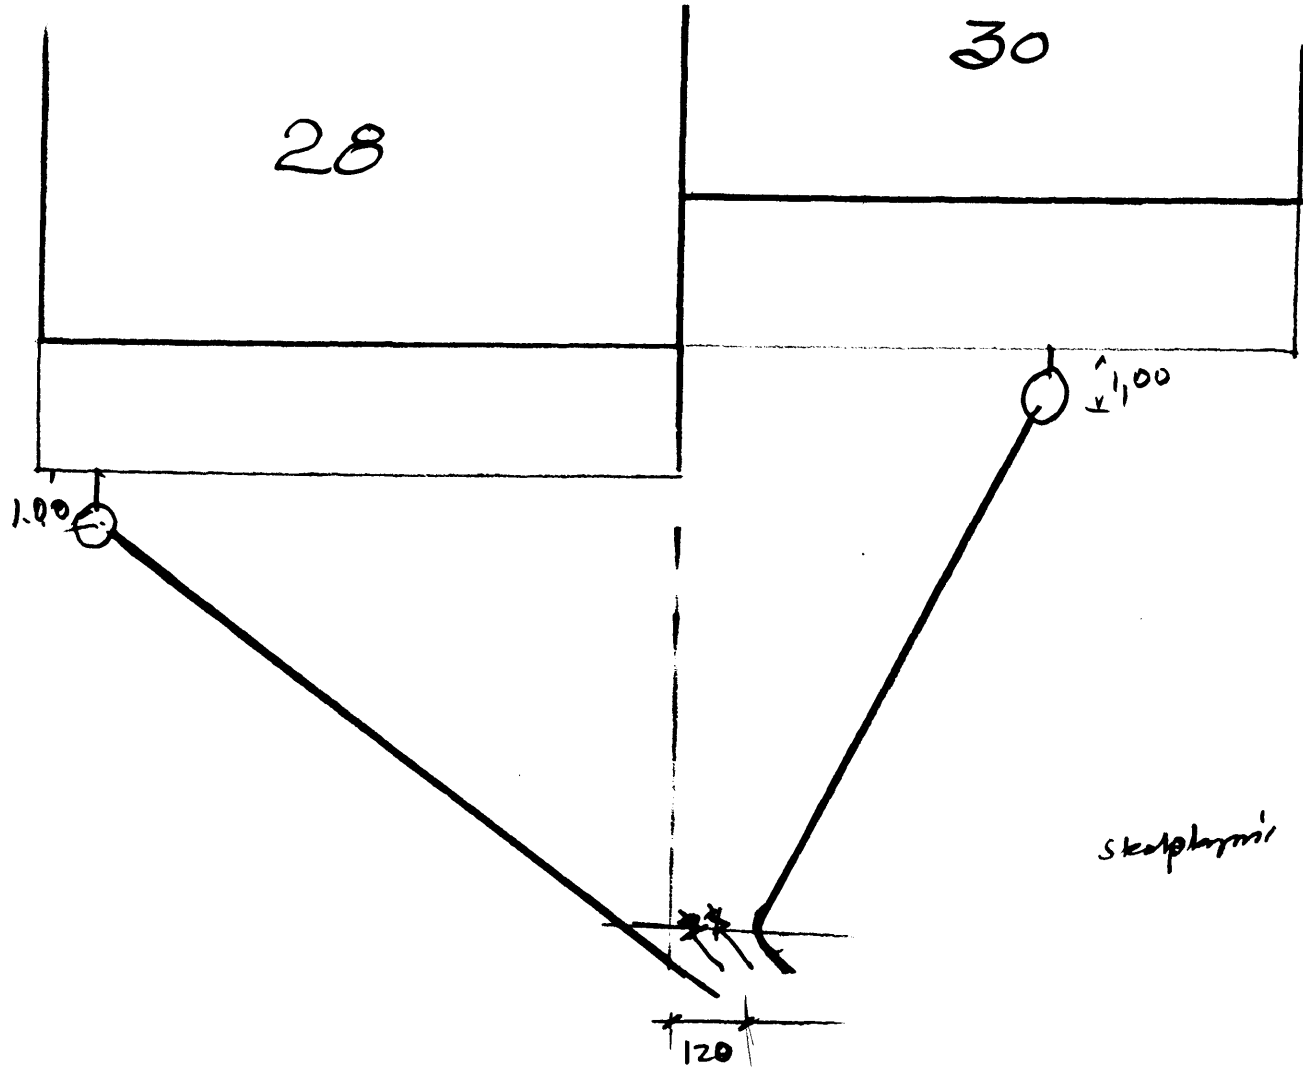

HAMRABERG

F. h. 13/12 04