


Alfaberg 28-30 Hafnarfirði

Samb. lit. á fundi byrjað
26.10.83
BYGGINGARFRÁHAG
I Hafnarfirði
S. Sigurðsson

Hskinn á brú nr 28 sé 7,0 m
frá götun.
F. 513.

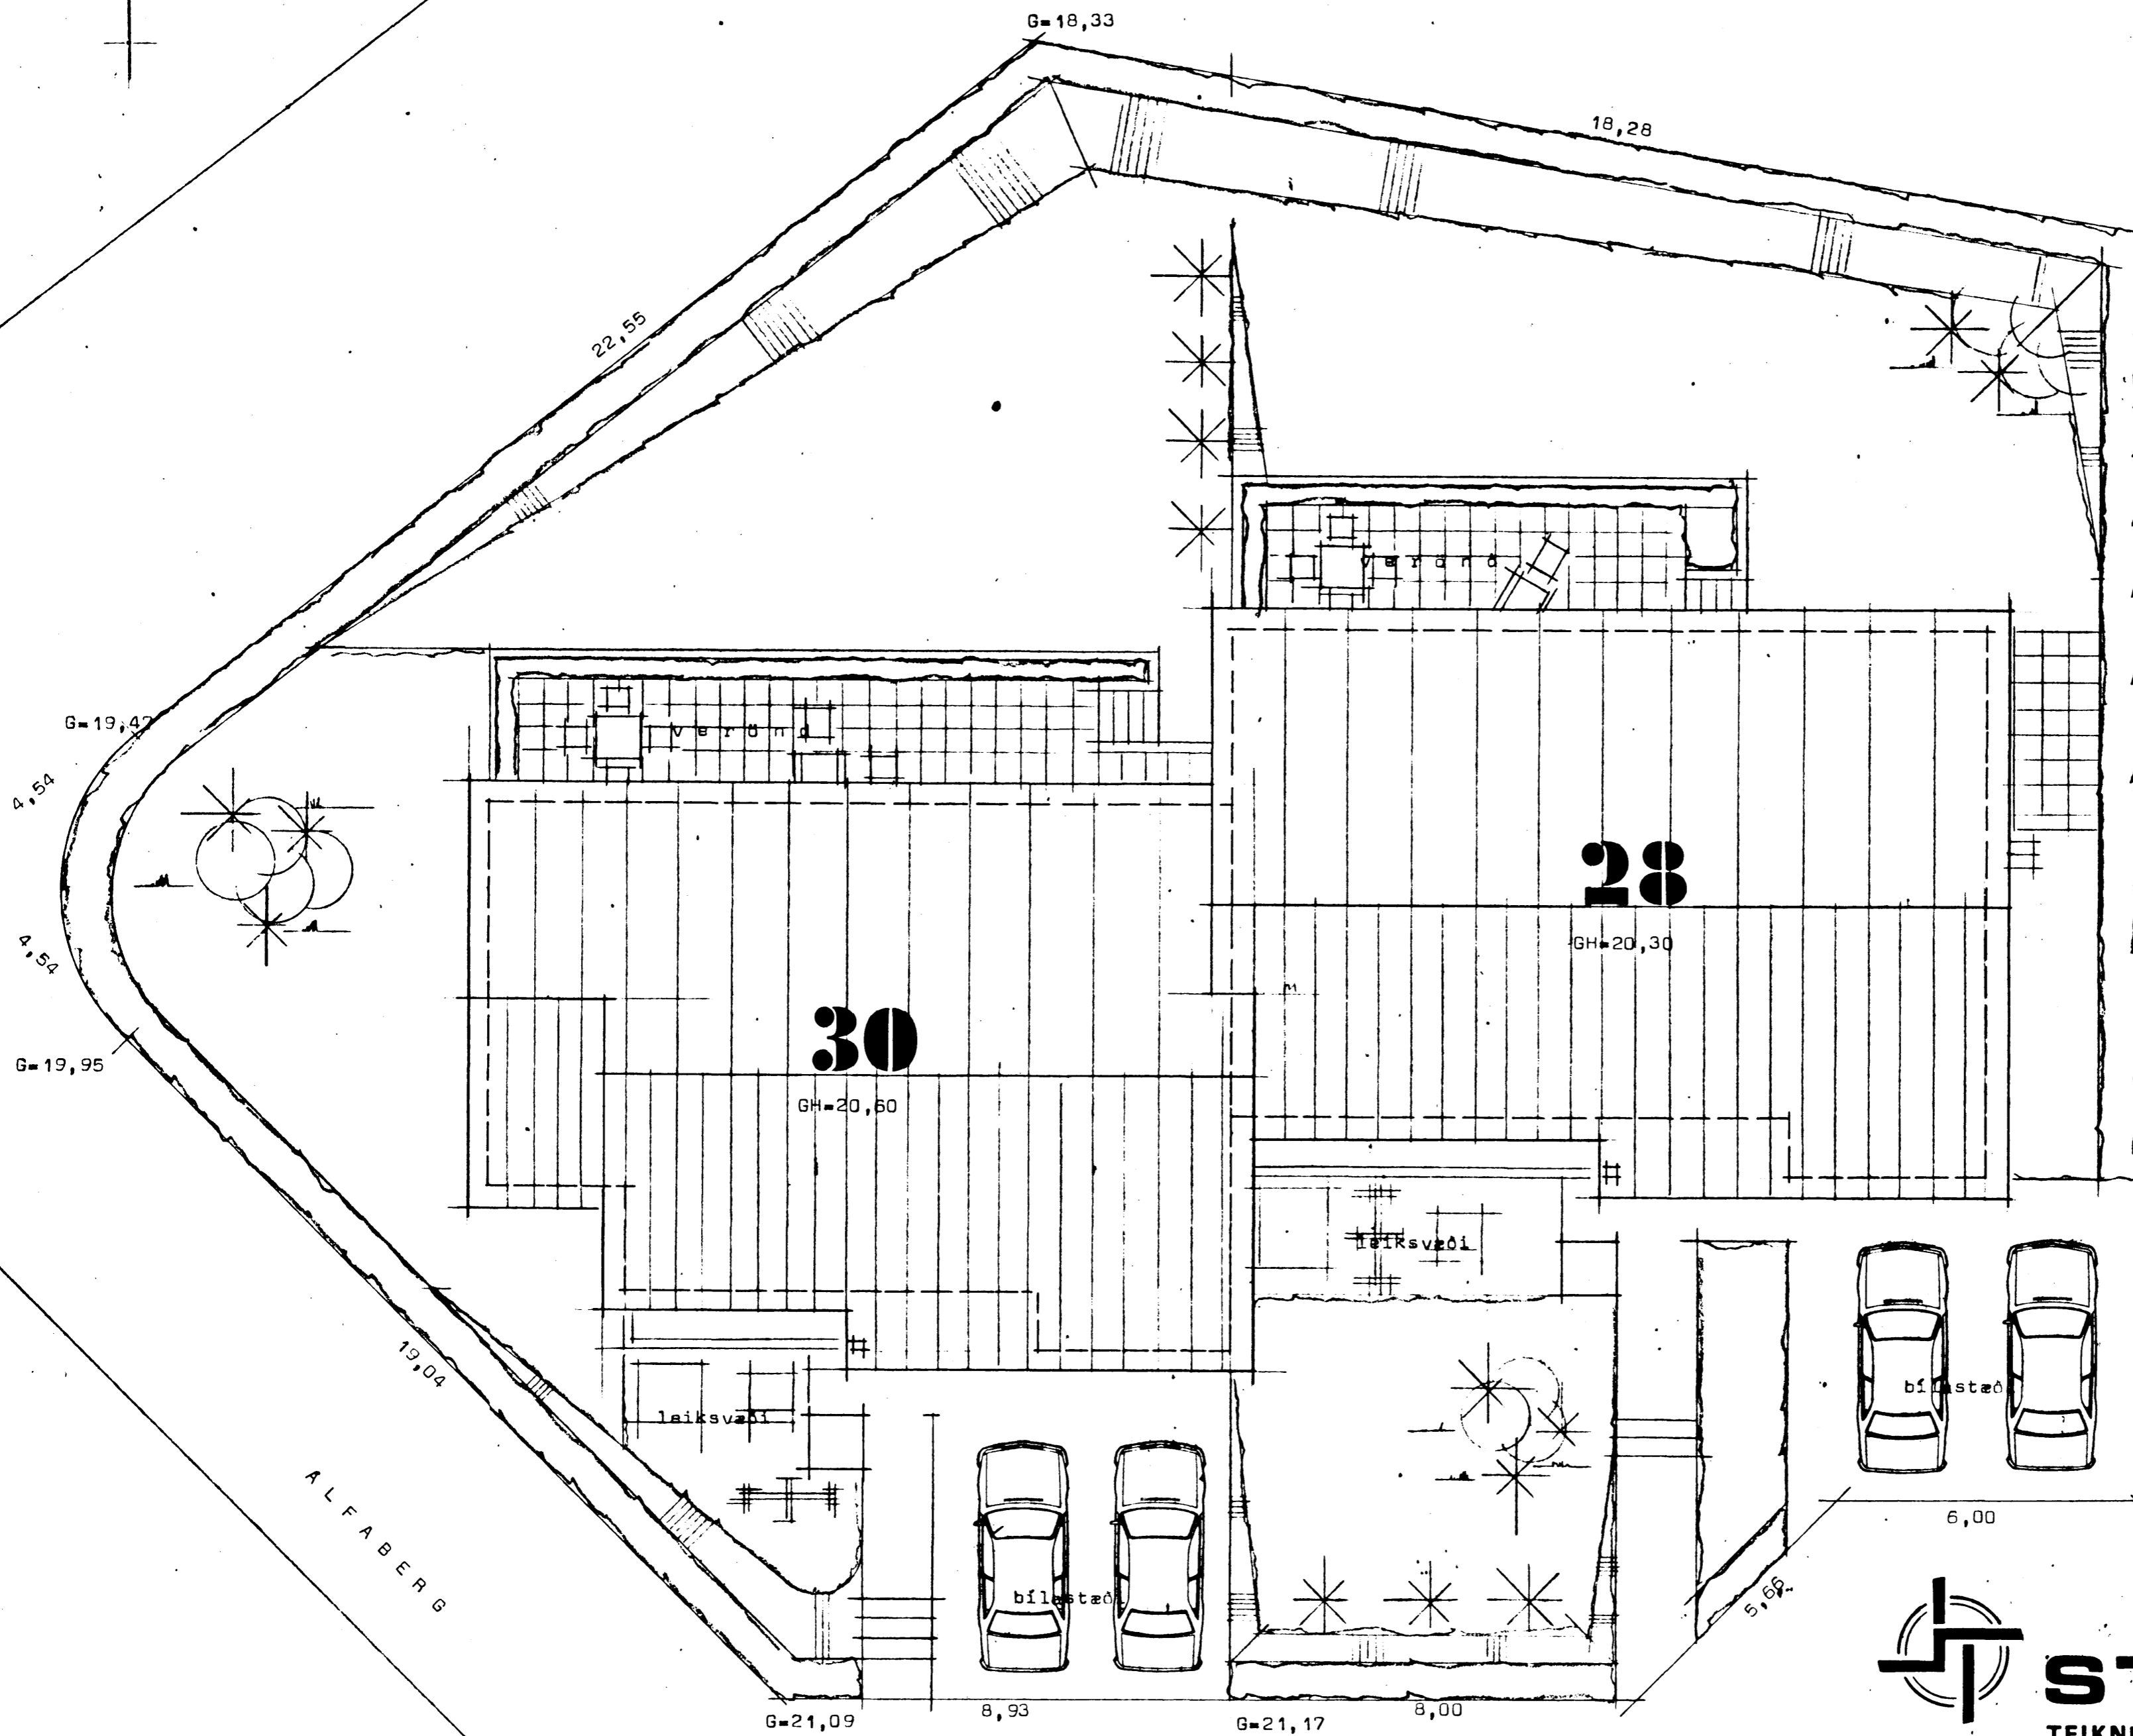

ALFABERG

ALFABERG



0090-0280: 01

STAÐALHÚS S F

TEIKNISTOFA SÍÐUMULA 31 SÍMI 83141

VERKEFNI	DAGS.	1983	VERK NR SU 142	
Lóðarmynd	MK 28	MKV.		1:100
Alfaberg 28-30 Hafnarfirði		BR.		
		BLAD NR		1.04

SIGURDUR GUDMUNDSSON SIGURDUR P. KRISTJÁNSSON FTÍ