


1 ALFBERG

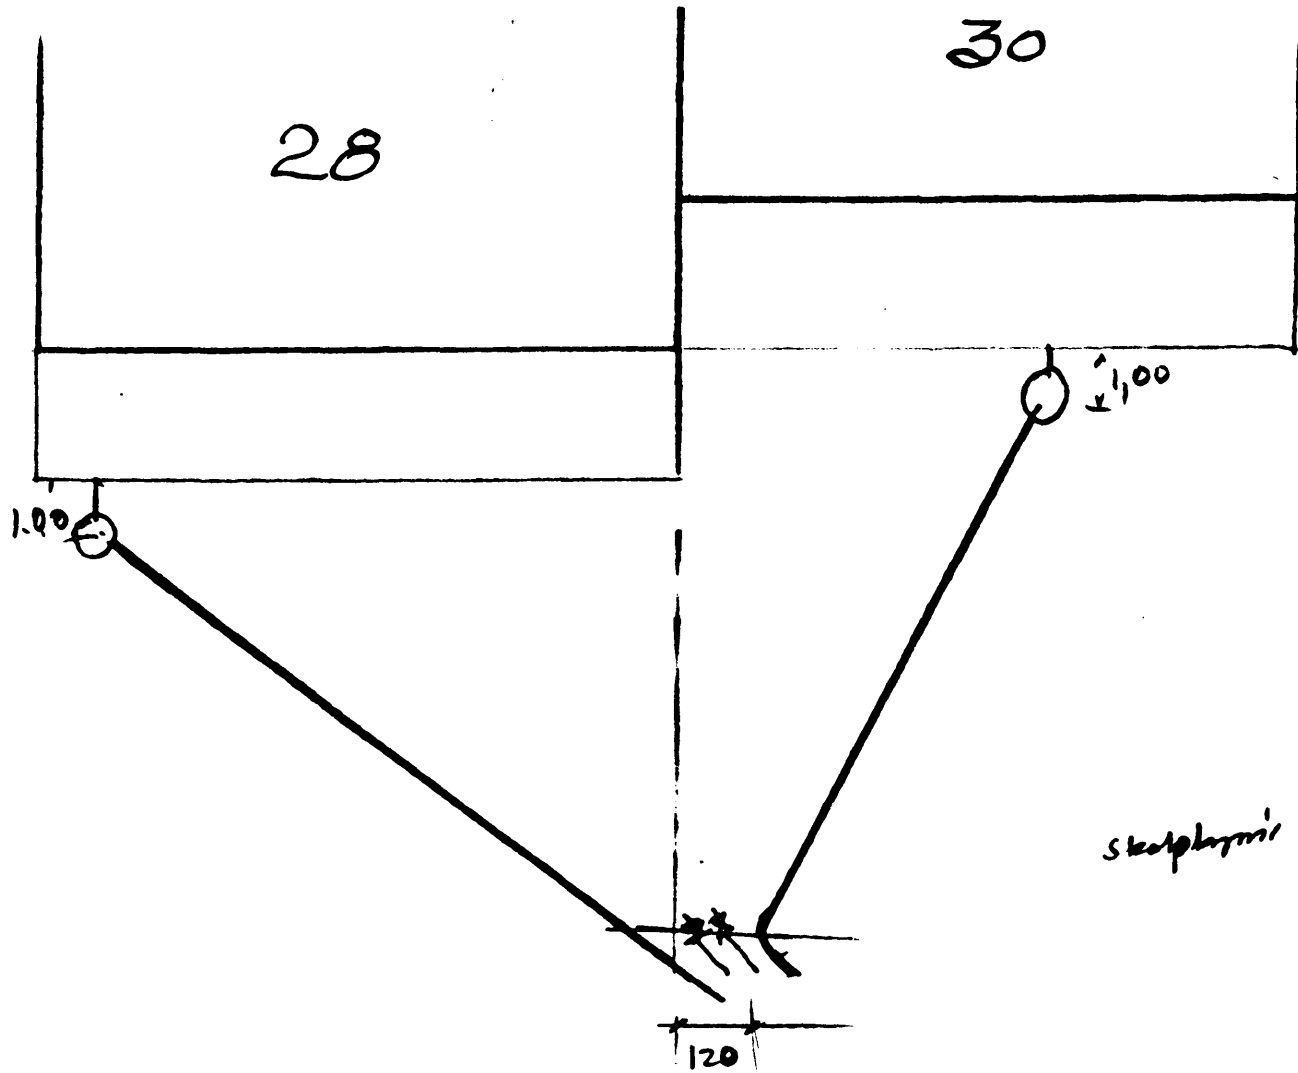

Skolphynt

HAMRABERG

F. J. 13/12 81