


Sarab 101 a fundi b, ggr
 nafnarb 30/7 92
 BYGGINGARFR. BFI
 Ing. G. Þorsteinsson

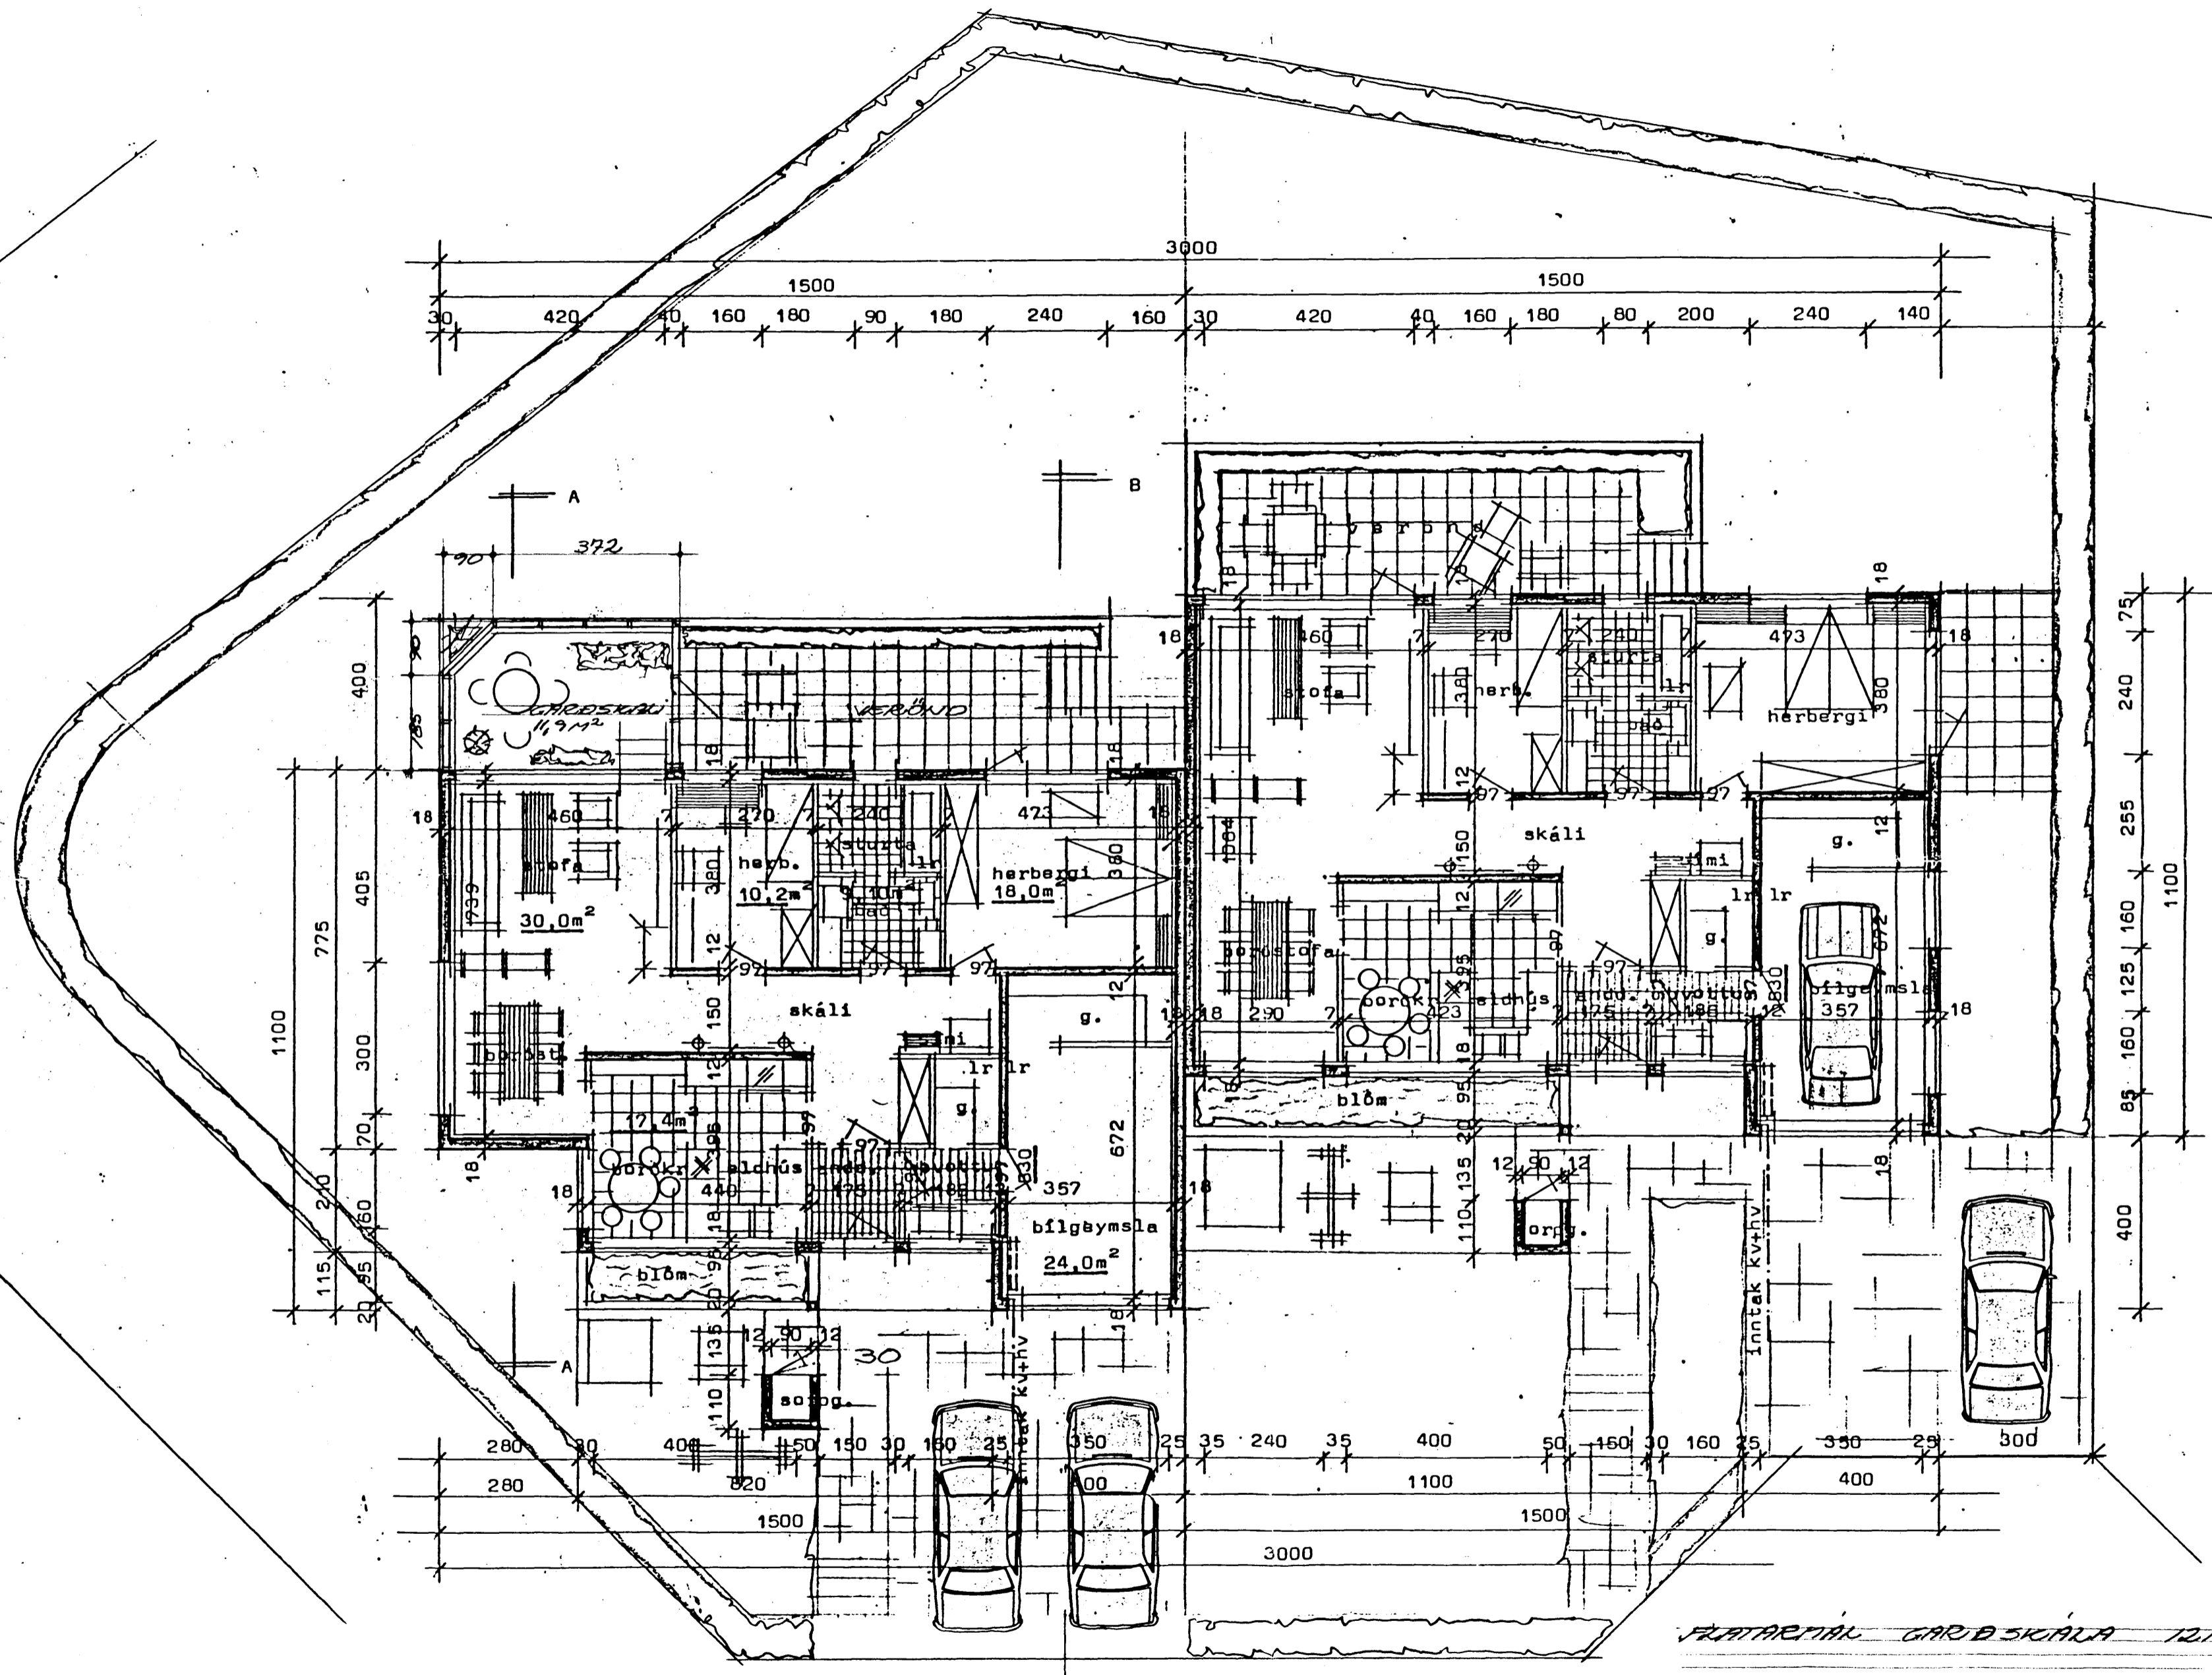

*Beintíma línum
 samþykkt.*

0090-0300.01

PLATTARÍM GARDASKALA 12M² RÚMMAÐ 29,3 M³

ALFABERG 30 HAFNARFJÓÐI	NR 1
GRUNNDRYND	SKV. 1:100
INGI GUNNAR ÞORÐARSON BYGGINGARFR. BFI	D. SEPT 1992
ETJABAKKA 18 R.VK. 5. 7 33 23	
Ing. G. Þorsteinsson	