


GRUNNMÝND • 1:50

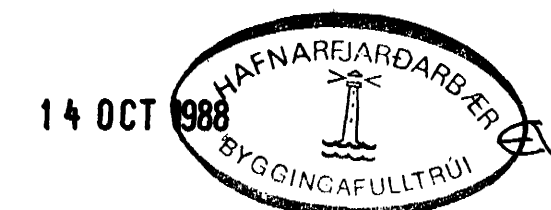

BR.NR.	DAGS	EDLI BREVTINGAR	SIGN.
	14.10.88	GARÐVATNI HEIT POTT. STÓFA 1 HERBERGI	
'ALFASKEIÐ 125 HAFNARFIRÐI			DAGS. MARS' 88
GRUNNMÝND HITA- OG VATNSLAGNA			HANNAÐ
MÆLIKV. 1:50			TEIKNAD
SIGURÐUR ÞORLEIFSSON TEKNIFRÆÐINGUR P.T.F.I.			VERK NR. 8806
STRANDGÖTU 11 HAFNARFIRÐI SÍMI 54751			BLADNR. 2-03