


OFNASKRA' Δt = 40°C



NR	HITATAP KCAL/KLST	MESTA LENGD	MESTA HÆÐ[MM]	TENGI	OFN
1	878	120	70	AB 10	
2	956	120	70	CD 10	
3	860	120	70	CD 10	
4	758	120	70	AB 10	
5	749	120	70	CD 10	
6	1375	140	70	CD 10	
7	803	120	70	CD 10	
8	1057	120	70	AB 10	*
9	1090	120	70	CD 10	
10	480			AB 10	
11	867			CD 10	
12	314			AB 10	
13	417			AB 10	
14	310			CD 10	
15	1300			AB 10	
16	70			AB 10	

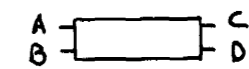

ÖLL RÖR ÓEINANGRUÐ EN MÁLUD

DANFOSS FJVR LOKAR Á ÖLLUM OFNUM

\* OFN SEM NÚ ER Í HJÓNAHERBERGI

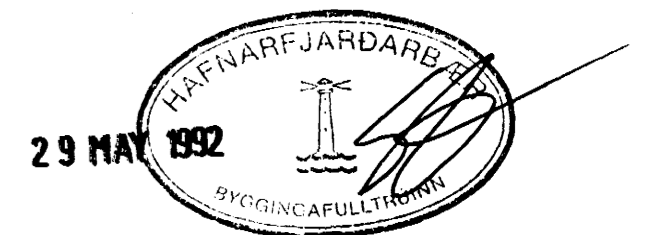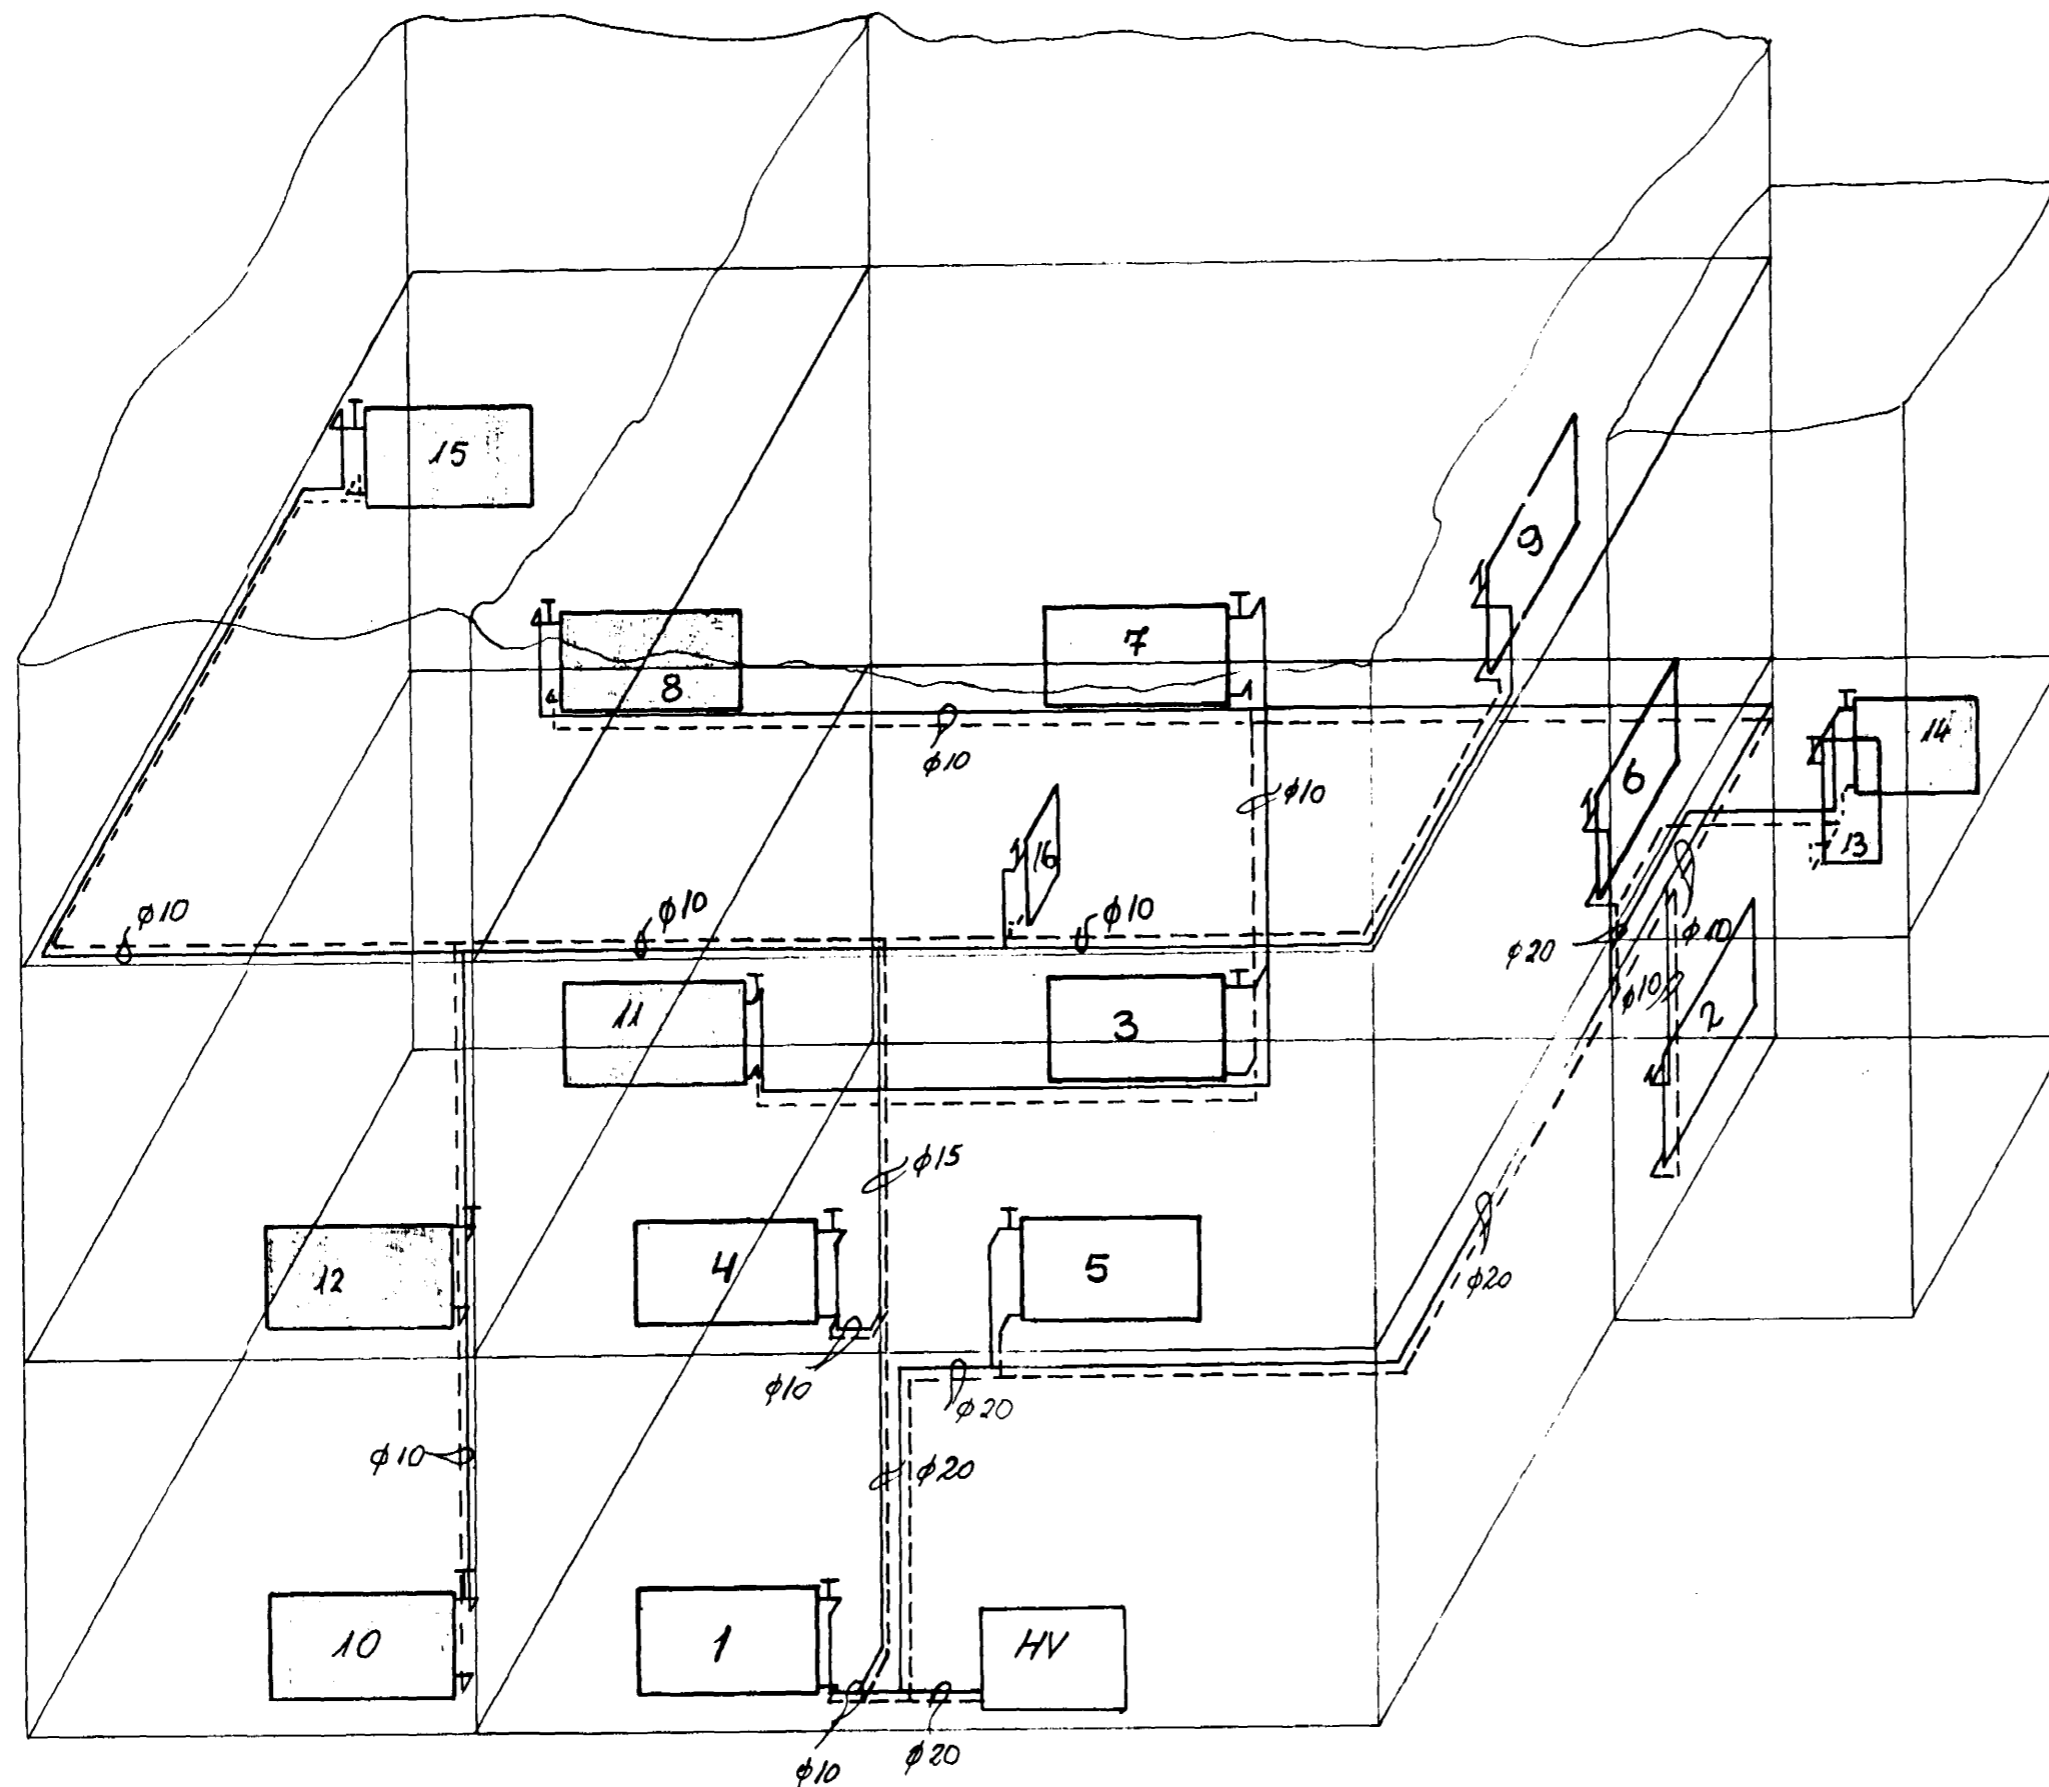

BREYTT Í APRÍL 1992 *H.P.*

BREYTT Í JÚNÍ '83  
*Hallgrímur Þómasson*

ALFASKEIÐ 26 HAFNARFIRÐI.	VERK.	BL. NR.
		4.2.
HITALAGNIR RÚMMYND	HAFNARFJÓRÐI	HAFNARFJÓRÐI
	MKV 1:50	REIKN. <i>H.P.</i> TEIKN. <i>H.P.</i>

HALLDÓR HANNESSON BYGG. VERKFR. MVEI.  
GUNNARSSUNDI 10 HAFNARF.