



MAGNI GUDMUNDSSON TAKNIFRÆÐINGUR		VERK NR. 043		SKRÁ NR. OKT 1973		KVAÐI 1:20	
NR.		BREYTING		R.M.G.		T.M.G.	
DAGS.		NARN		Y.		V.	
TEKNI NR. 3		BLAD NR. 3		AF 3		PAKVIDIR, GRUNNMYND	
ALFASKEIÐ NR. 00-00, HAFNARFIRÐI							

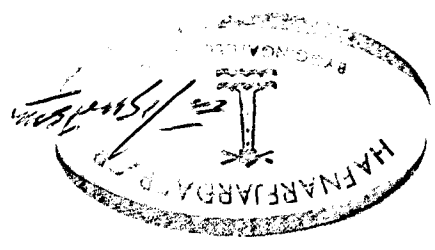


BREYTING A PAKI
SKYRINGAR SJÁ BLAD NR. 2


SNID E-E, 1:20

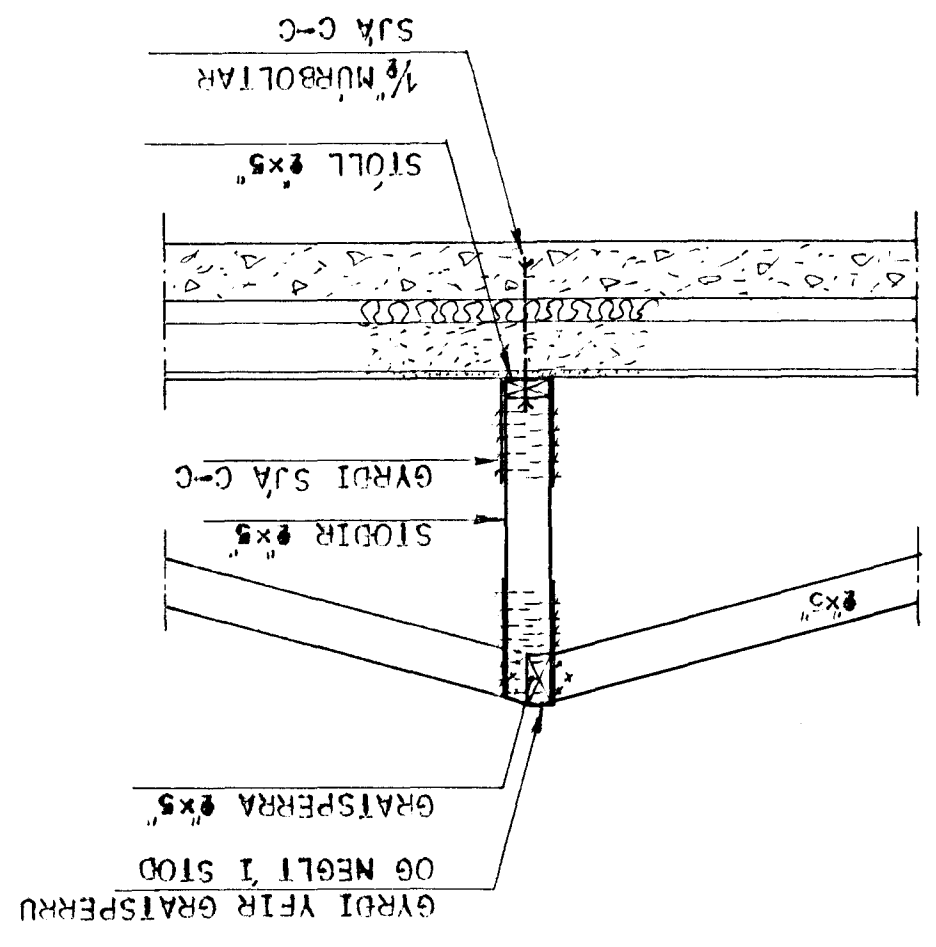

SNID B-B, 1:20

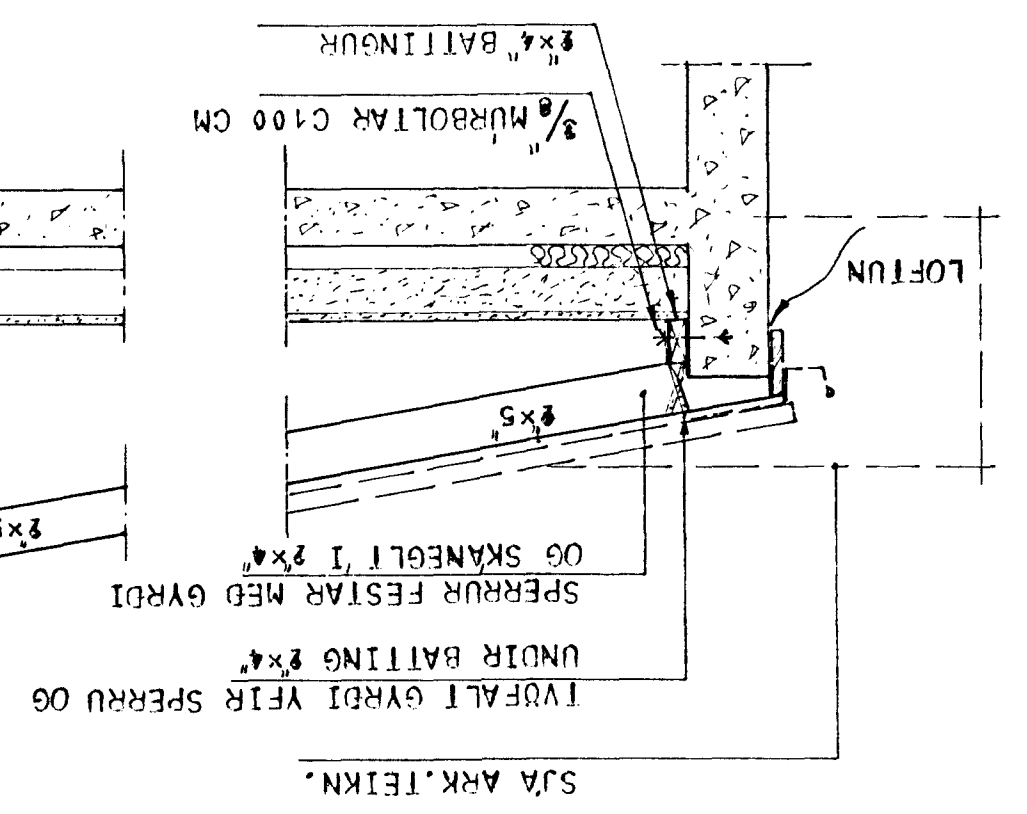

SNID C-C, 1:20

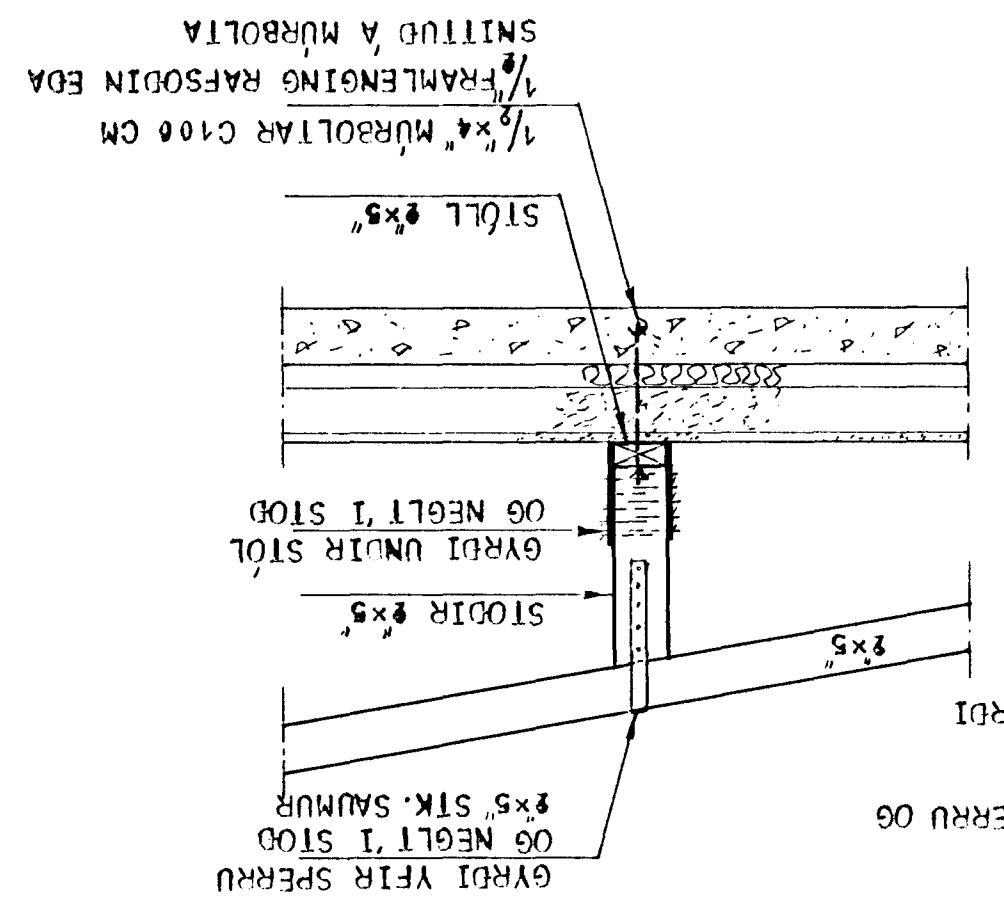

SNID D-D, 1:20

