



| | | | |
|-------------------------------------|--|--------------------------------------|--|
| MAONI GUDMUNDSSON TAKNIFRÁÐINGUR | | KVAÐI 1:50, 1:20 R.M.G. T.M.G. Y. | |
| TEKN NR. 1 | | VERK NR. 043 | |
| BLAD NR. 1 | | SKRÁ NR. OKI 1973 | |
| AF 3 | | ALFASKEIÐ NR. 86-88, HAFNARFIRÐI | |
| NR. Breyting | | ÞAKYÐIR, GRUNNMÝND | |
| DAGS. MARN | | | |

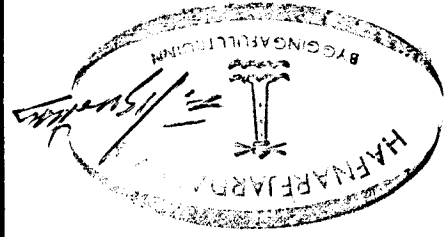

SNID A-A, 1:20

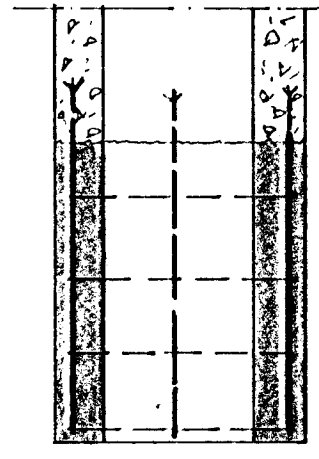

JÄRN 8x10 LÖDRETT
RAFSODIN A 1/8" MURBOLTA
LYKKJUR R8 C20

SKYRINGAR SJÁ BLAD NR. 2

BREYTING A ÞAKI

SKORSTEINN BENDIST
I ÚTBÖUN MEÐ 8 K10
LYKKJUR R8 C20
SJÁ SNID A-A

