




Samþykkt þingi

2. OKT. 1993

Handwritten text: *Handwritten signature*

Handwritten initials: *RP*

GEYMSLUR Í KJALLARA STAD FÆRÐAR.

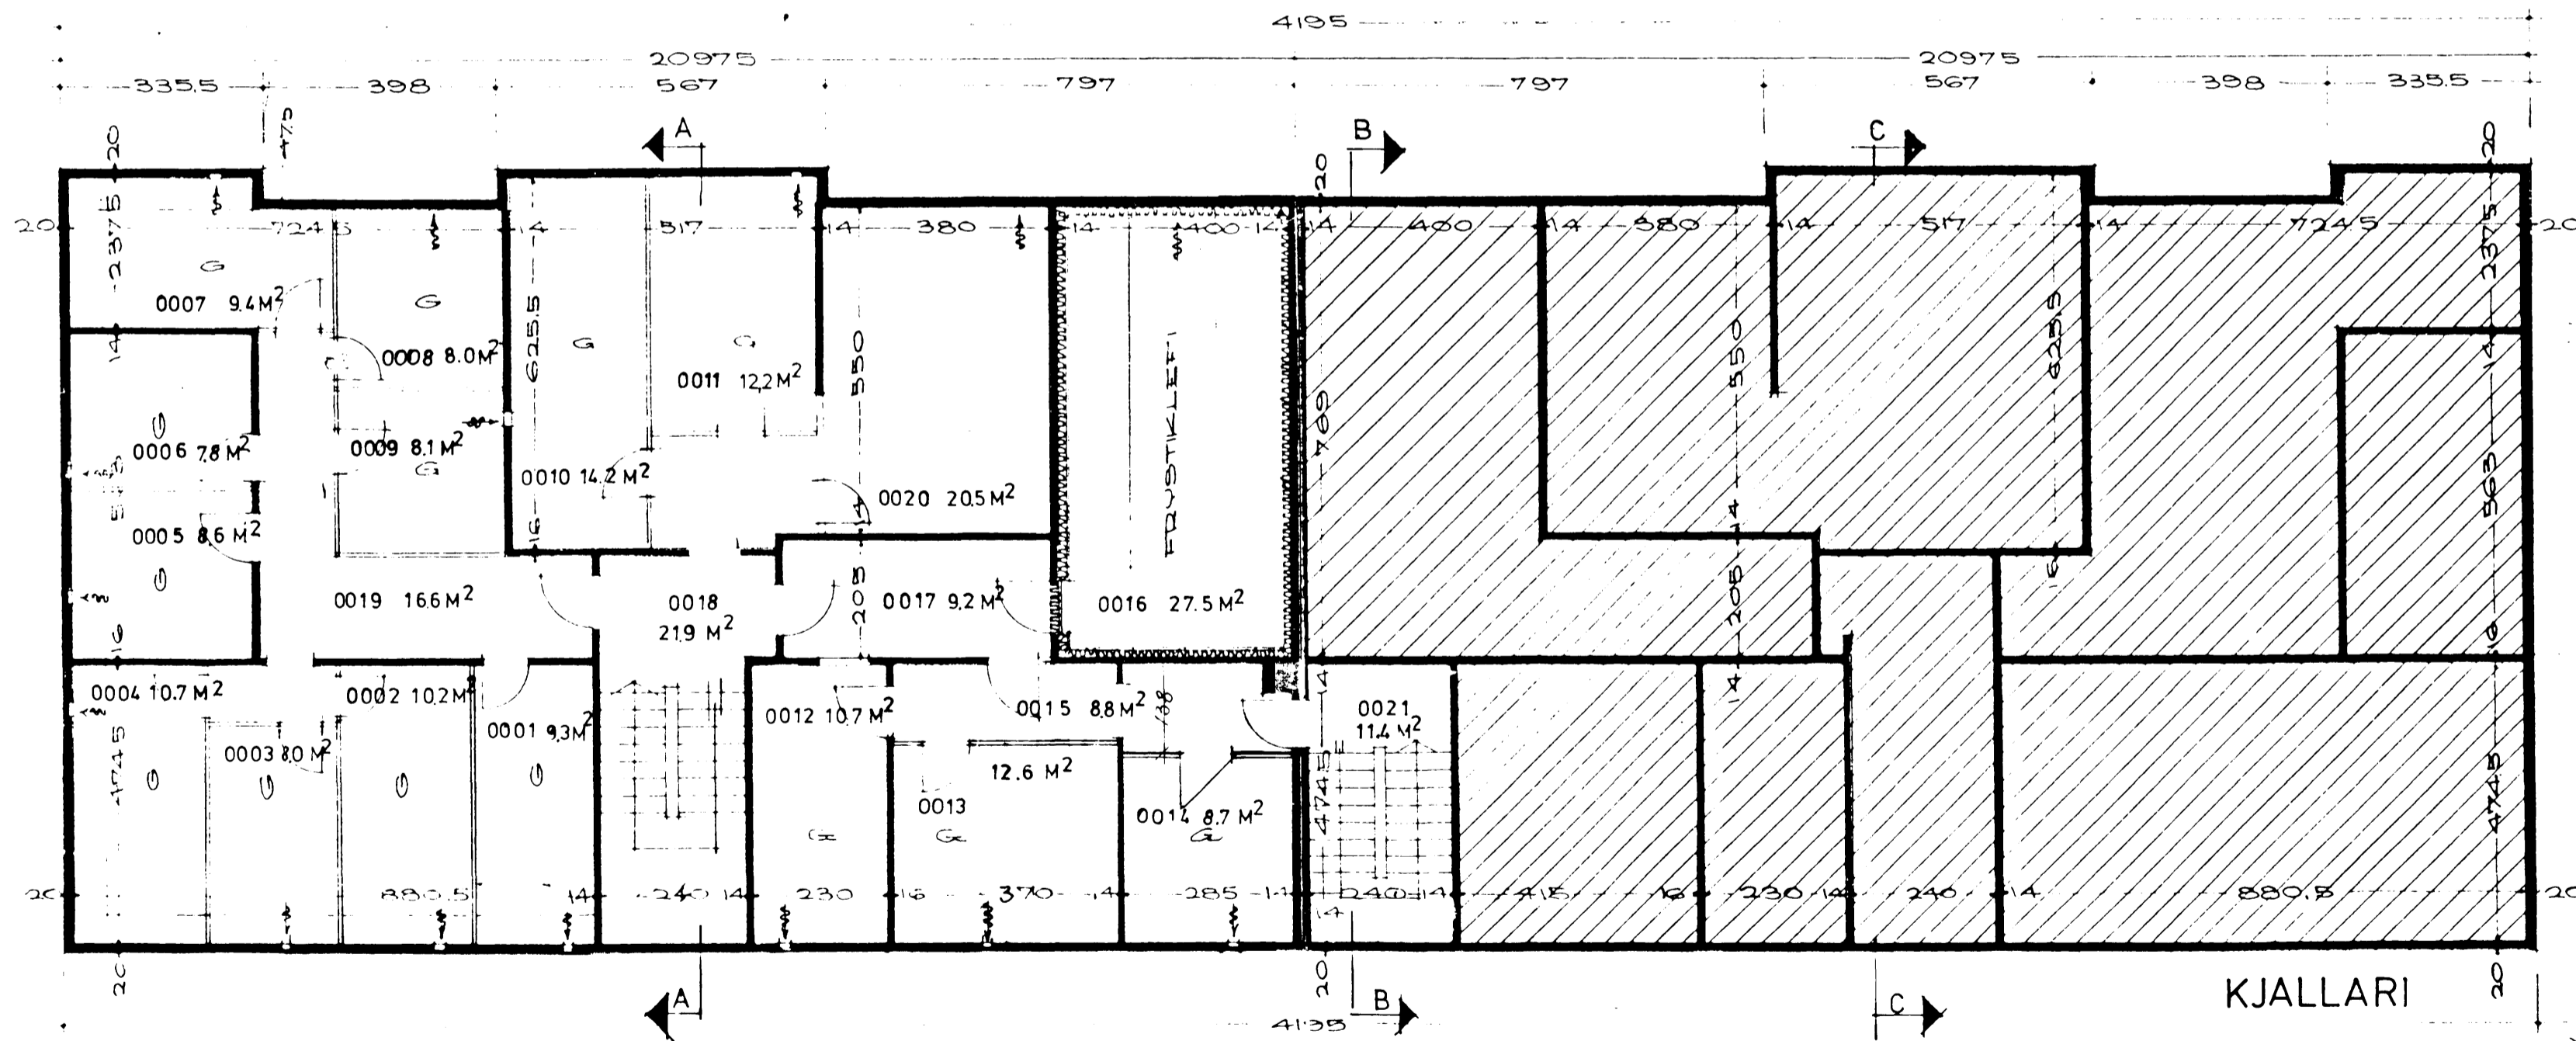

REYKJAVÍK, 1. MAÍ 1965

Baltur Þorvaldsson
Ólafur Guðmundsson 1/7.

5. OKT. 1999.

LITLA TEIKNISTOFAN
220 Hafnarfirði

Ólafur Guðmundsson
ARK. FAH