





KP

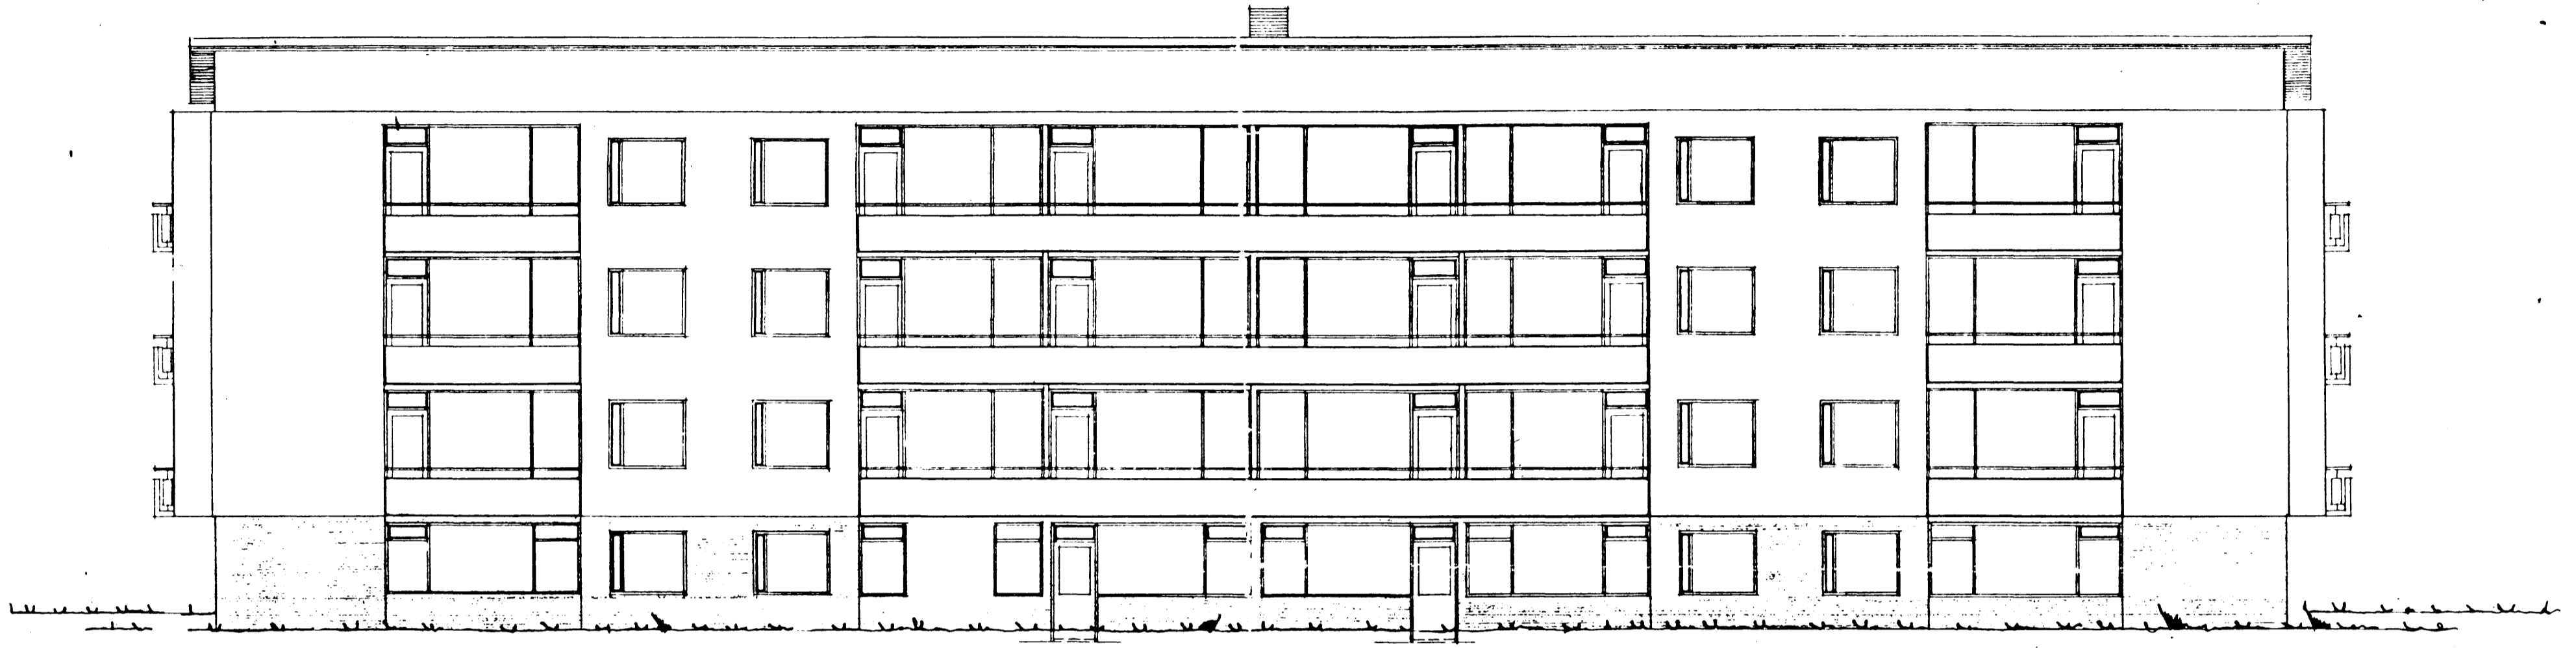

VESTUR

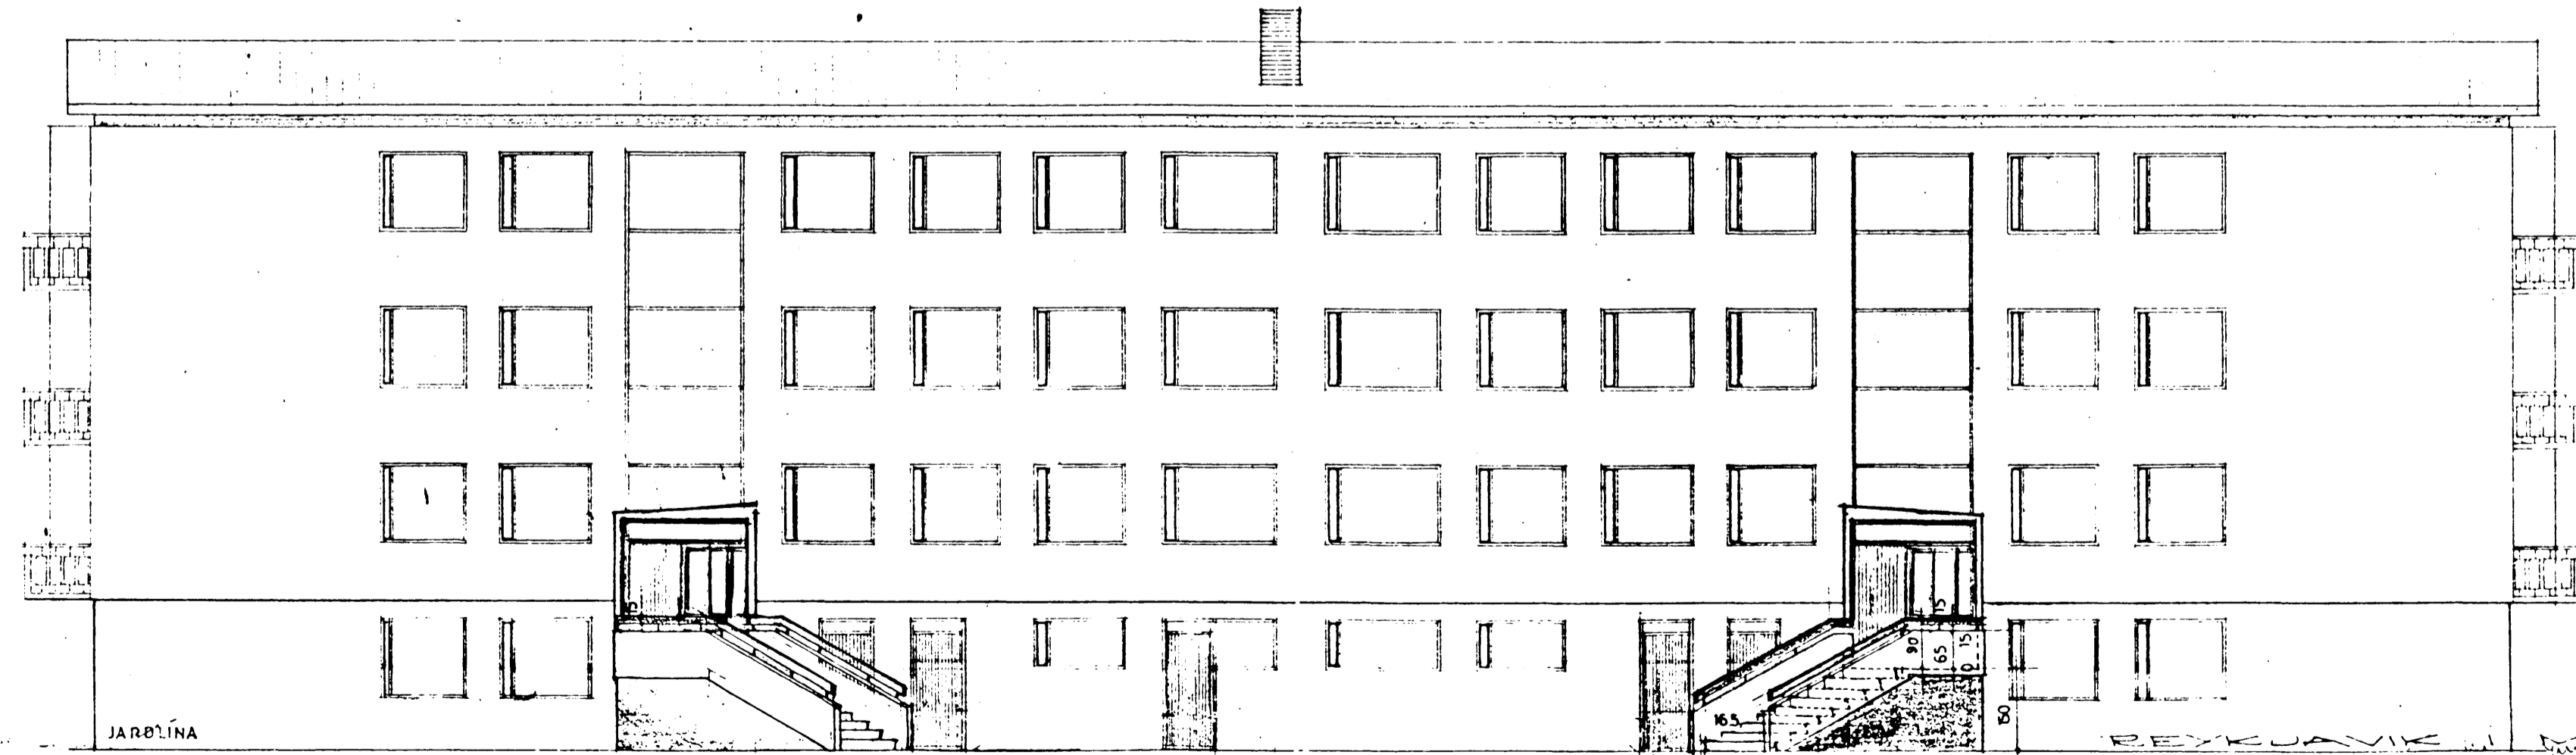

JARÐLÍNA

AUSTUR

TRÖPPUR TEIKN. Í SEPT. 1968  
ÖHALL ARKT. FAI.

5 OKT. 1999.

LITLA  
TEIKNISTOFAN  
220 Hafnarfjörð

Baldur Frithofsson  
Eiríkur Guðmundsson

617

Óli G. L. Þóðarsson  
ARKT. FAI.