


Fyrsti áfangi

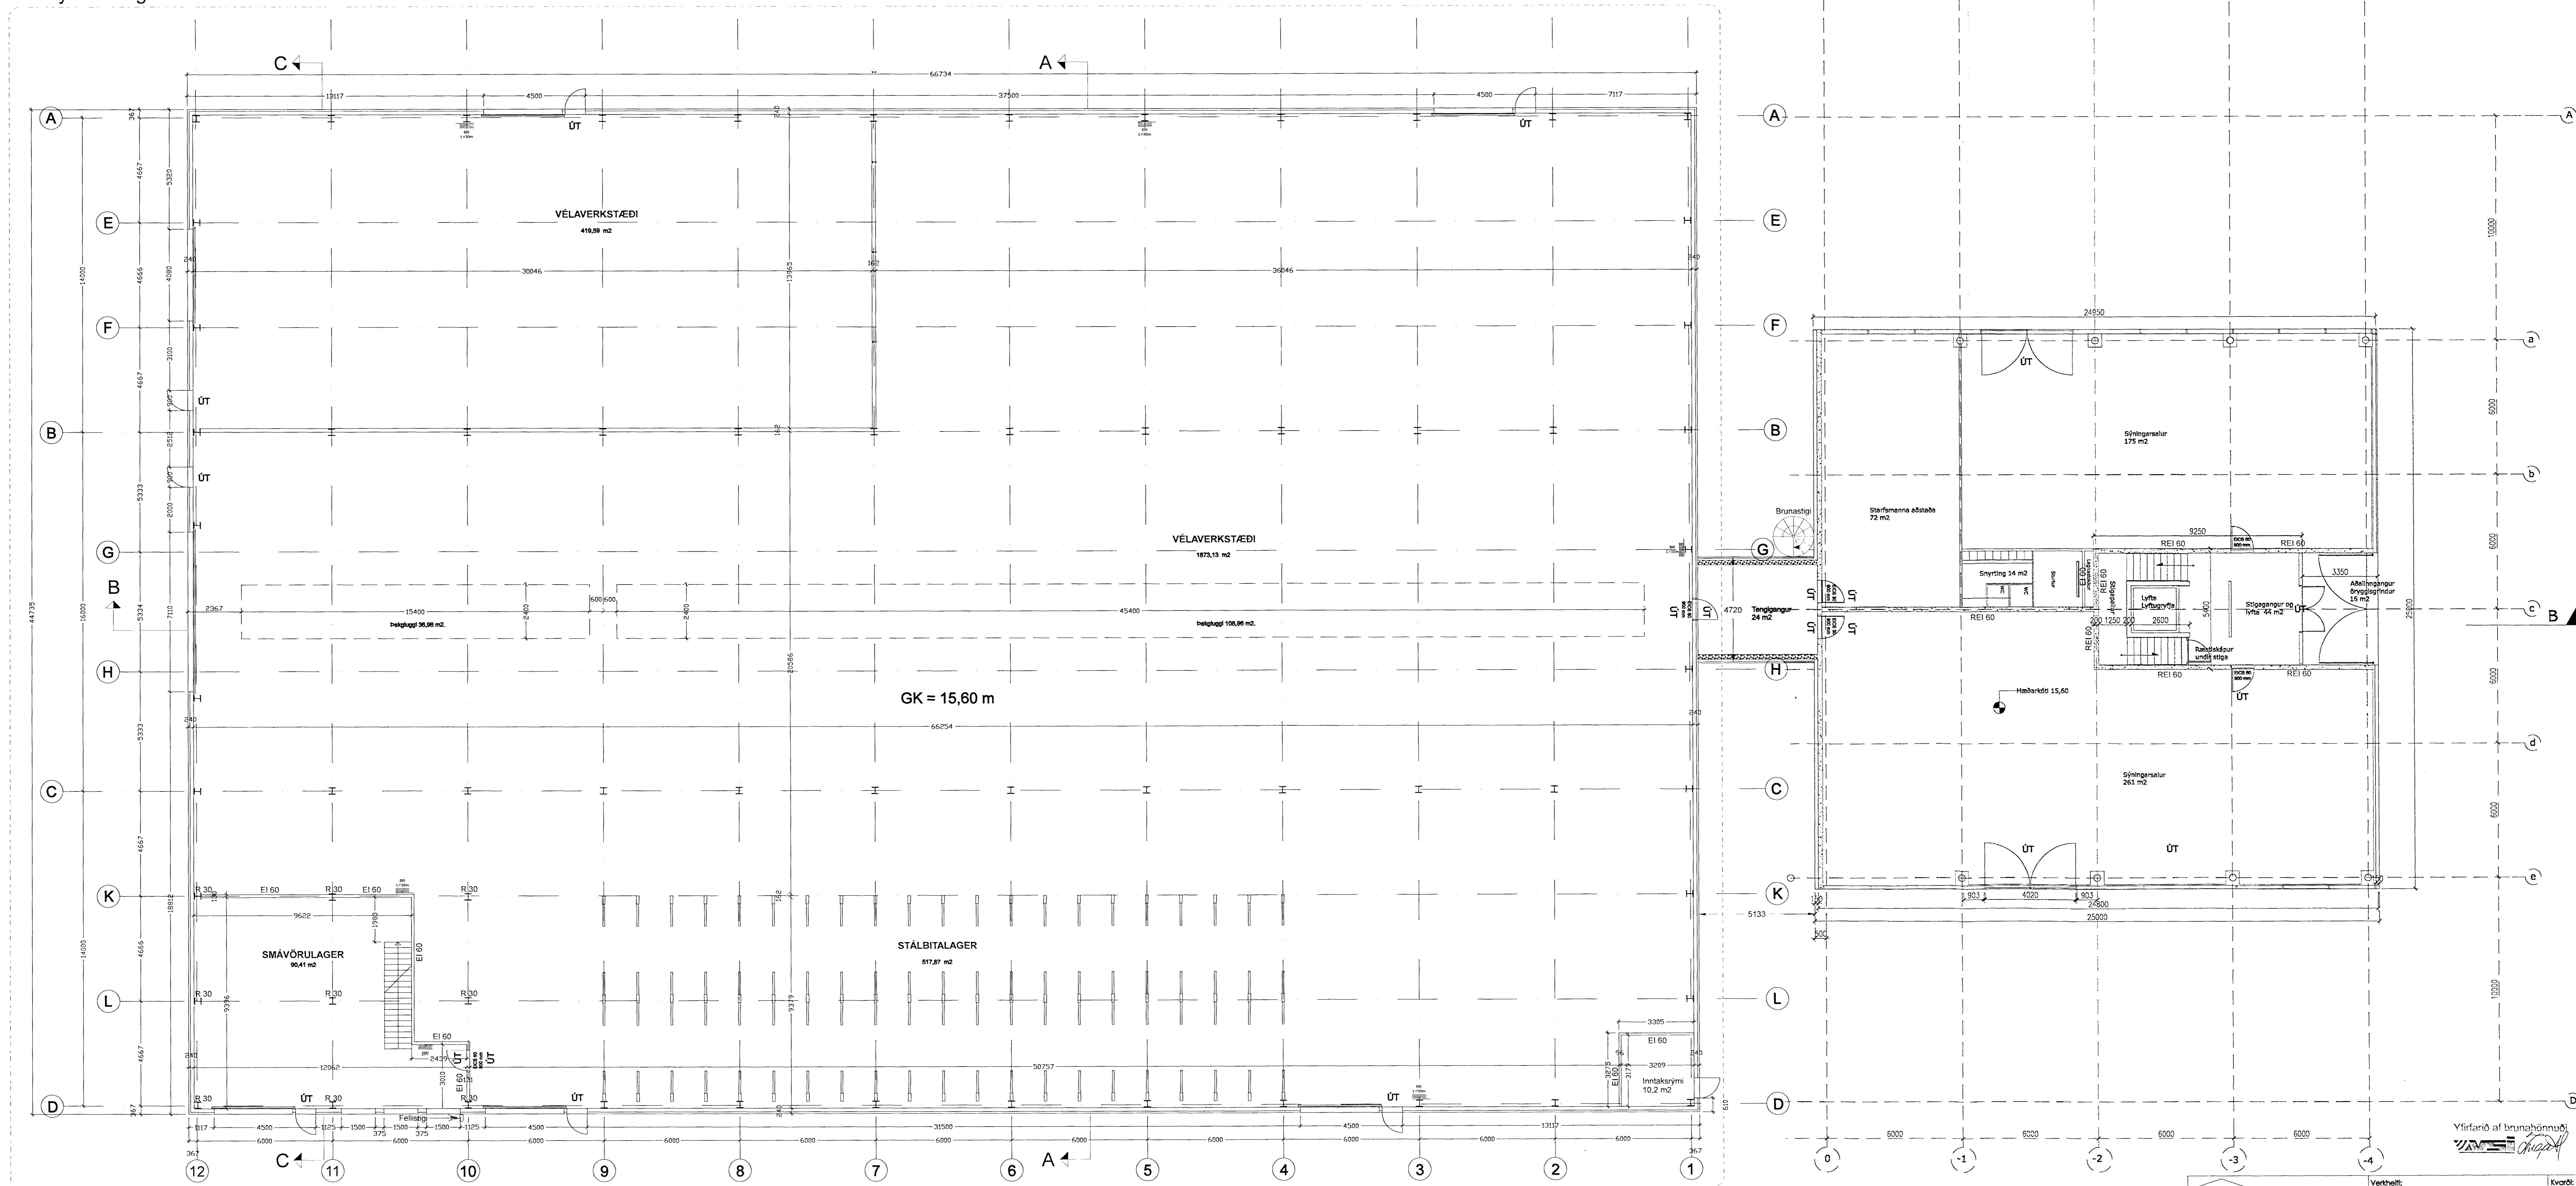

EUROstál ehf Sundaberg 5, 104 Reykjavík, Símar: 517 0335 / 618 3300, e-mail: stolar@eurostal.is		Verkefni: Áhella 3, Hafnarfrétt	Kvarði: 1:100
Telning: Reyndartekning af Lager / verktæðarymum og skrifstofum. Brúviti:		Undirskrift: Kjartan Rafnsson tekiðnfr. E.T. 200330 2189	Telning: Nr. 101
Telning: KR	Dagsetning: 25.05.2010	Verk nr.:	

E.Á. Sigurður Stinson Arnarson