



NEYSLUVATN RÚMMYND

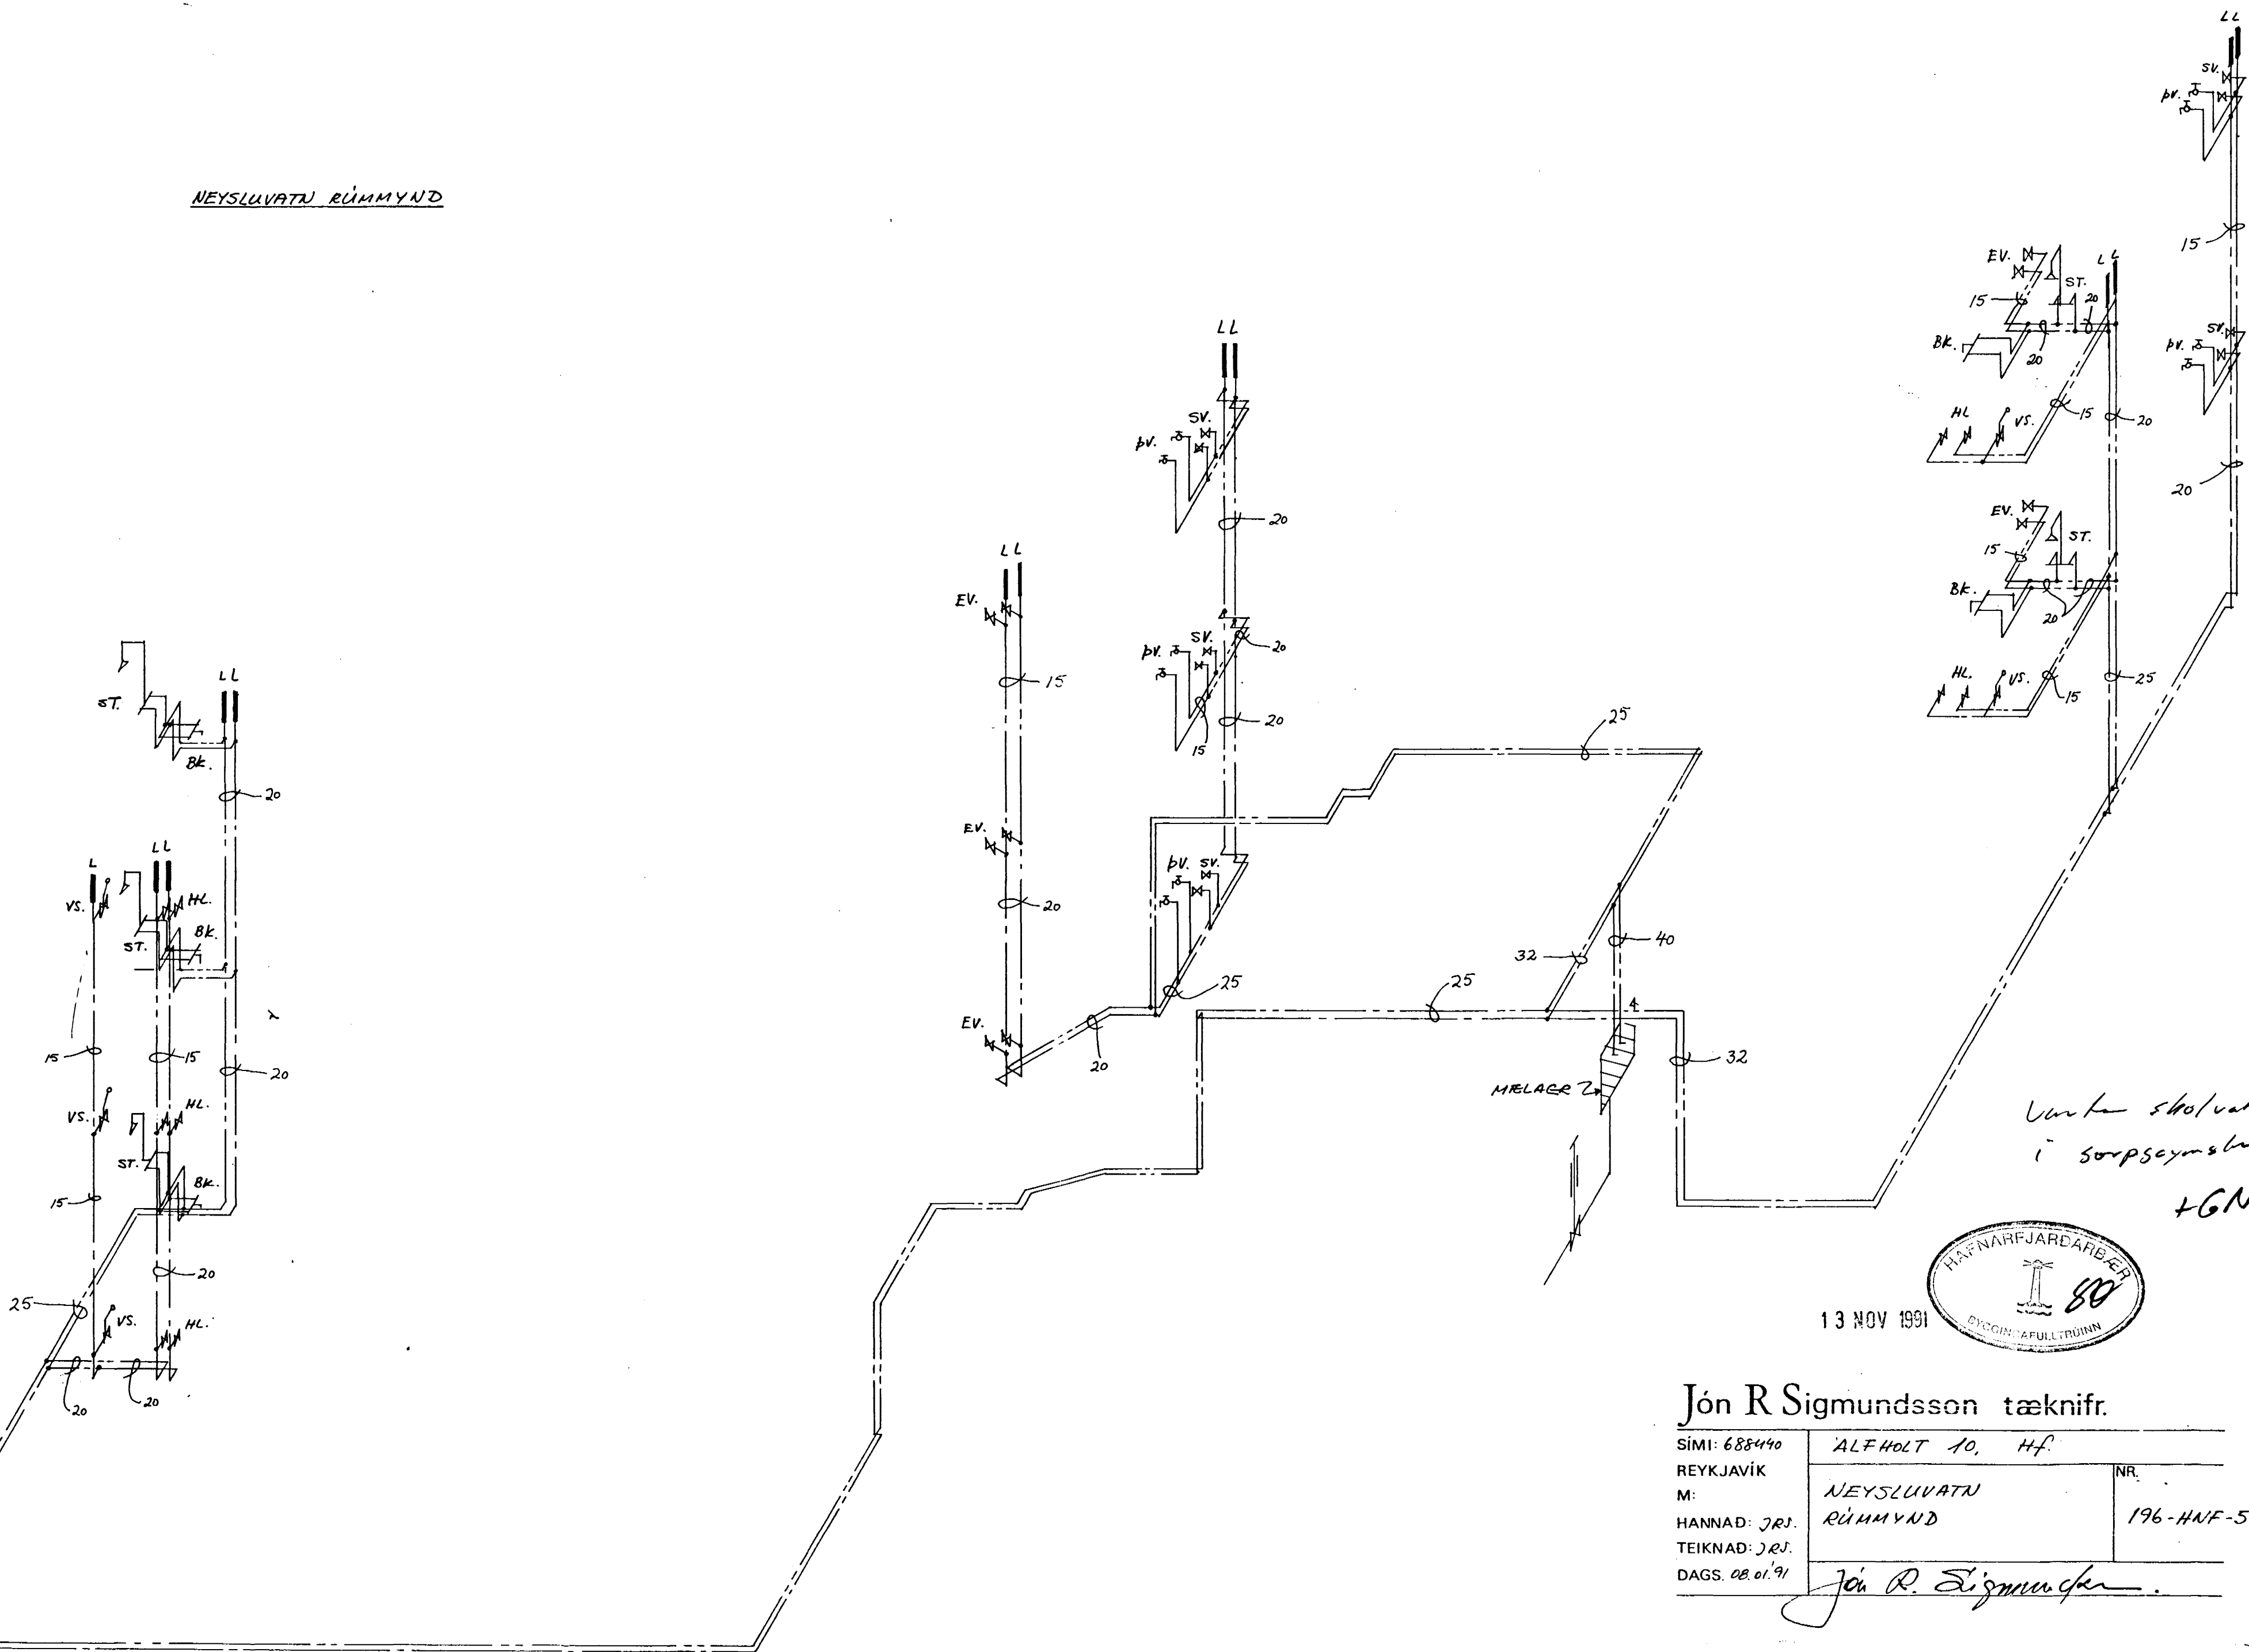

Umfar skilvakt  
í soppseymsla  
+GN.

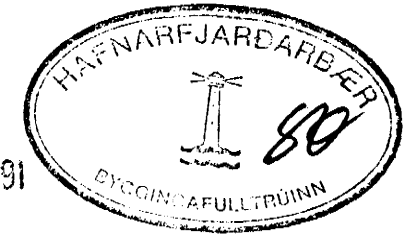

13 NOV 1991

Jón R Sigmundsson tæknifr.

SÍMI: 688440	ALFHOLT 10, HF.	
REYKJAVÍK		
M:	NEYSLUVATN	NR.
HANNAD: J.R.J.	RÚMMYND	196-HNF-5
TEIKNAD: J.R.J.		
DAGS. 08.01.91	Jón R. Sigmundsson	