
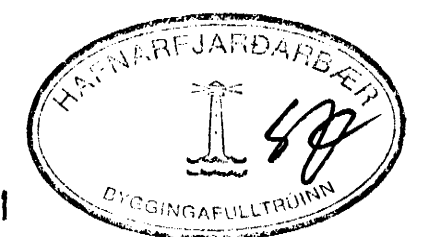


NEYSLUVATN RÚMMYND

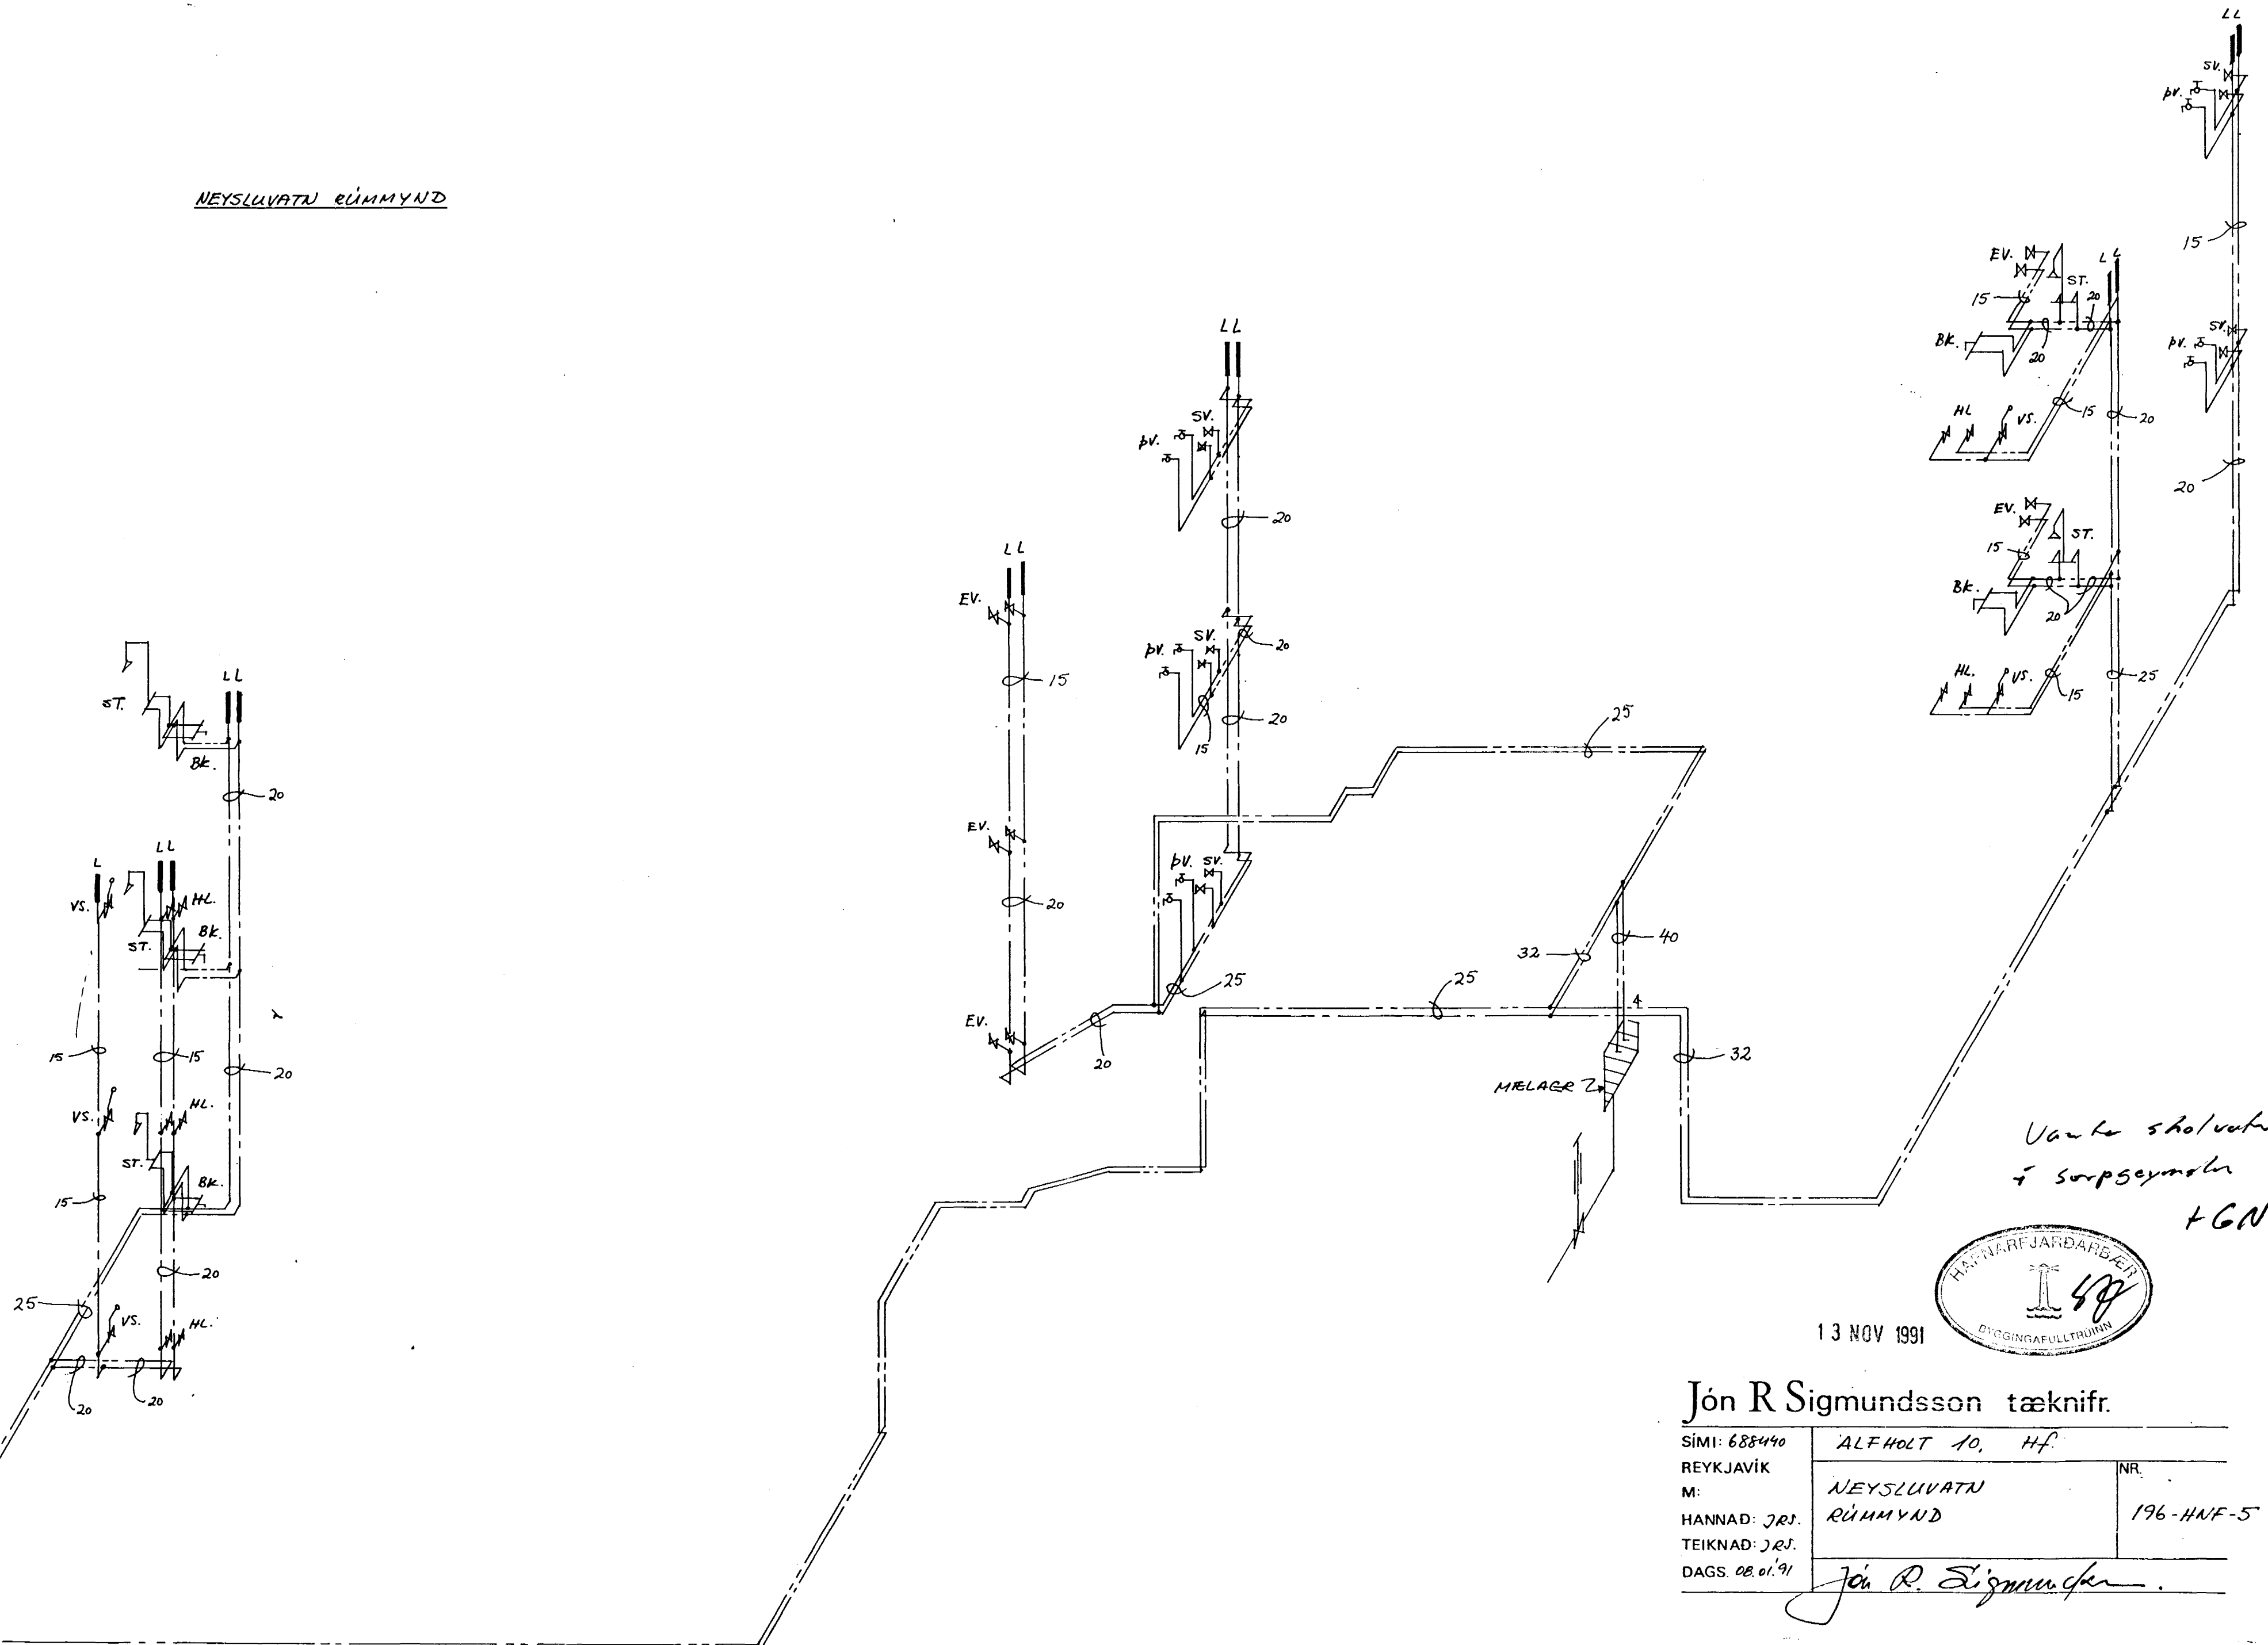

13 NOV 1991

Jón R Sigmundsson tæknifr.

SÍMI: 688440	ALFHOLT 10, HF.	NR.
REYKJAVÍK	NEYSLUVATN	196-HNF-5
M:	RÚMMYND	
HANNAD: JRS.		
TEIKNAD: JRS.		
DAGS: 08.01.91	Jón R. Sigmundsson	