




HITI I FLAN
Ø 32 PEH 2 STK.

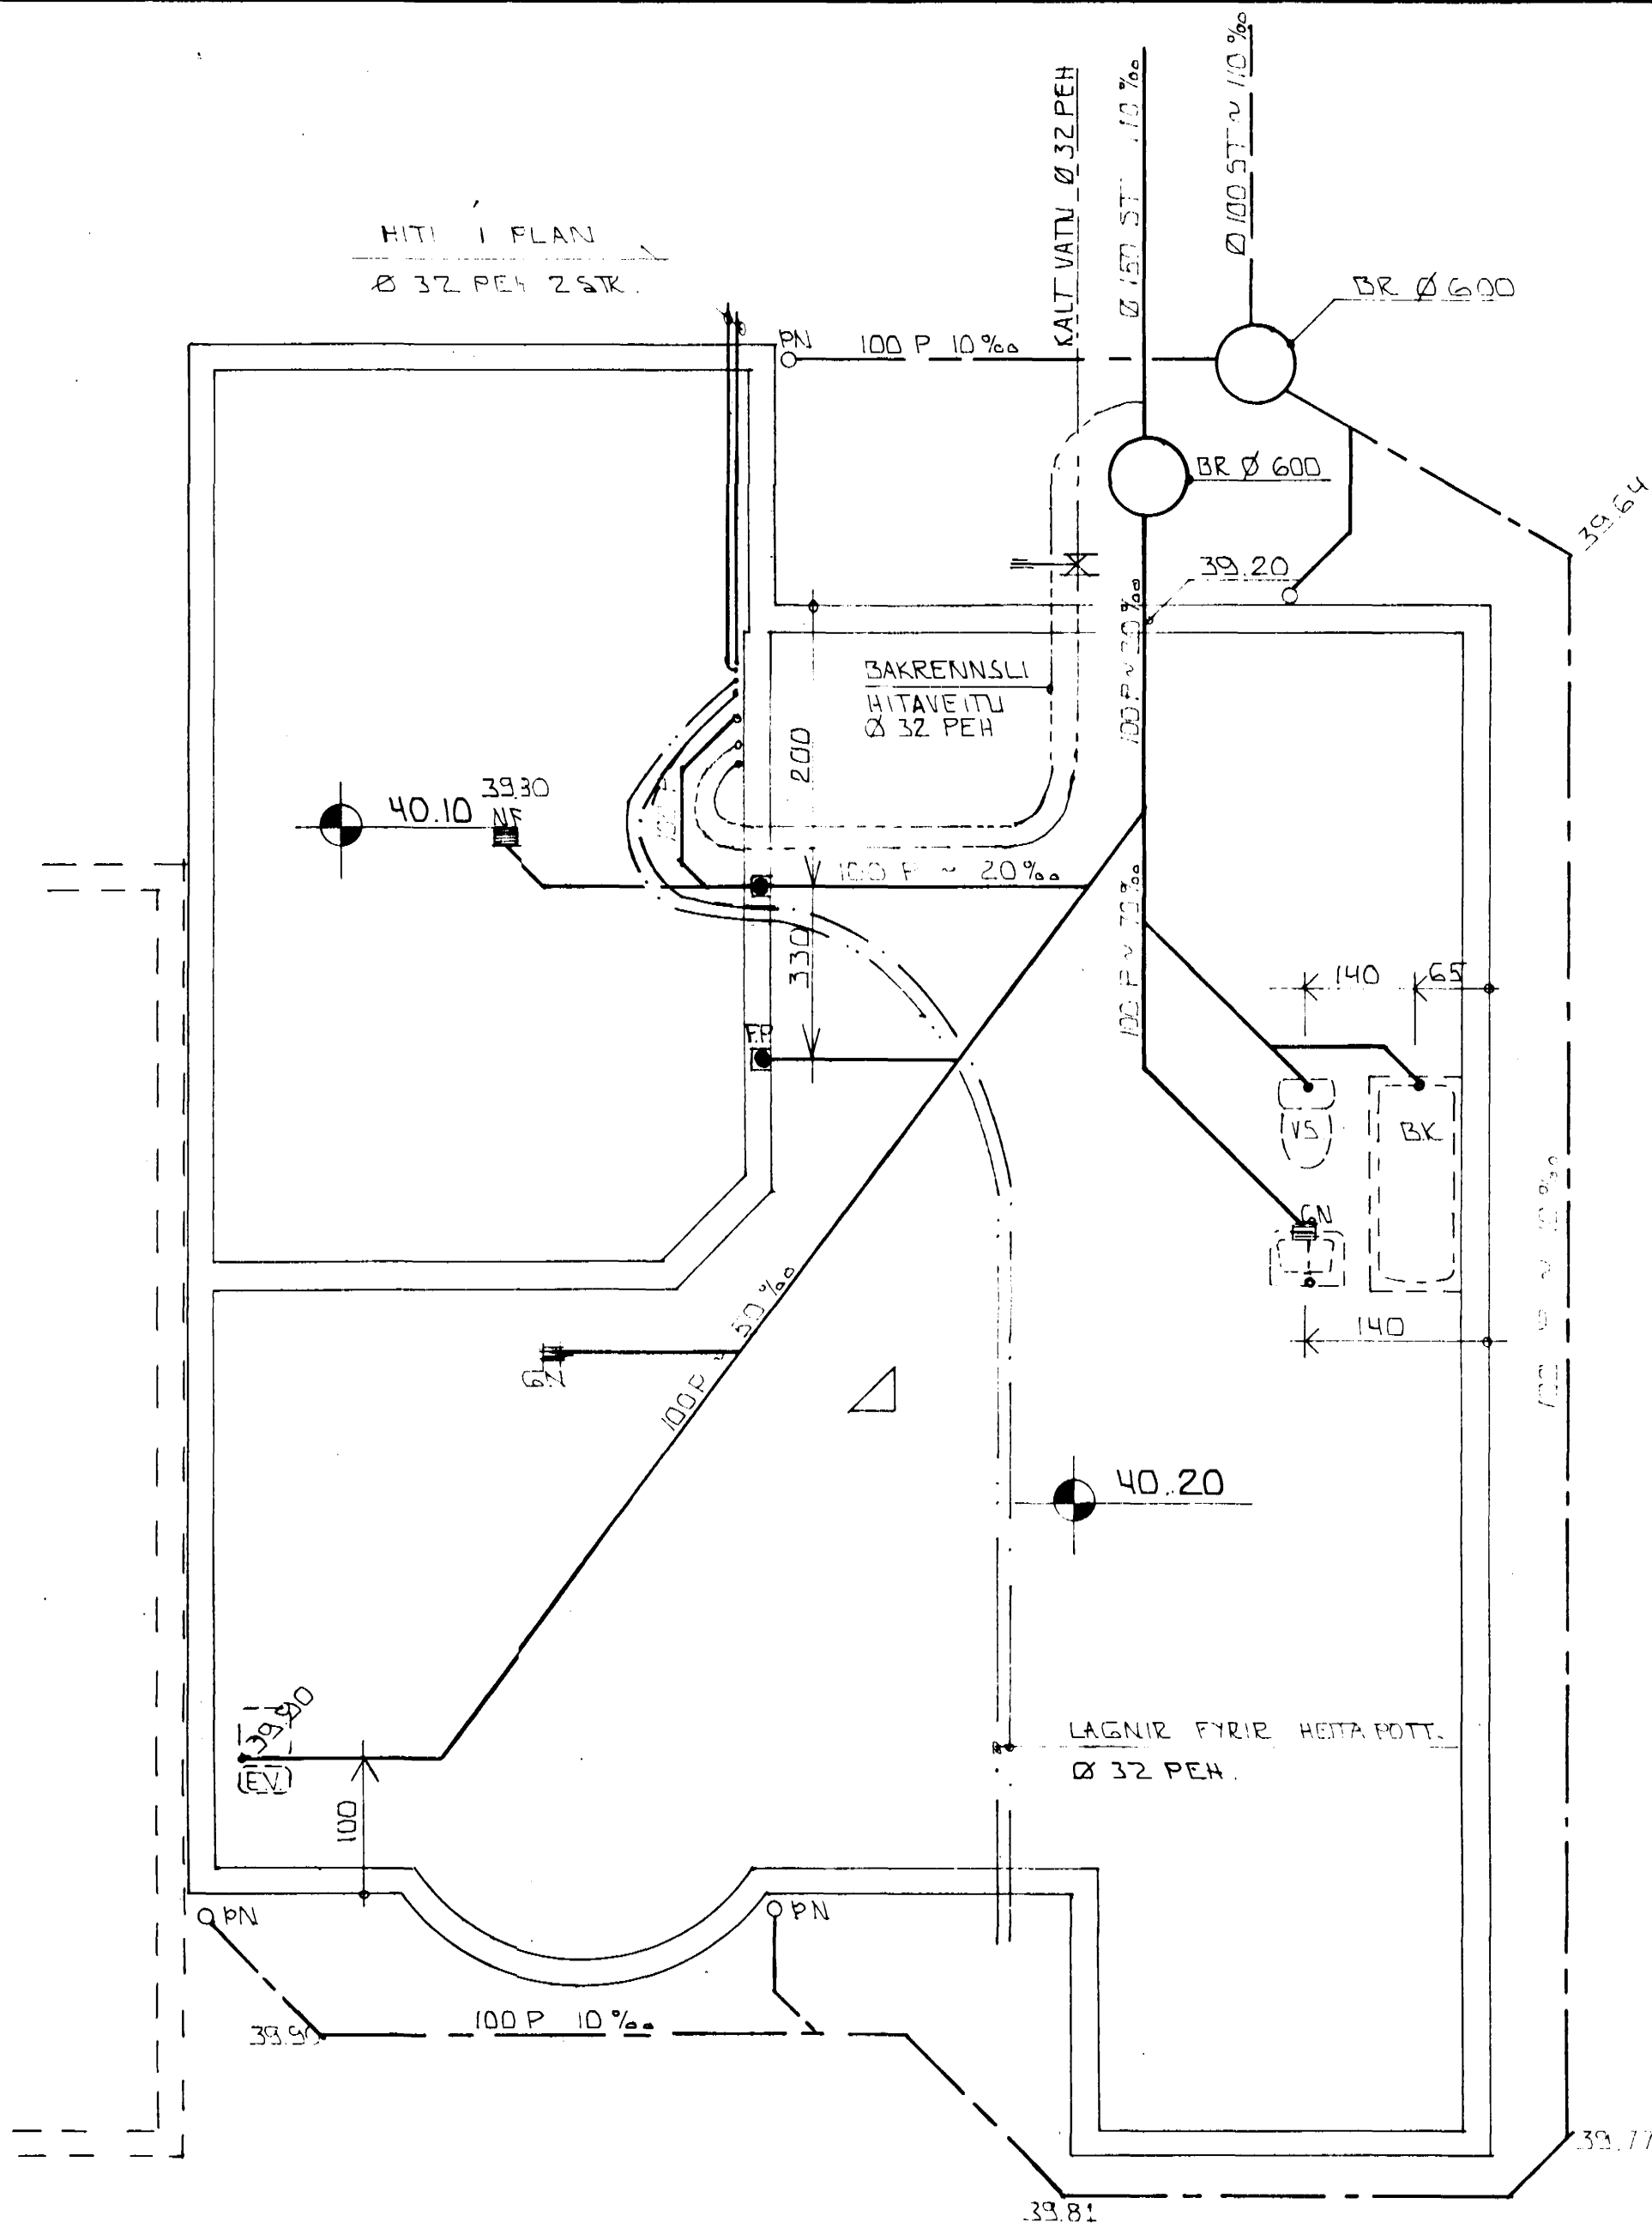

GRUNNMYND \times 1:50

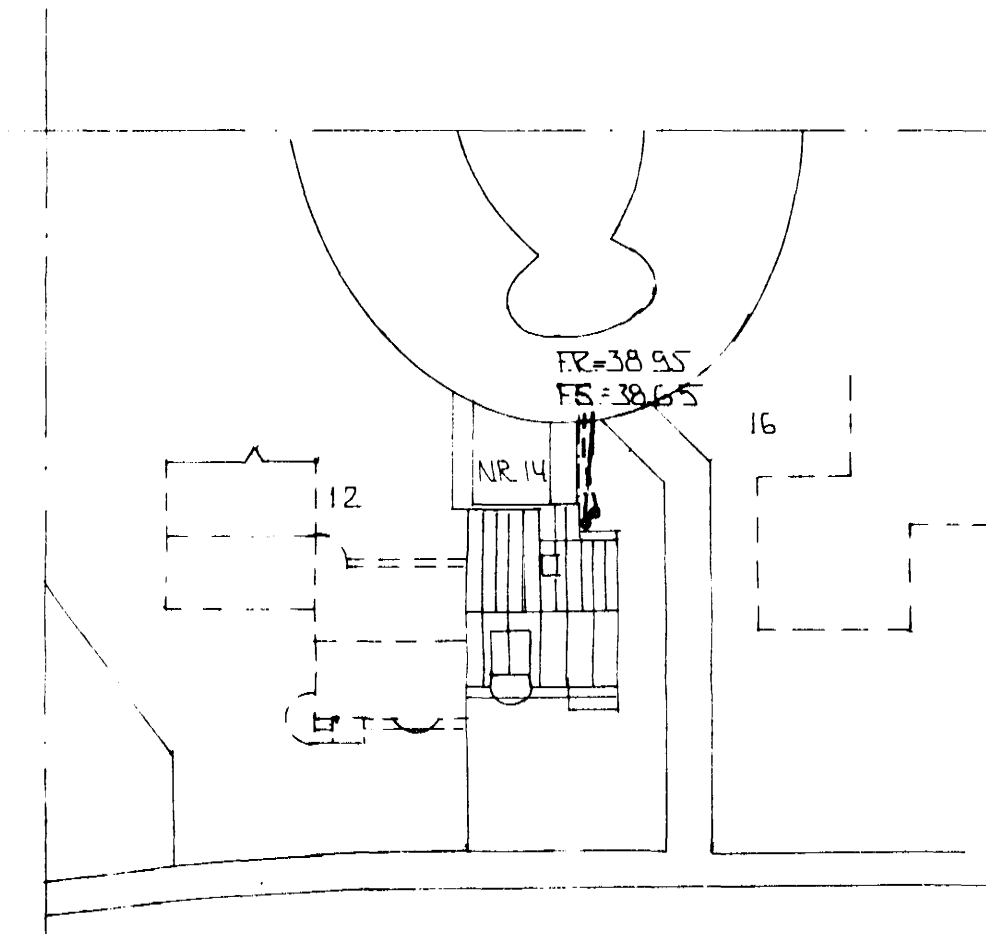

AFSTÖÐUMYND \times 1:500

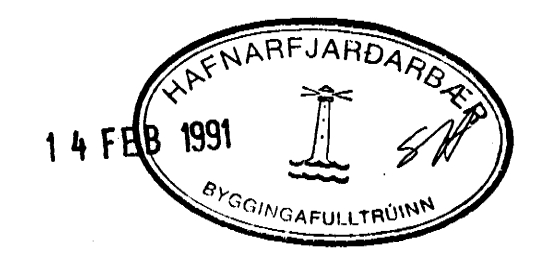

DR NR.	17.02.91	GN BÆTT VED	LAGNIR Í Ø 32 PEH.	SIGN.
DR NR.	DAGS	EDLI	BREYTINGAR	SIGN.
ÁLFHOLT 14 HAFNARFIRÐI GRUNNMYND - GRUNNLAGNA \times 1:50 AFSTÖÐUMYND \times 1:500 MÆLIKV. \times 1:50 \times 1:500				DAGS JÚN 90 HANNAÐ TEIKNAD VERK NR 9021
SIGURÐUR ÞORLEIFSSON STRANDGÖTU 11 HAFNARFIRÐI SÍMI 54751				BLADNR. 2-02