


AFSTÖÐUMYND 1:500

SKÝRINGAR:

ALMENNAR SKÝRINGAR SJÁ BL. NR. 2-01.

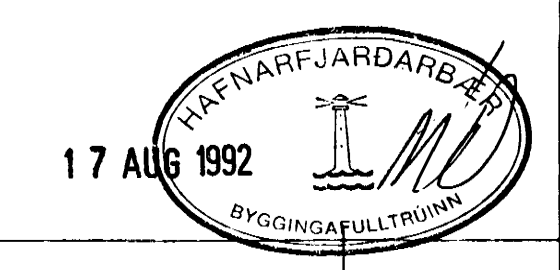

02	08 '92	INNTAK HV. FÆRT BETT VED GUF. OG HALLA A LÖSGUMMAD STÖRUM	
01	3.6 '92	BETT VED SV. GN OG PV.	
BR NR	DAGS	EDLI BREYTINGAR	SIGN.
'ALFHOLT 20 HAFNARFIRDI			DAGS MAÍ '92
GRUNNMYND GRUNNLAGNA.			HANNAÐ 4/21
			TEIKNAD 30
			VERK NR 9219
MÆLIKV. SIGURÐUR ÞORLEIFSSON TEKNIFRÆÐINGUR F.T.F.I.			BLAD NR 2-02
STRANDGÖTU 11 HAFNARFIRDI Sími 54751/54255			