


GRUNNMÝND. 1:50

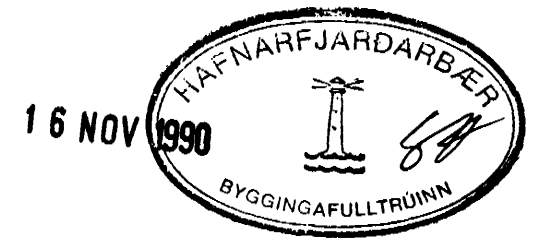

1	15.11.90	LEGU LAEVA BREYTT	g.z.
BR NR.	DAGS	EDLI BREVTINGAR	SIGN.
ÁLFHOLT 2B HAFNARFIRÐI			DAGS OKT. 90
GRUNNLAGNIR			HANNAS 42
MÆLIKV. 1:50			TEIKNAD 90
SIGURÐUR ÞORLEIFSSON TEKNIFRÆÐINGUR F.T.F.I.			VERK NR. 9033
STRANDGÖTU 11 HAFNARFIRÐI SÍMI 54751/54255			BLAD NR. 2-02