


RUMMYND HITLAGNA 1:50

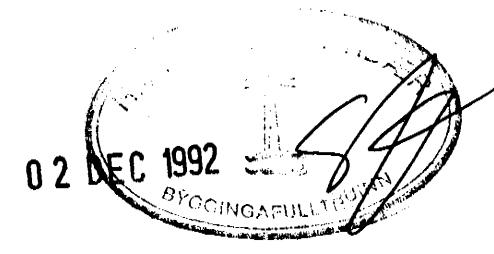

02	27.11.92	OFNIM OG LEGULLAGNA BR I ITSLIS A	GH
0	13.11.92	LESL 14914 3PP	
BR NR	DAGS	EFLI BREVINGAR	SKEN
'ALFHOLT 3D HAFNARFREDI			DAGS MARS 92
IBUDIR A OG B			ANNA
RUMMYND HITLAGNA			FEK 11
MELIKV. 1'50			VERK 11
SIGURDUR BORLEIFSSON TEKNEREINING FITEI			9167
STRANDGOTO 11 HAFNARFREDI SIMI EFTEL/54255			2-07