



GRUNNMÝND 1 : 50

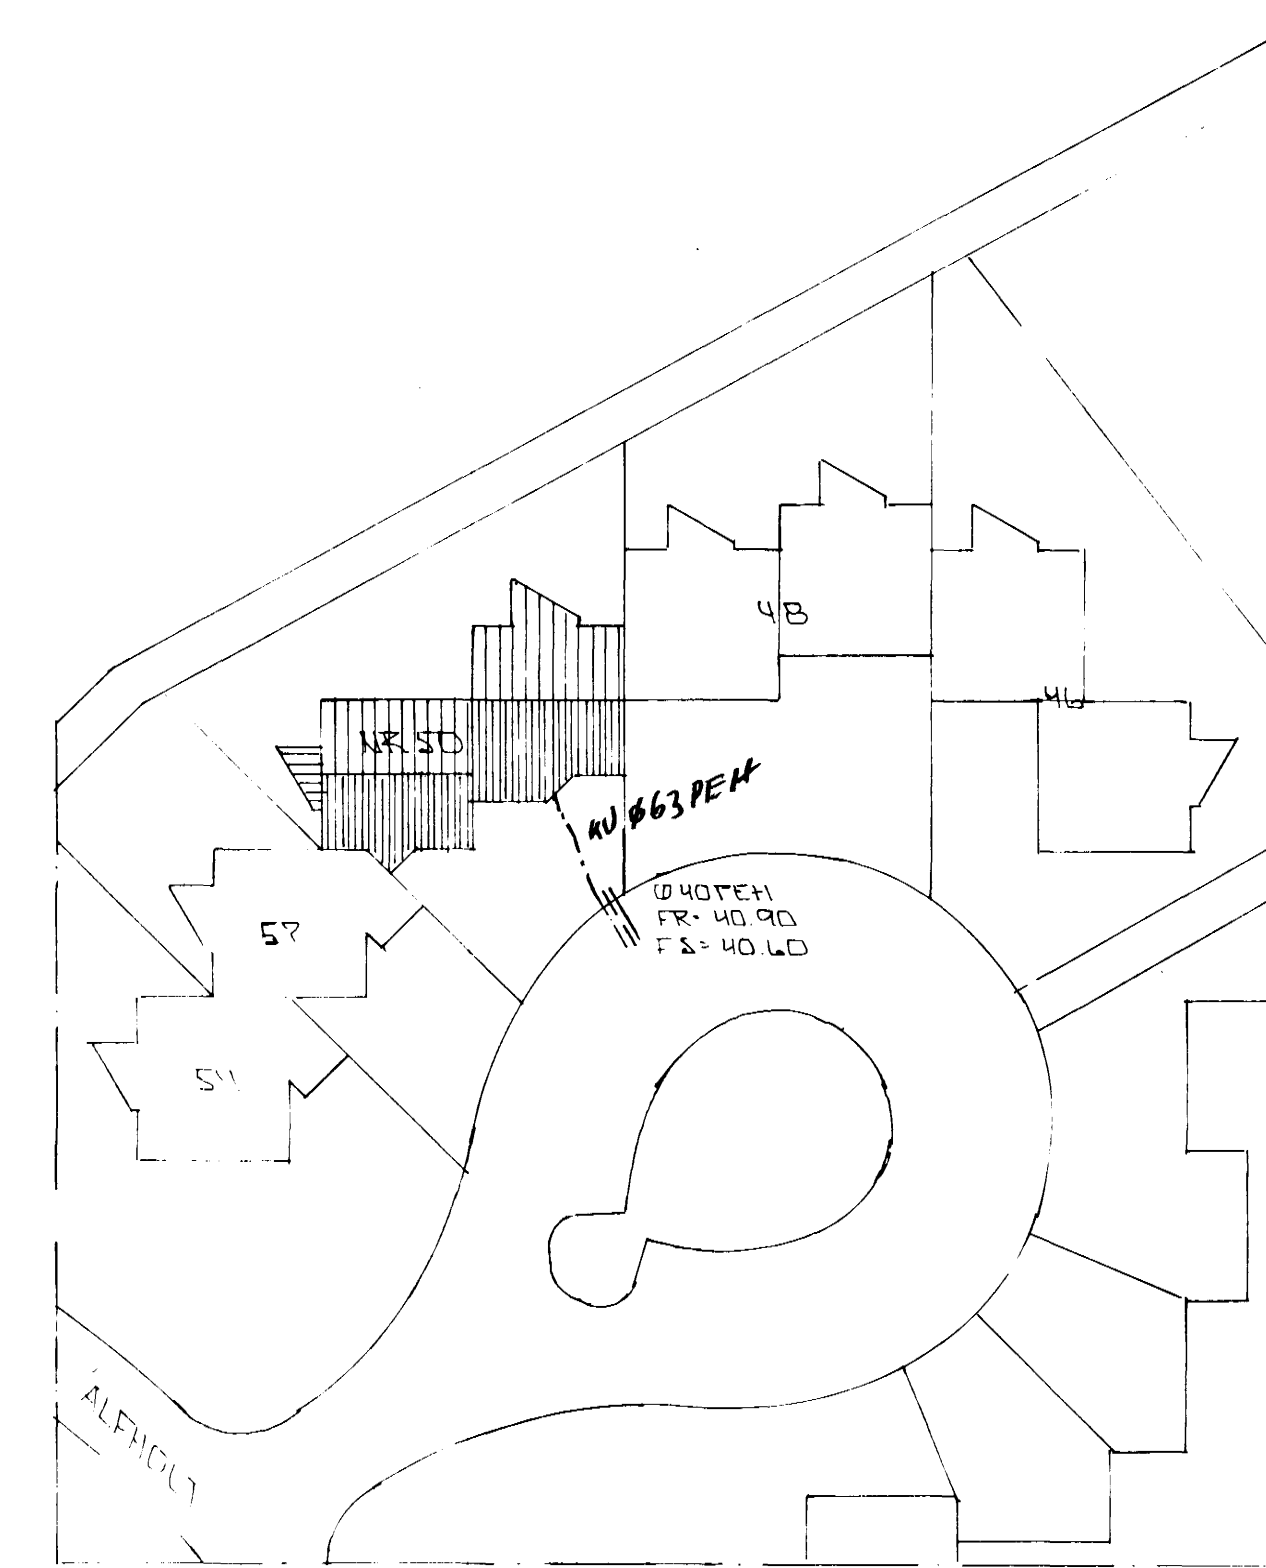

AFSTÖÐLÝMÝND 1 : 500

01 DES. 1995

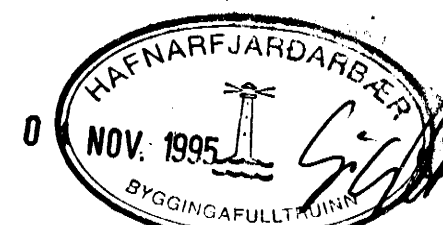

01 DES. 1995

SKÝRINGAR

ALMENNAR SKÝRINGAR SÖX BL. NR. 2-01.

BR.	DAGS.	EDLI BR.	SIGN.
ALFHOLT SD HAFNARFIRÐI			
GRUNNMÝND - GRUNNLAGNA AFSTÖÐLÝMÝND			
NKJ 1 : 50 1 : 500			
DAGS			
VERK NR. 9536			
TEIKN NR. 2-02			
HANNAD			
TEIKNAD NOV 1995			
YFIRFARID			
<b>ISP</b> TÆKNIJÓNUSTA SIGURDAR ÞORLEIFSSONAR HF			
STRANDGÖTU 11 - 220 HAFNARFJÖRÐUR - SIMI 54255 - FAX 652875			