




GRUNNMÝND 1:50

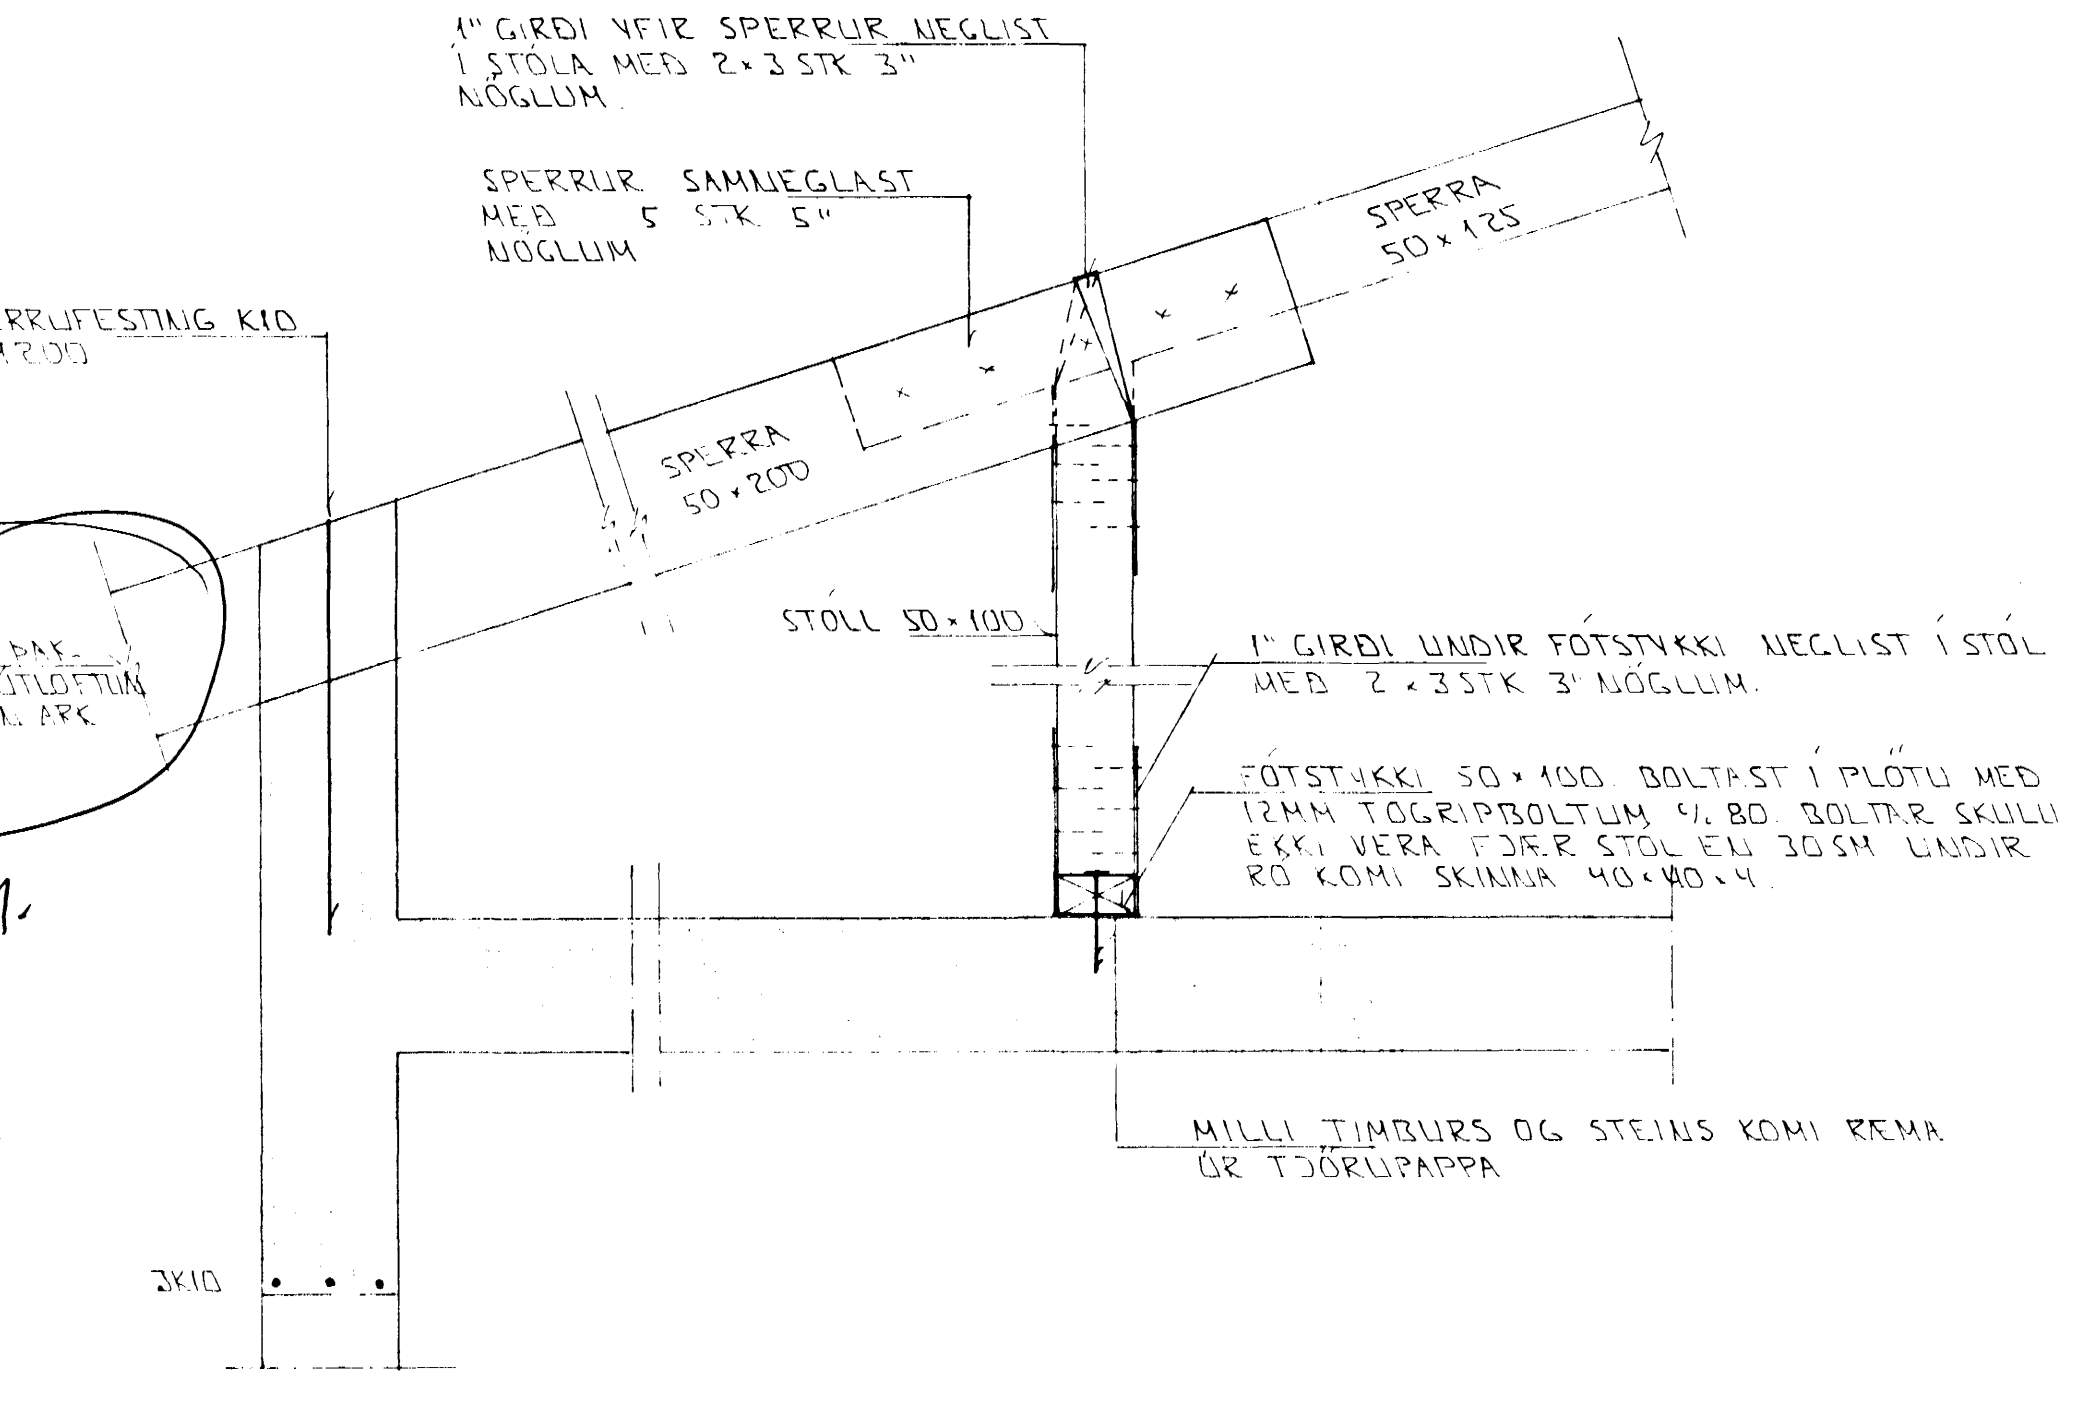

SNID 11-11 1:10

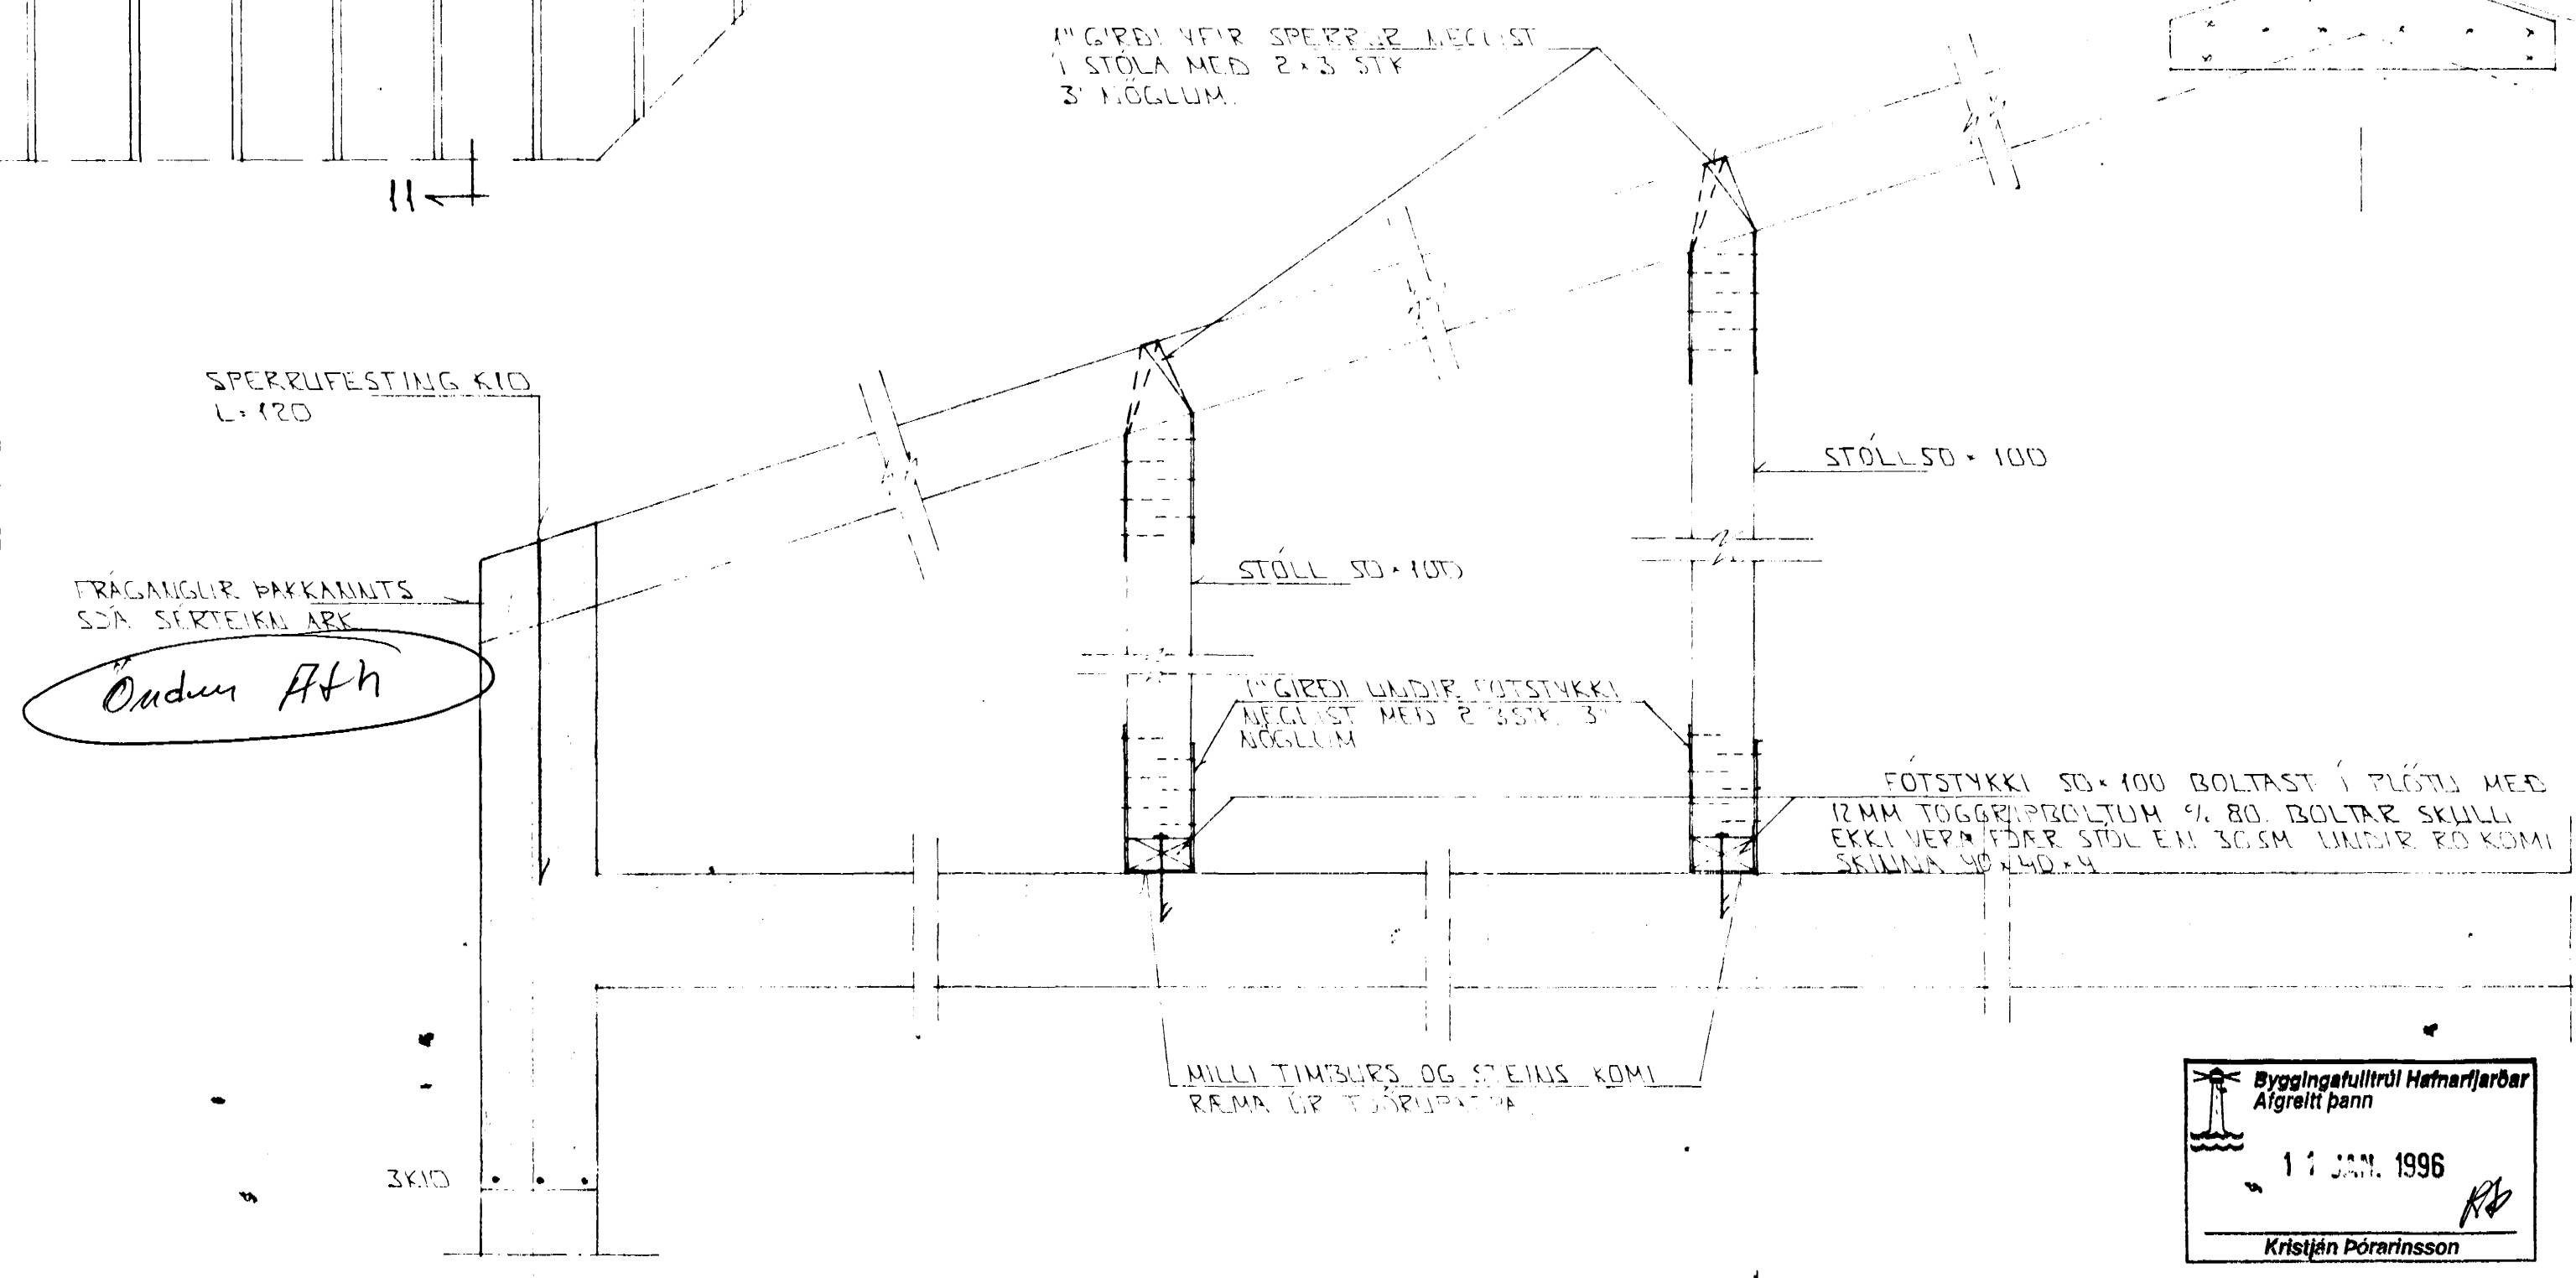

SNID 10-10 1:10

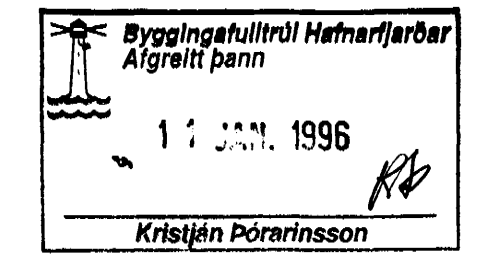

SKÝRINGAR

SNID 7-7 OG 8-8 SÁ Á BL. NR. 1-05.

BR.	DAGS.	EDLI BR.	SIGN.
ÁLFHOLT 50 HAFNARFIRDI			
ÞAKVIRKI - GRUNNMÝND - SNID			
UKV. 1-50	1-10		
DAGS.	DES '95		
VERK NR.	9536		
TEIKN NR.	1-05		
ÞANNAD			
TEIKNAD	gth		
VIÐRÆÐ			

TÆKNIÞJÓNUSTA
SIGURDAR ÞÓRLEIFSSONAR HF