


GRUNNMÝND 1:50

SKÝRINGAR

ALMENNAR SKÝRINGAR SJÁ BL. NR. 2-01.

10 JUL 1991

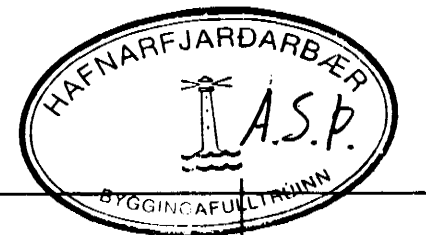

01	9.07.91	KOTI A SKOLPBRUNN	
BR.NR.	DAGS	EDLI BREVINGAR	SIGN.
ÁLFHOLT 54 HAFNARFIRÐI			DAGS JÚNÍ '91
GRUNNMÝND - GRUNNLACNA			HANNAÐ 9.11
AFSTÖÐUMÝND			TEIKNAD GA
MÆLIKV. 1:50 ~ 1:500			VERK NR. 9131
SIGURÐUR ÞORLEIFSSON TEKNIFRÆÐINGUR F.T.F.Í.			BLADNR. 2-02
STRANDGÖTU 11 HAFNARFIRÐI SÍMI 54751/54255			