


erun Samþykkt
 56A Svandís Þórsdóttir
 56A Þröstur Hjaltason
 56C Þorsteinn Lárusson
 56C Andrés Adalsteinsson
 56C Erla Órskótt
 56C Hjörtur Hafsteinsson
 56C Laufi Baldvinsson
 56C Berglind Guðm.
 56C Jónína
 56C Sigrún Þorjónsdóttir
 56C Stumpfonsdóttir
 56C Valgerður Guðjónsd.
 56C 001 Þorsteinn Hjaltason
 56C 0103 Þorsteinn Hjaltason
 56B Jón Ísgrí Geirsson
 56D Sigrún Þorjónsdóttir
 56D Halla Sigrún Amadóttir
 56D Sveinn Þorhálfsson

VIKTORSSON & NUSTI
 F. A. LAGMULA
 pr. Björgun hf.
 Kt. 480169-7399
 56D-202

HUSASMÍÐJANAFIR
 Kt. 520171-0299
 56B-01-02
 56D 0103
 56 B 2,0104



SUB - VESTUR HLIÐ

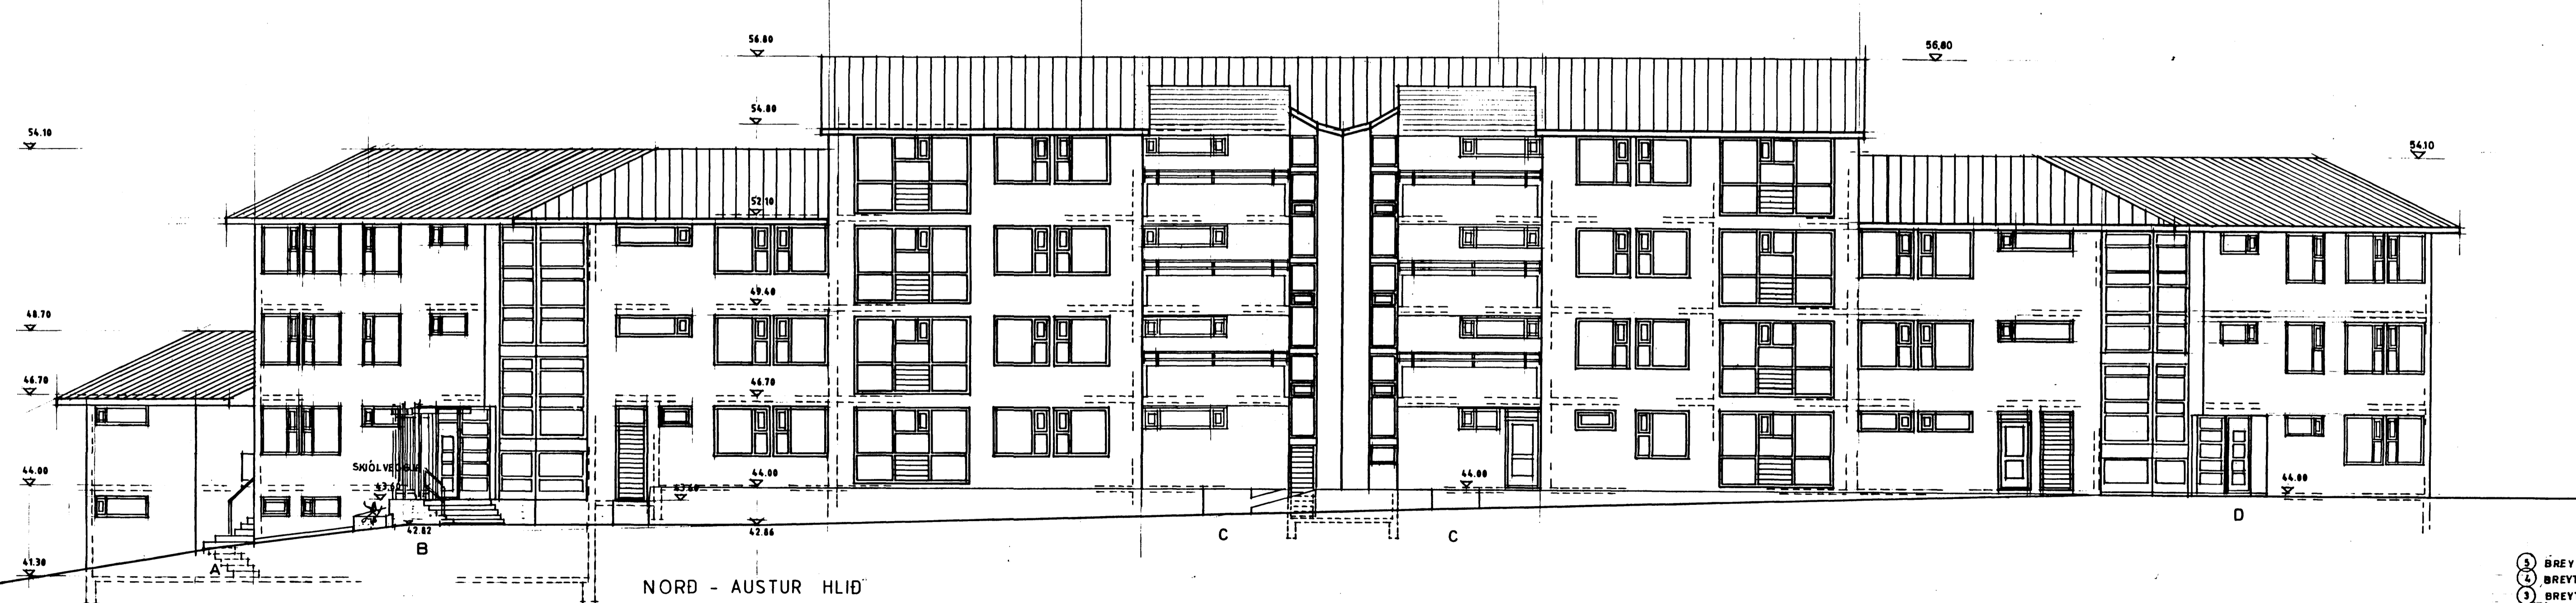

NORD - AUSTUR HLIÐ

- ③ BREYTT 22.8.93 ÚTITRÖPPUR B
- ④ BREYTT 18.10.90 GLUGGAR, NIÐURF.
- ③ BREYTT 8.10.90 SVLAHANDRIS
- ② BREYTT 21.9.90 GLUGGAR
- ① BREYTT 25.5.90, ÆTTI INN KÓTUM

ÁH ALFHOLT 56
 HAFNARFIRDI

UTLITSMYNDIR
 M. 1: 100