


Burðarvirki hússins er reist úr forsteyptum byggingareiningum frá Loftorku, og miðað við stóðluð frágangsdæli framleiðandans. Þrjár útveggir hússins eru berandi, þeir eru steypar samlökueiningar, innra byrði er 180mm þykkur burðarveggur, ytra byrði er 70mm veðurkápa, milli byrðanna er 100mm plasteinangrun. Sá útveggur hússins sem snýr að steypuskálanum er létt-byggður, burðargrind úr stáli eða timbri, fyllt með 100mm steinull, klædd að utan (sementsbundnum) Viroc-plötum, að innan klædd með tvöföldu lagi af gipsplötum.

1 SKURÐUR AA
 mkv. 1:50

2 DEILI – ÞAKBRÚN, GLUGGAÍSETNING / EFRÍ BRÚN OG LÓÐRÉTT HLIÐ / NEÐRI BRÚN
 mkv. 1:5

Skýringar:
 Legend:

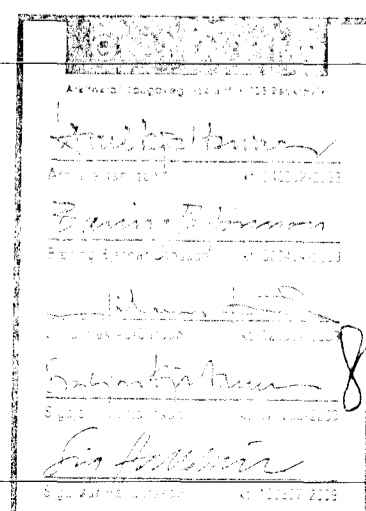

A	As Built	07.03.2012	SK	SK
Úp nr	Lýsing	Dagsetning	Han/Tin	Yfir
Rev no	Description	Date	Des/Draw	Chk
			Noek heim	Noek heim
			Suppl Rel	ISAL Rel

This drawing is the property of Rio Tinto Alcan Iceland Ltd and handed out for personal use only. It may neither be copied nor made available to others without permission of Rio Tinto Alcan Iceland Ltd. The receiver is liable for any misuse. Dimensions without tolerances according to ISO 2768-1 medium.



Dagsetning / Date
 15.04.2011
 Hannað / Designed
 SK/BBJ
 Teikn / Drawn
 KA/BBJ
 Verktaki / Supplier
 GLÁMA-KIM
 Teikn nr / verktaka / Supplier draw no.
 21.03
 Samþykkt / Approved
 Yfir / Chkd
 SK



Teikn nr / Yfir / Chkd
 21.03
 SK

STEYPUKÁLI, ÞJÓNUSTUBYGGING
 SNEIÐING / DEILI

BYGGINGARUPPDRÁTTUR
 Architectural Construction Drawing

RioTintoAlcan

Flokkur nr.:	Blað nr.:	Næsta bl. nr.:
6010	16963	
Kostn. nr.-Cono. / Búnr.-Eq.no	AKS	ISAL Teikn nr. ISAL/Draw no. of ISAL
	LUL	Breyt./Rev.
	256858	A