

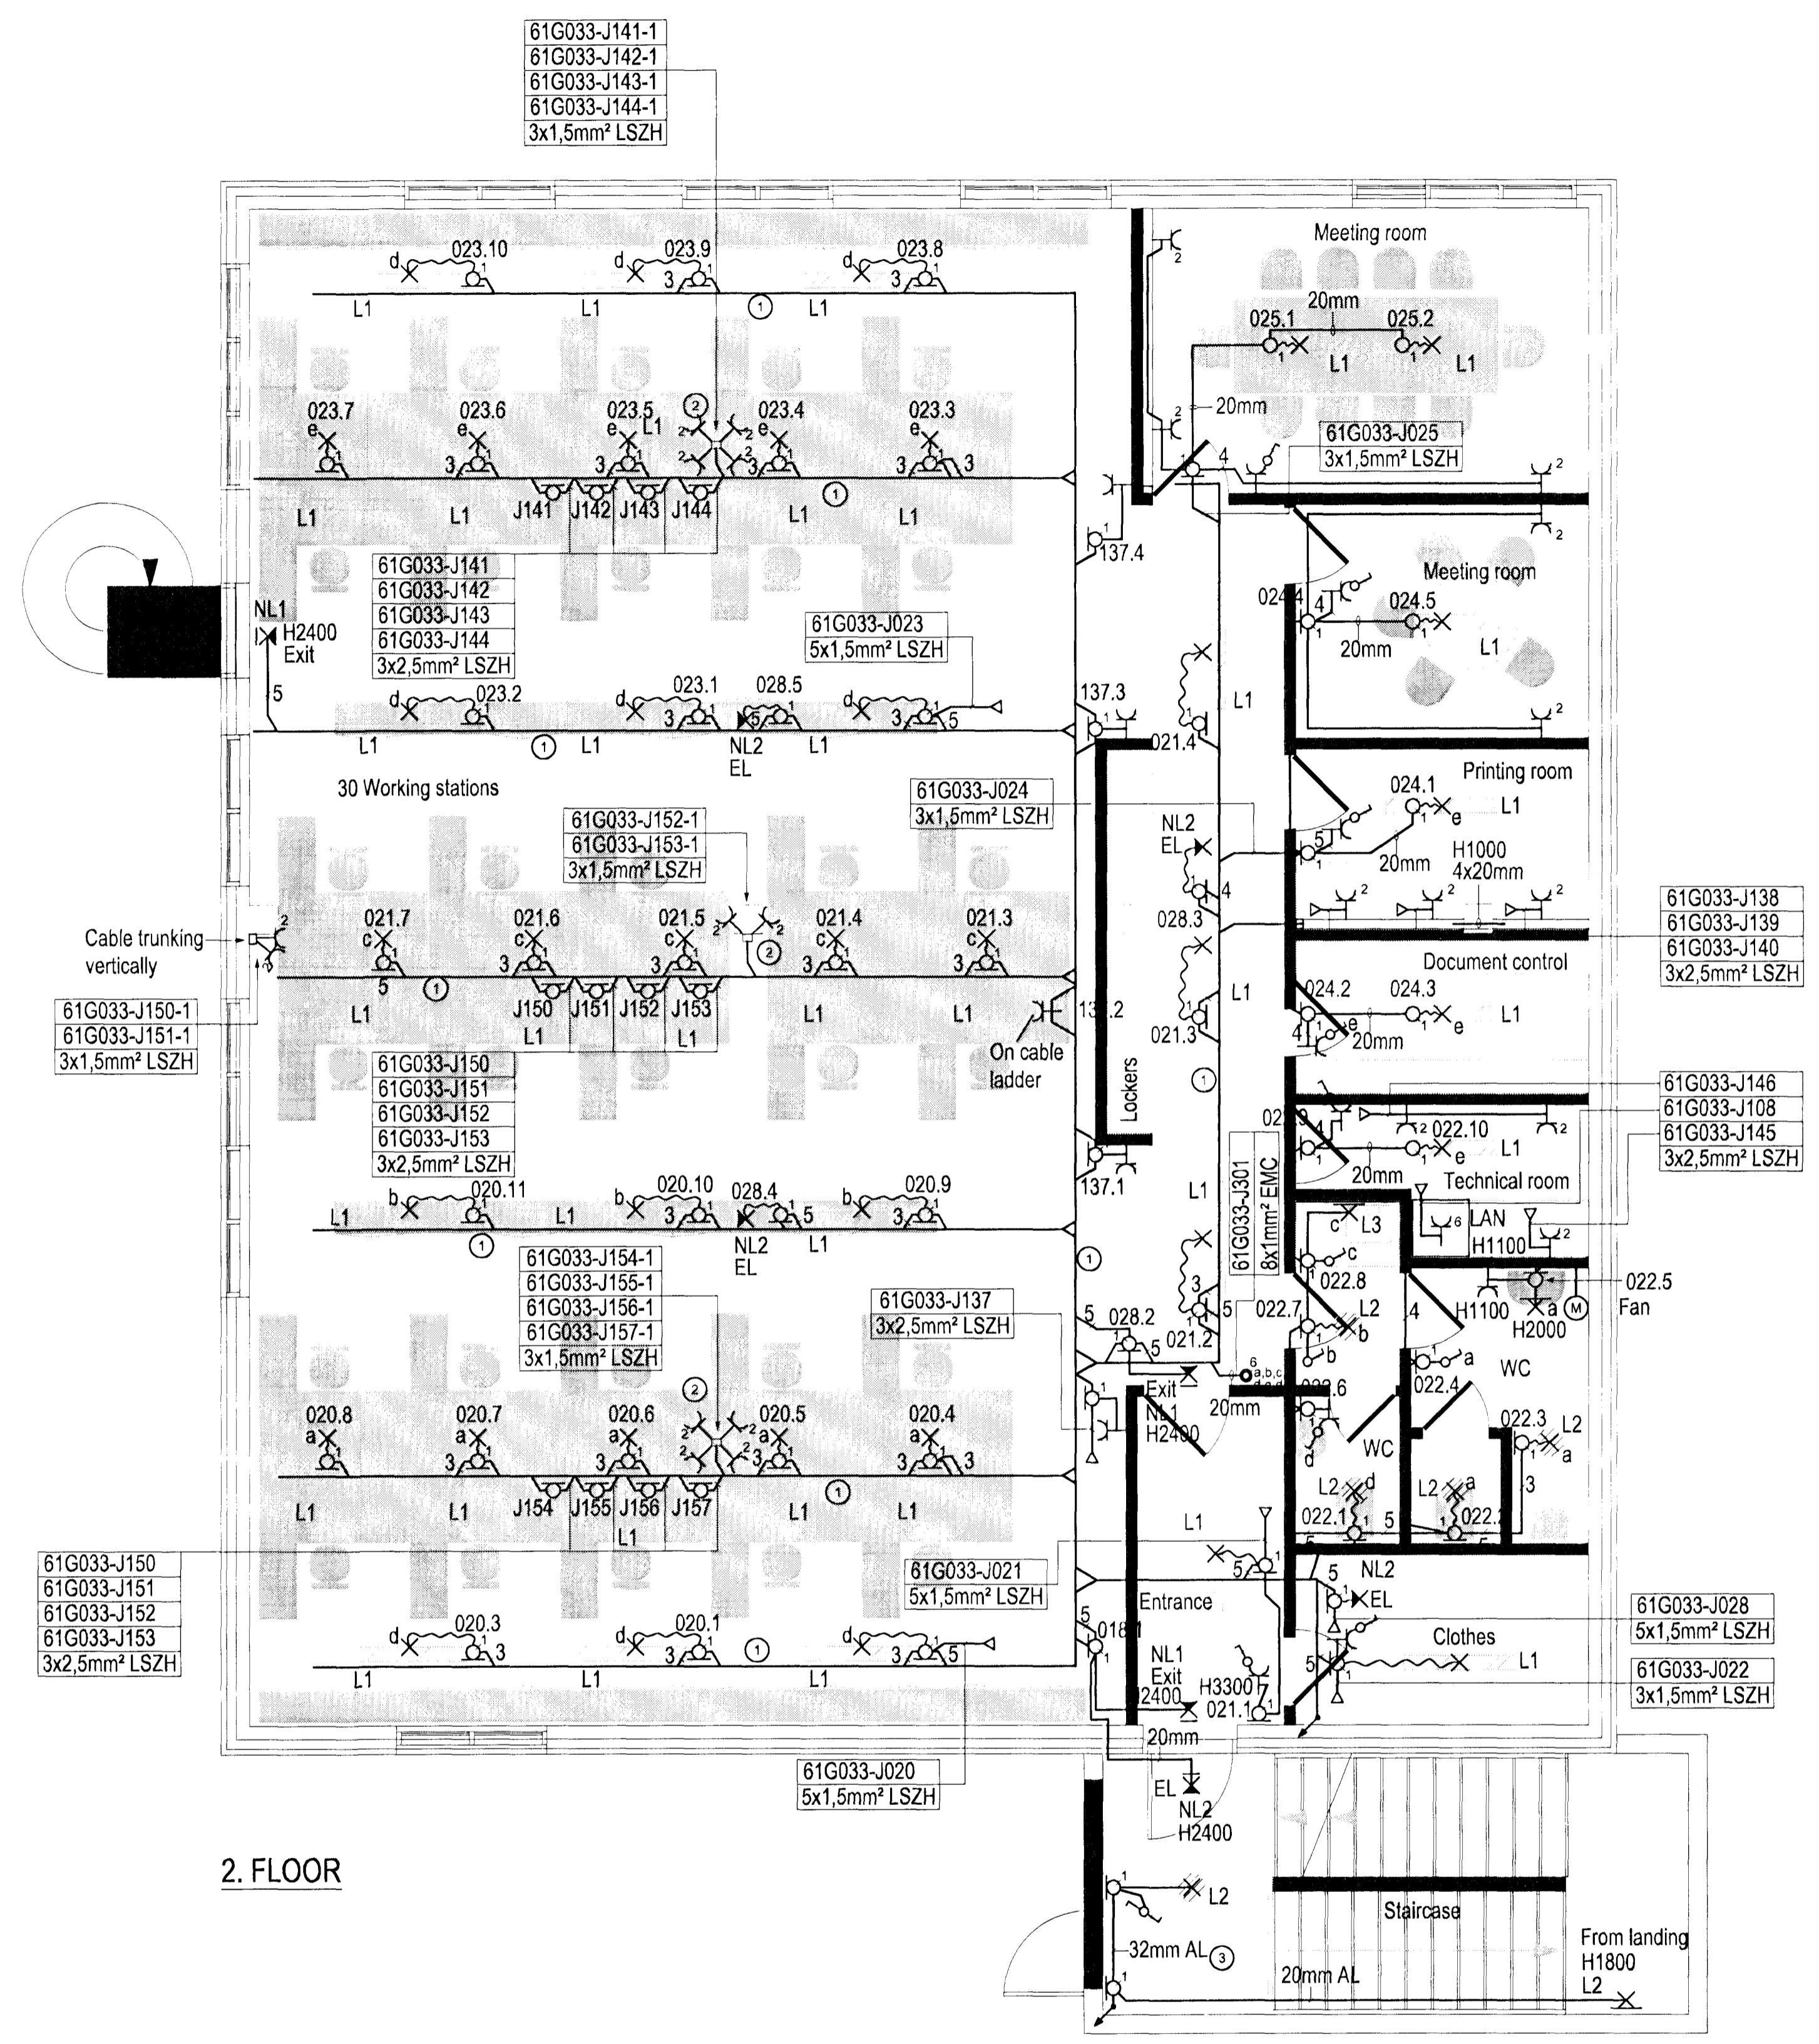


23/11 JL

Niel Indriðsson  
Tel. 891144-3549

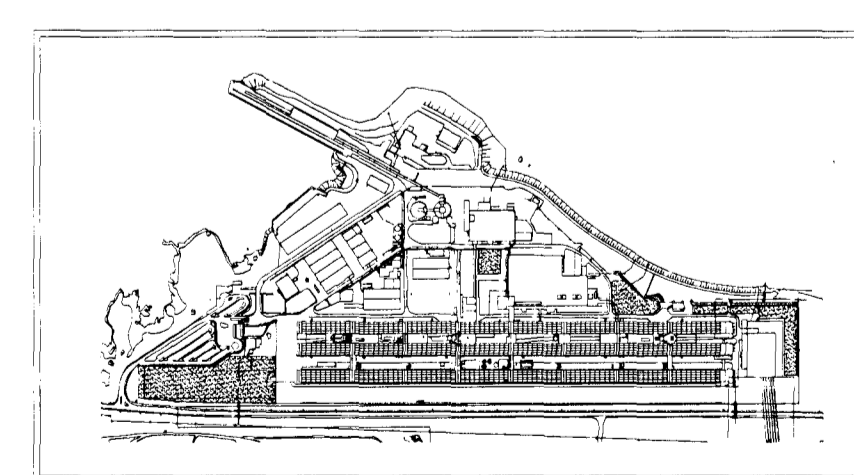

2. FLOOR

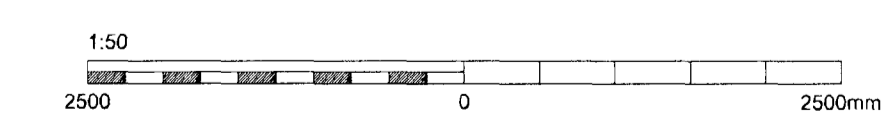

IPU Keyplan - Scale: 1:15000

- Skýringar:  
Legend:
- ① Cable in cable ladder
  - ② Outlets, vertical cable trunks
  - ③ All electrical installation is surface mounted in staircase

Slg. nr. Rev. no.	Lýsing Description	Dagsetning Date	Hug./Höf. Des./Drw.	Yfir Old	Notk. heim. Suppl. Ref.	Notk. heim. ISAL Ref.
4	UPDATE DRAWING	2011.09.08	GJ	ARE		
3	CHANGE IN STAIRWELL	2011.03.21	GJ	ARE	ÓS	MCBW
2	ISSUED FOR CONSTRUCTION	2011.02.25	GJ	ARE	ER	MCBW



Dagsetning / Date	2010.11.26
Hannað / Designed	Teikn / Drawn
GJ	þLI
Verkfró / Supplier	HRV
Teikn nr. / Verktaki / Supplier	IPU-872-FF-507-101
Sampjakt / Approved	Y
Hluti af / Part of:	ARE

-CM SITE OFFICE  
**ELECTRICAL  
INSTALLATION  
LAYOUT - 2. FLOOR**

Flakur nr.: Bláð nr.: Nasta bl. nr.:  
Kostn. nr. - Cono. / Búna. nr. - Eq.no.  
AKS

**RioTinto Alcan**

ISAL  
Alcan Iceland Ltd  
Straumark  
IS-222 Hafnarfjörður  
Ísland

ISAL Tekn. nr. ISAL / Drw. no. of ISAL Breyt / Rev.  
C

ISAL Yfirf. og sk.ð. dags / ISAL Checked, date  
ISAL Sampjakt, dags / ISAL Approved, date