


1st FLOOR - WASTE WATER

1:50

Samþykkt þann
27 SEP 2011
Sambýktur / Approved
F.H. Höfður S. Gunnlaugsson

Níðri Indriðsson
1144-2447

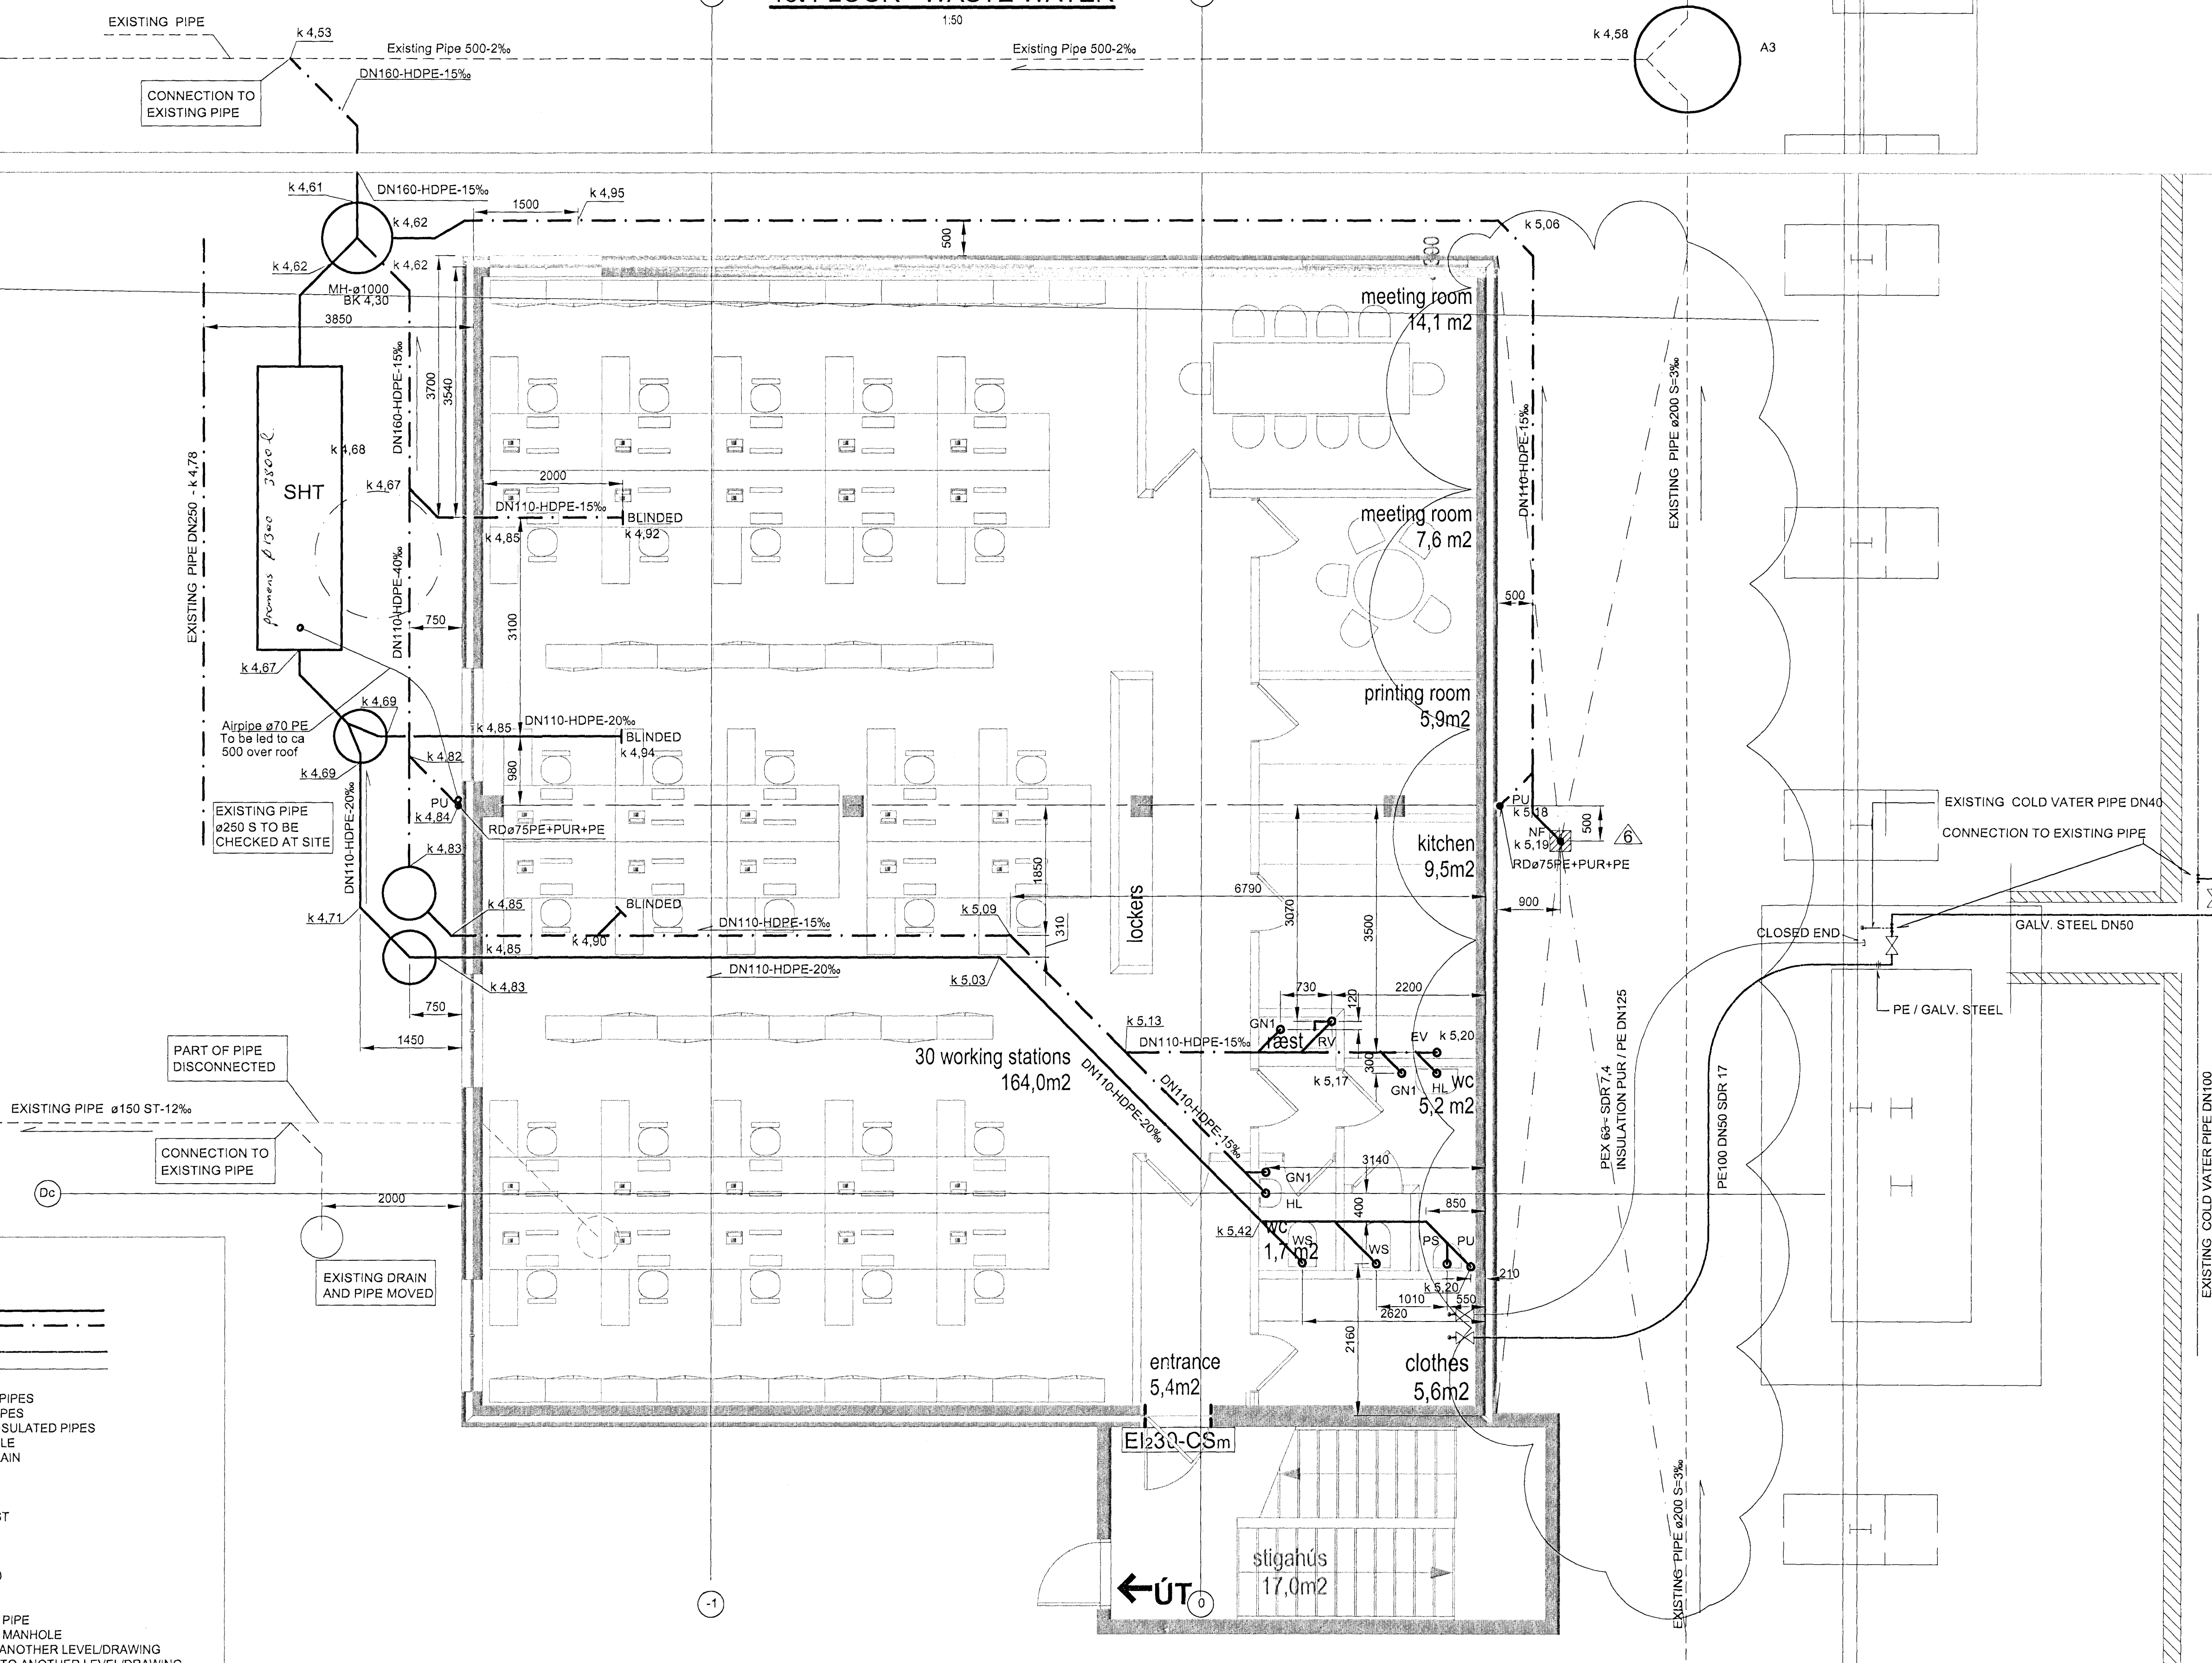

- LEGEND:**
- SEWAGE PIPE
 - DRAINAGE PIPE
 - STORM WATER PIPE
 - COLD TAP WATER PIPE
 - HOT WATER PIPE
-
- PP POLYPROPYLENE PIPES
 - HDPE POLYETHYLENE PIPES
 - PE-PUR-PE POLYETHYLENE INSULATED PIPES
 - MH PLUMBING MANHOLE
 - NF STORM WATER DRAIN
 - HL WASH BASIN
 - WS WATER CLOSET
 - PS URINAL
 - RV CLEANING SINK SST
 - EV KITCHEN SINK SST
 - RD ROOF DRAIN
 - F1 AIR PIPE
 - GN1 FLOOR DRAIN ø110
 - GN2 FLOOR DRAIN ø70
 - SHT SEPTIC TANK
 - K BOTTOM CODE OF PIPE
 - BK BOTTOM CODE OF MANHOLE
 - PU PIPE GOES UP TO ANOTHER LEVEL/DRAWING
 - PD PIPE GOES DOWN TO ANOTHER LEVEL/DRAWING

Skýringar:
Legend:

6	Drain added	2011.09.09	HJ	KGS
5	Hot water pipe connection, and changed to PEX. Existing DN250	2011.05.25	HJ	BAL KGS MCBW
4	Level on pipes changed, air pipe from SHT, Dimensions added	2011.04.15	HJ	BAL ER MCBW
3	Cold Water intake and changed rainwater connections	2011.04.13	HJ	BAL ER MCBW
2	SHT moved with connections	2011.03.15	MGM	BAL
1	ISSUED FOR CONSTRUCTION	2011.02.23	MGM	BAL

This drawing is the property of Rio Tinto Alcan Iceland Ltd. and handed out for personal use only. It may neither be copied nor made available to others without permission of Rio Tinto Alcan Iceland Ltd. The receiver is liable for any misuse.

Stærð: A1 Mkv: 1:50
Format: A1 Mkv: 1:50
Dimensions without tolerances according to IS2 218:1 medium.

Ólg nr	Lýsing	Dagsetning	Höfundur	Yfirlit	Notk heim	Notk heim
Rev no	Description	Date	Designer	Check	Supplier	ISAL Ref

HRV ENGINEERING

Dagsetning / Date: 2010.11.26

Hannað / Designed: MGM
Tala / Drawn: MCM

Verktaki / Supplier: HRV

Tekn.nr.verktaka / Supplier drw.no: IPU-872-K5-507-001

Sambýktur / Approved: F.H. Höfður S. Gunnlaugsson
Hlutur af: 7 Pó: 01

IPU 872 - EPCM SITE OFFICE
WASTE WATER
1st FLOOR

PLAN

RioTinto Alcan

ISAL
Alcan Iceland Ltd
Stauravík
IS-222 Hafnarfordur
Ísland

Tekn.nr. ISAL / Drw.no. of ISAL: ISAL
Breyt./Rev.: C

ISAL Yfirfund og skráð, dags / ISAL Checked, date
ISAL Samþykkt, dags / ISAL Approved, date