


GRUNNMYND 2.HÆÐAR- FRÁRENNSLI

1:50

BO

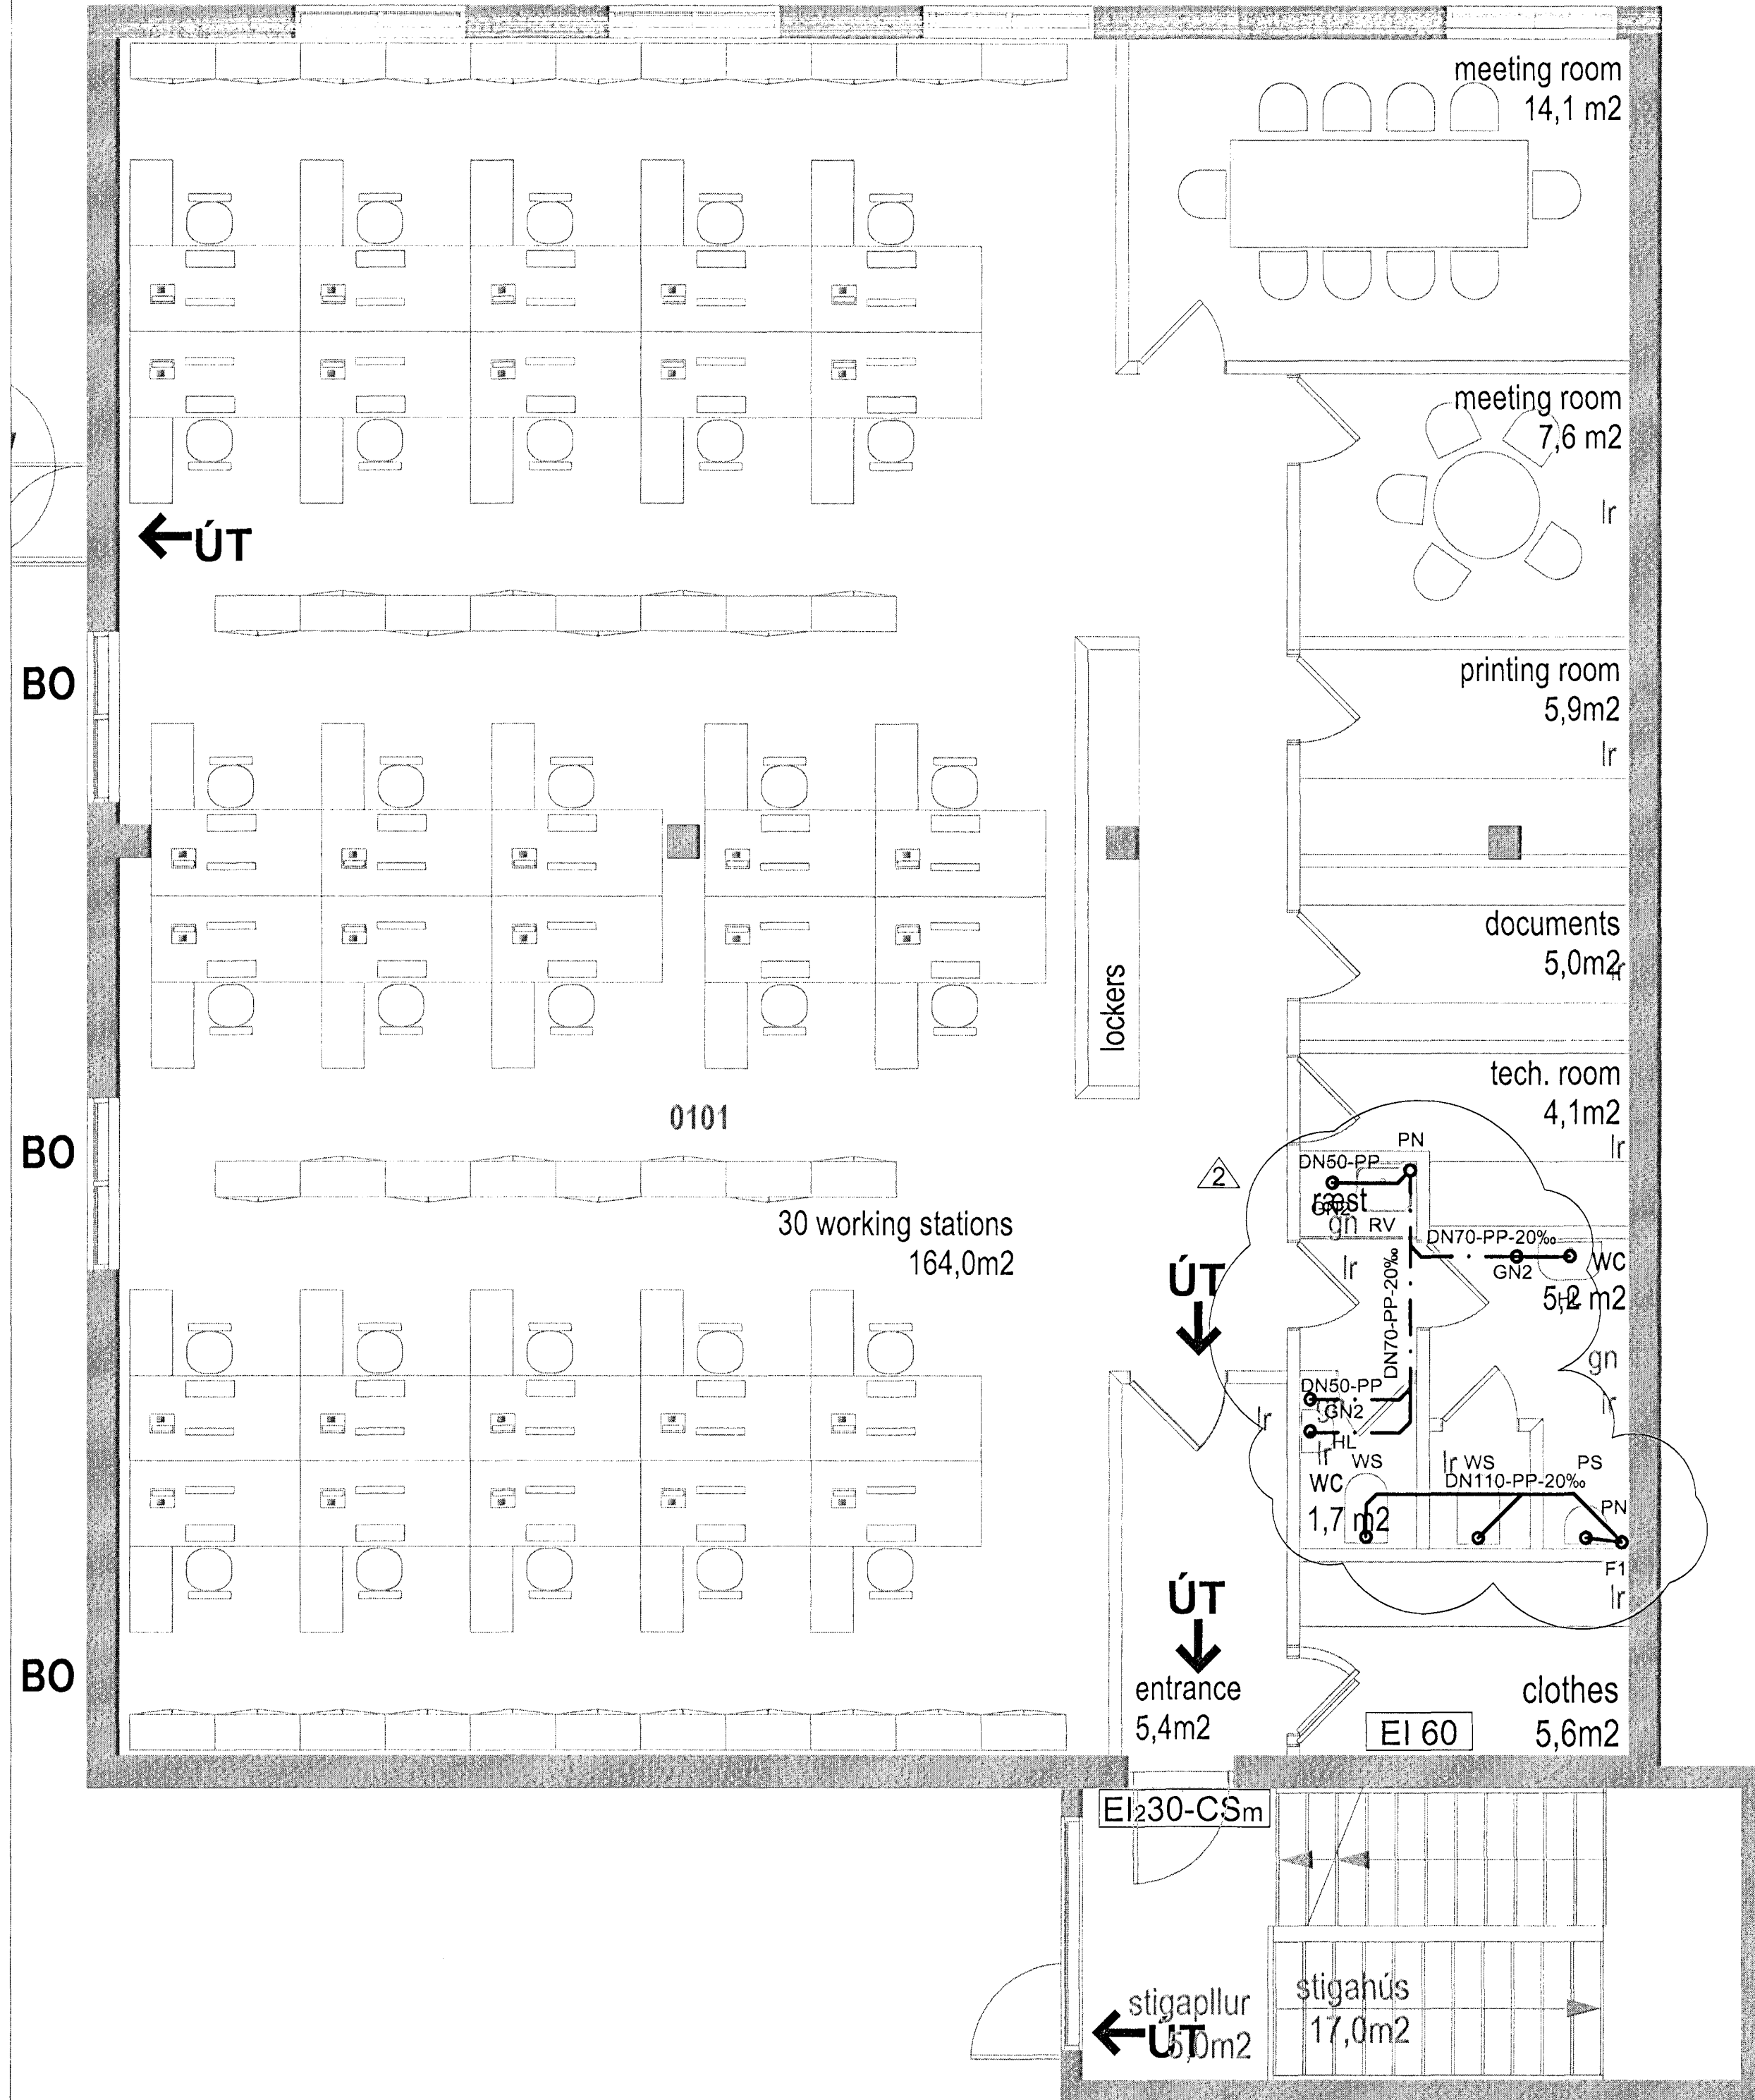

LEGEND:

SEWAGE PIPE
DRAINAGE PIPE
STORM WATER PIPE

PP POLYPROPYLENE PIPES
HDPE POLYETHYLENE PIPES
PE-PUR-PE POLYETHYLENE INSULATED PIPES
MH PLUMBING MANHOLE
NF STORM WATER DRAIN
HL WASH BASIN
WS WATER CLOSET
PS URINAL
RV CLEANING SINK SST
EV KITCHEN SINK SST
RD ROOF DRAIN
F1 AIR PIPE
GN1 FLOOR DRAIN ø110
GN2 FLOOR DRAIN ø70
SHT SEPTIC TANK
K BOTTOM CODE OF PIPE
BK BOTTOM CODE OF MANHOLE
PU PIPE GOES UP TO ANOTHER LEVEL/DRAWING
PD PIPE GOES DOWN TO ANOTHER LEVEL/DRAWING

Samþykkt þann
27 SEP 2011
Hafnarfróði
Ólafur S. Gunnlaugsson


Níels Indriðason
1844-3585

Skýringar:
Legend:

Óg nr / Rev no	Lýsing / Description	Dagsetning / Date	Höfundur / Drawn	Yfir / Old	Nok heim / Nolk heim / Suppl Rel	Nok heim / Nolk heim / ISAL Rel
2	PIPE CONNECTIONS	2011.09.09	KB	BAL		
1	ISSUED FOR CONSTRUCTION	2011.02.23	MGM	BAL		

This drawing is the property of Rio Tinto Alcan Iceland Ltd. and handed out for personal use only. It may neither be copied nor made available to others without permission of Rio Tinto Alcan Iceland Ltd. The receiver is liable for any misuse.

Start: A1 Mkv: 1:50
Format: A1 Scale: 1:50
Dimensions without tolerances according to IS 2768-1 medium.

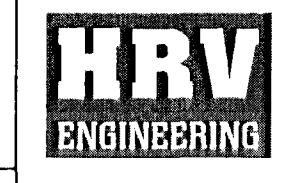

Dagsetning / Date	2010.11.26
Hannað / Designed	MGM
Teikn / Drawn	MGM
Verktaki / Supplier	HRV
Teikn.nr.verklaka / Supplier drw.no.	IPU-872-K5-507-002
Sambýkt / Approved	Baldur Þorsteinsson
Yfir / Checked	BAL
Hluti af / Part of	

IPU 872 - SITE OFFICE			Flikkur nr.:	Blað nr.:	Nesta bl.nr.:
WASTE WATER			Kostn.nr.-Coco. / Blað.nr.-Eqno		
2nd FLOOR			AKS		
PLAN			AKS		
RioTintoAlcan			C		
ISAL Checked, date			ISAL Approved, date		