



PLAN 2.FLOOR - TAP WATER

1:50

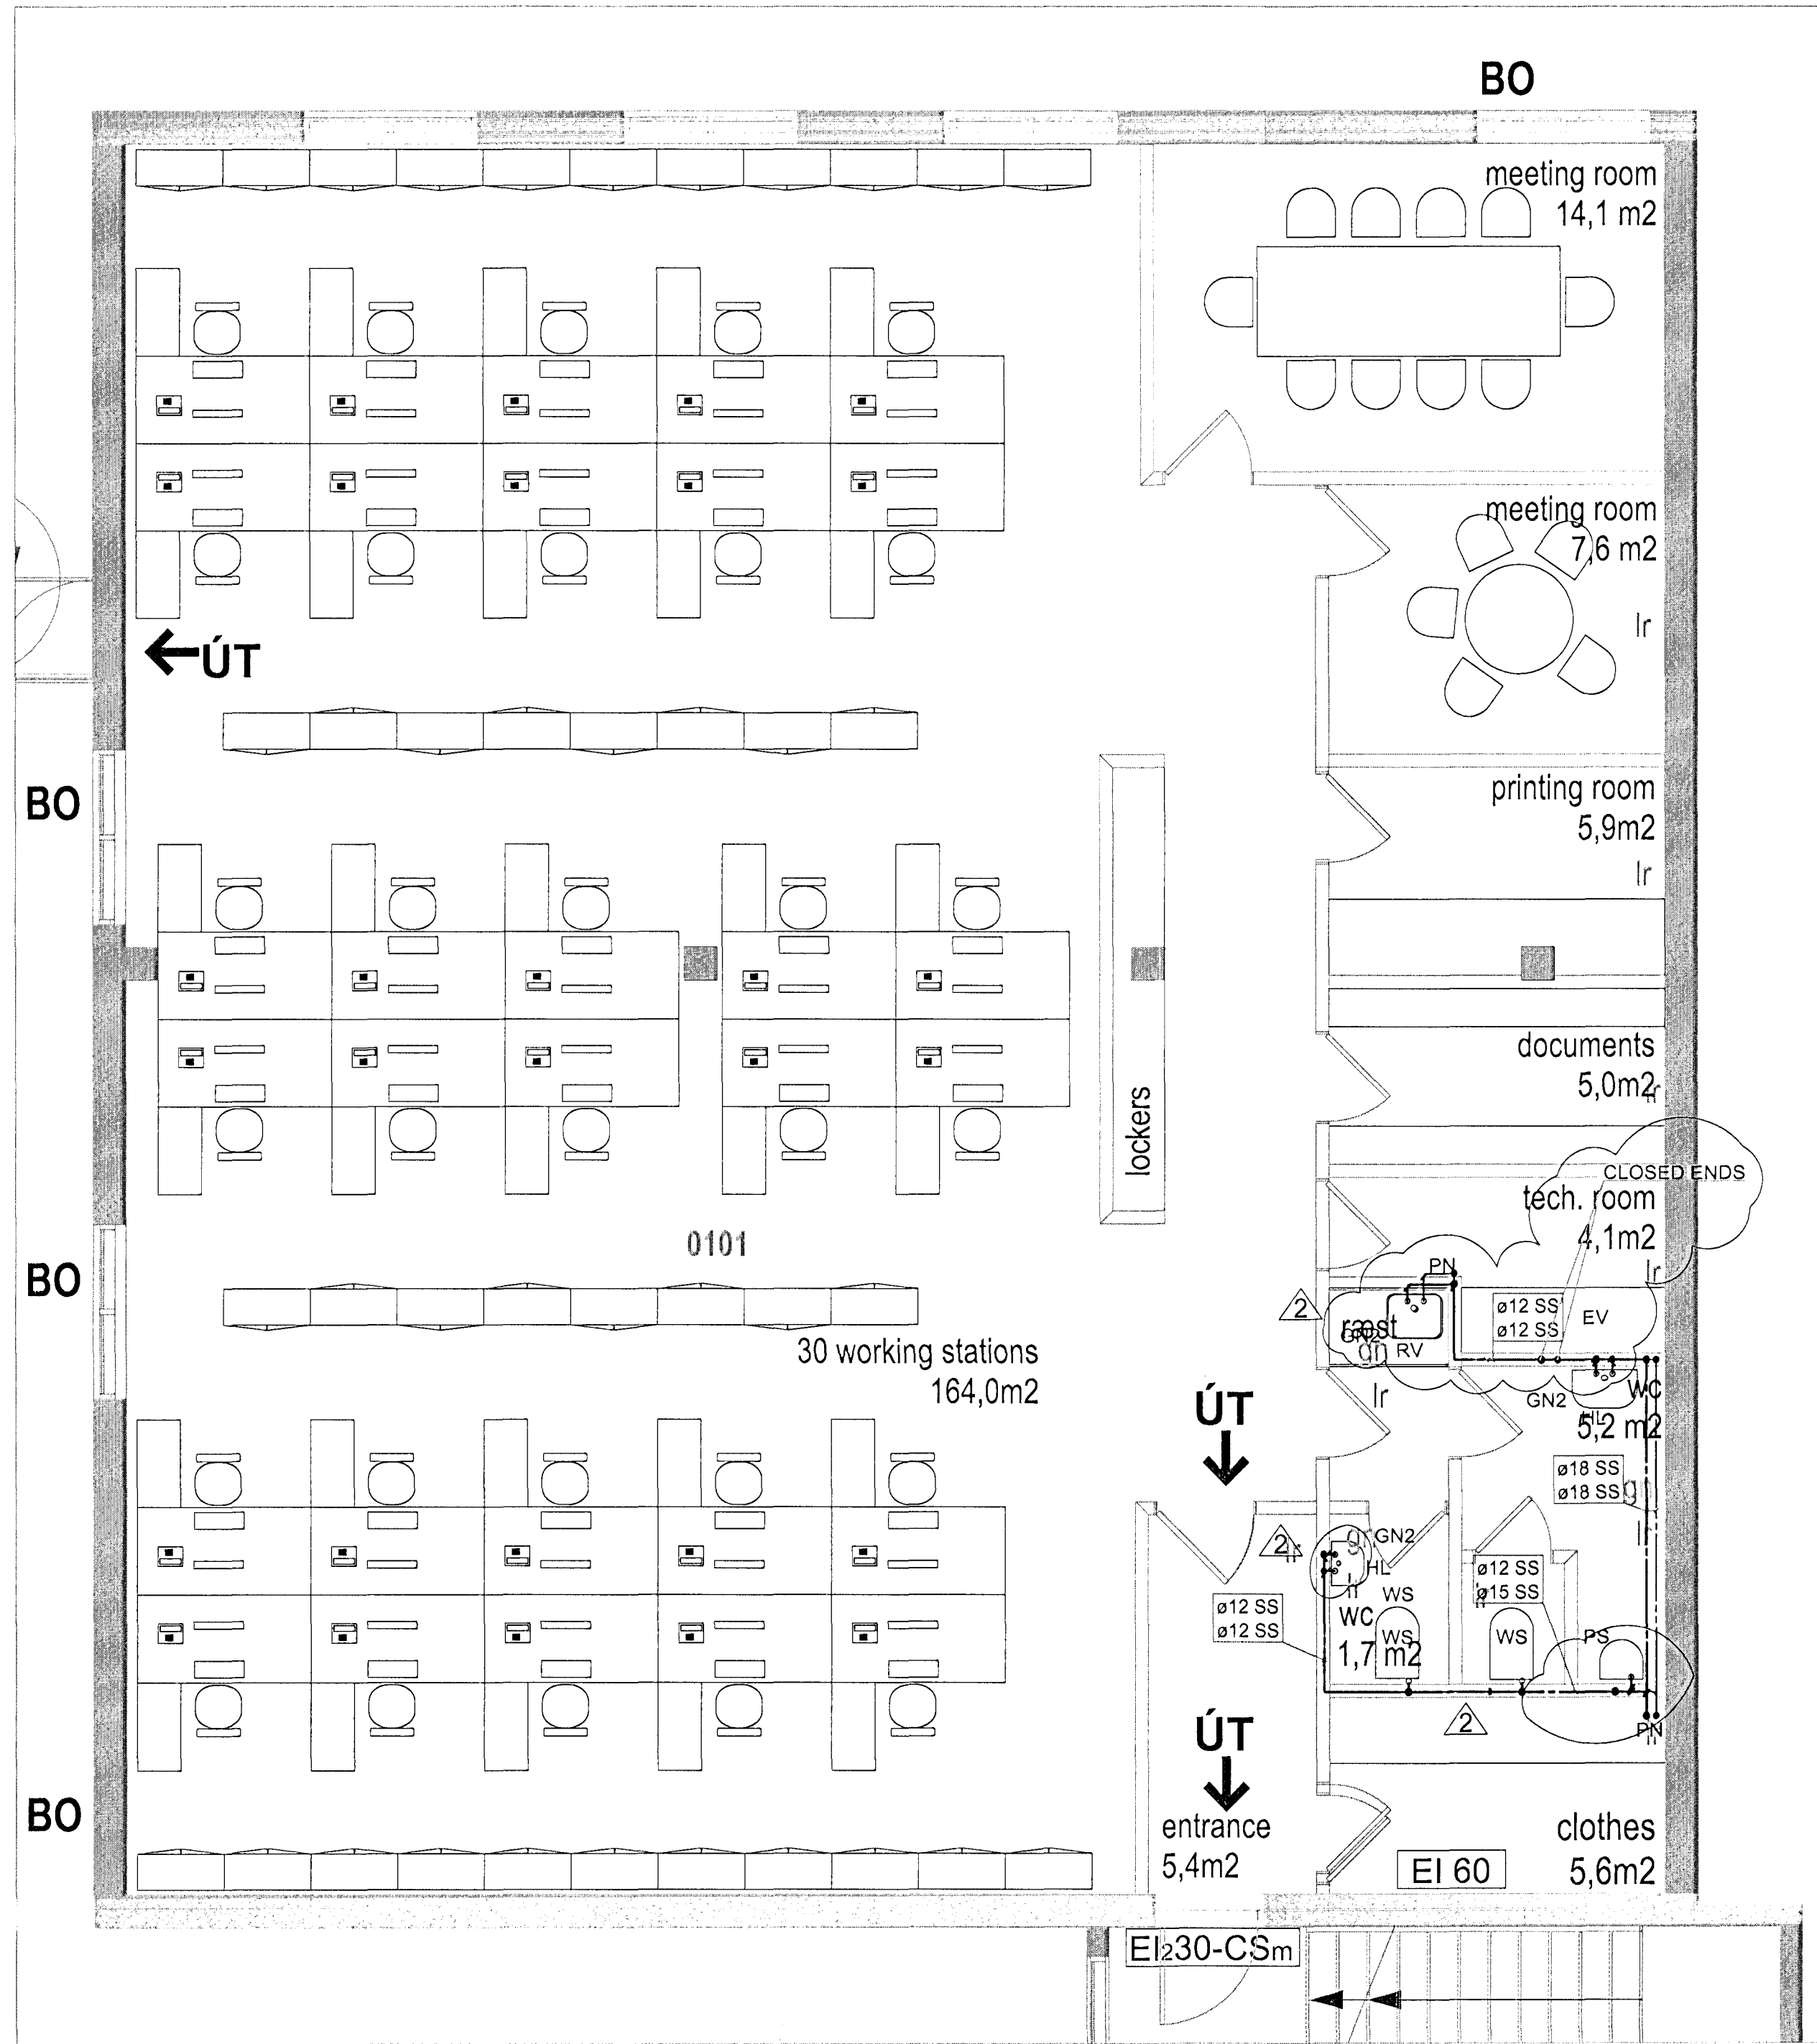

ISOMETRIC DRAWING 2.FLOOR- TAP WATER

1:50

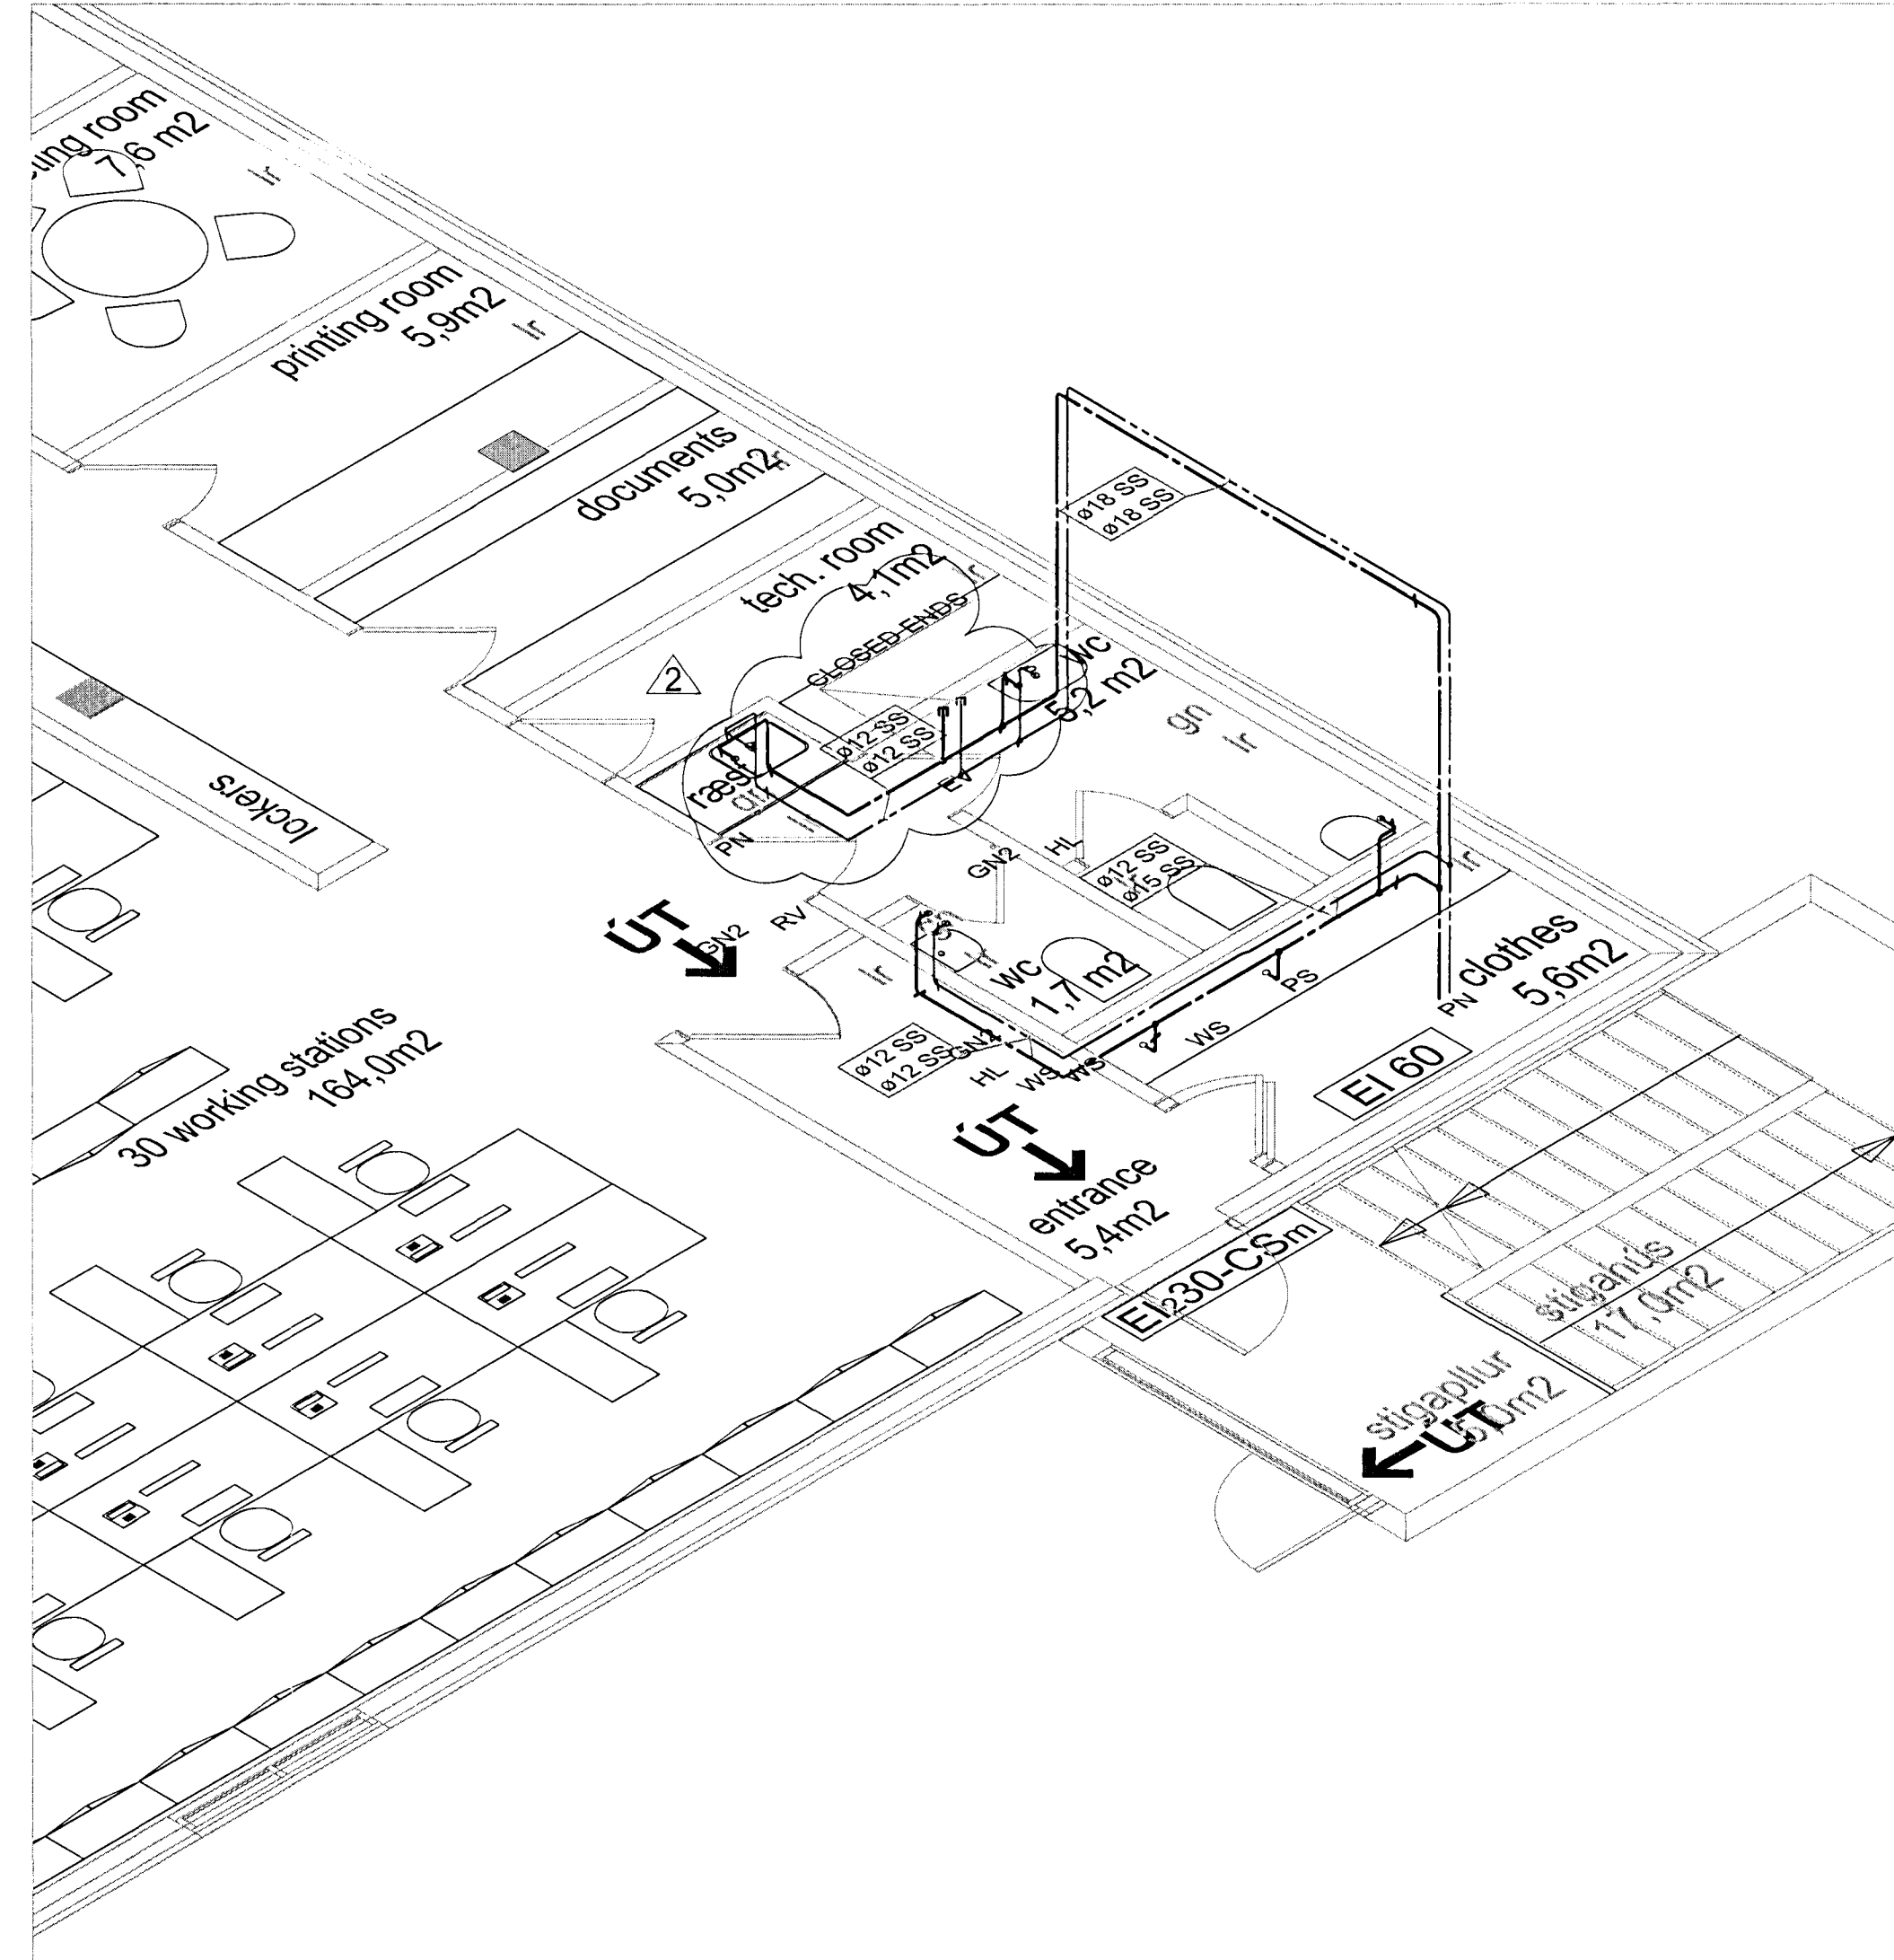

Samþykkt þann
27 SEP 2011
Hafnarfréttir
Hafnarforður Gunnlaugsson

Nick Indriðsson
181144-28149

LEGEND:

ALL TAP WATER PIPES SHALL BE STAINLESS STEEL AND ALL DISTRIBUTION PIPES SHALL BE INSULATED.

HOT TAP WATER PIPE
COLD TAP WATER PIPE


- SS STAINLESS STEEL
- K BOTTOM CODE OF PIPE
- FH FIRE HOSE
- HL WASH BASIN
- WS TOILET/WALL HANGED
- RV CLEANING SINK
- EV KITCHEN SINK
- PU PIPE GOES UP TO ANOTHER LEVEL/DRAWING
- PD PIPE GOES DOWN TO ANOTHER LEVEL/DRAWING

Skýringar:
Legend:

Sl. nr / Rev. no.	Lýsing / Description	Dagsetning / Date	Har/Tha / Des/Drw	Yfir / Old	Notk heim / Suppl. Re	Notk heim / ISAL Ref
2	TAP WATER POINTS	2011.09.09	KB	<i>[Signature]</i>		
1	ISSUED FOR CONSTRUCTION	2011.02.23	MGM	BAL	KGS	

This drawing is the property of Rio Tinto Alcan Iceland Ltd. and handed out for personal use only. It may neither be copied nor made available to others without permission of Rio Tinto Alcan Iceland Ltd. The receiver is liable for any misuse.

Stærð: A1 Mkv: 1:50
Format: A1 Scale: 1:50
Dimensions without tolerances according to ISO 2768-1 medium.

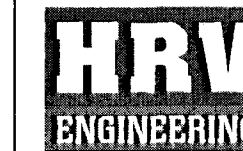

Dagsetning / Date: 2010.11.26
Hannað / Designed: MGM
Tekin / Drawn: MGM
Verktaki / Supplier: HRV
Tekin nr. verklaka / Supplier draw no.: IPU-872-K5-507-004
Samþykkt / Approved: *[Signature]* Yfir / Chkd: BAL
Hluti af: / Part of:

IPU 872 - SITE OFFICE
TAP WATER
2nd FLOOR
PLAN & ISOMETRIC

RioTinto Alcan

ISAL Tekn.nr. ISAL /Drw.no. of ISAL Breyt./Rev: C
ISAL Yfirfarið og skráð. dags / ISAL Checked, date ISAL Samþykkt, dags / ISAL Approved, date

Flakur nr.:	Blöð nr.:	Nasta bl. nr.:
Kostn. nr. - Cono. / Bón. nr. - Eq.no		
AKS		