

PLAN 1.FLOOR- TAP WATER



1:50

ISOMETRIC DRAWING 1.FLOOR- TAP WATER

1:50

Samþykkt þann
27 SEP 2011
Sampykkt þann / Hafnarhöfði
Eið. Höfður S. Gunnlaugsson

Níels Indriðsson
181144-3349

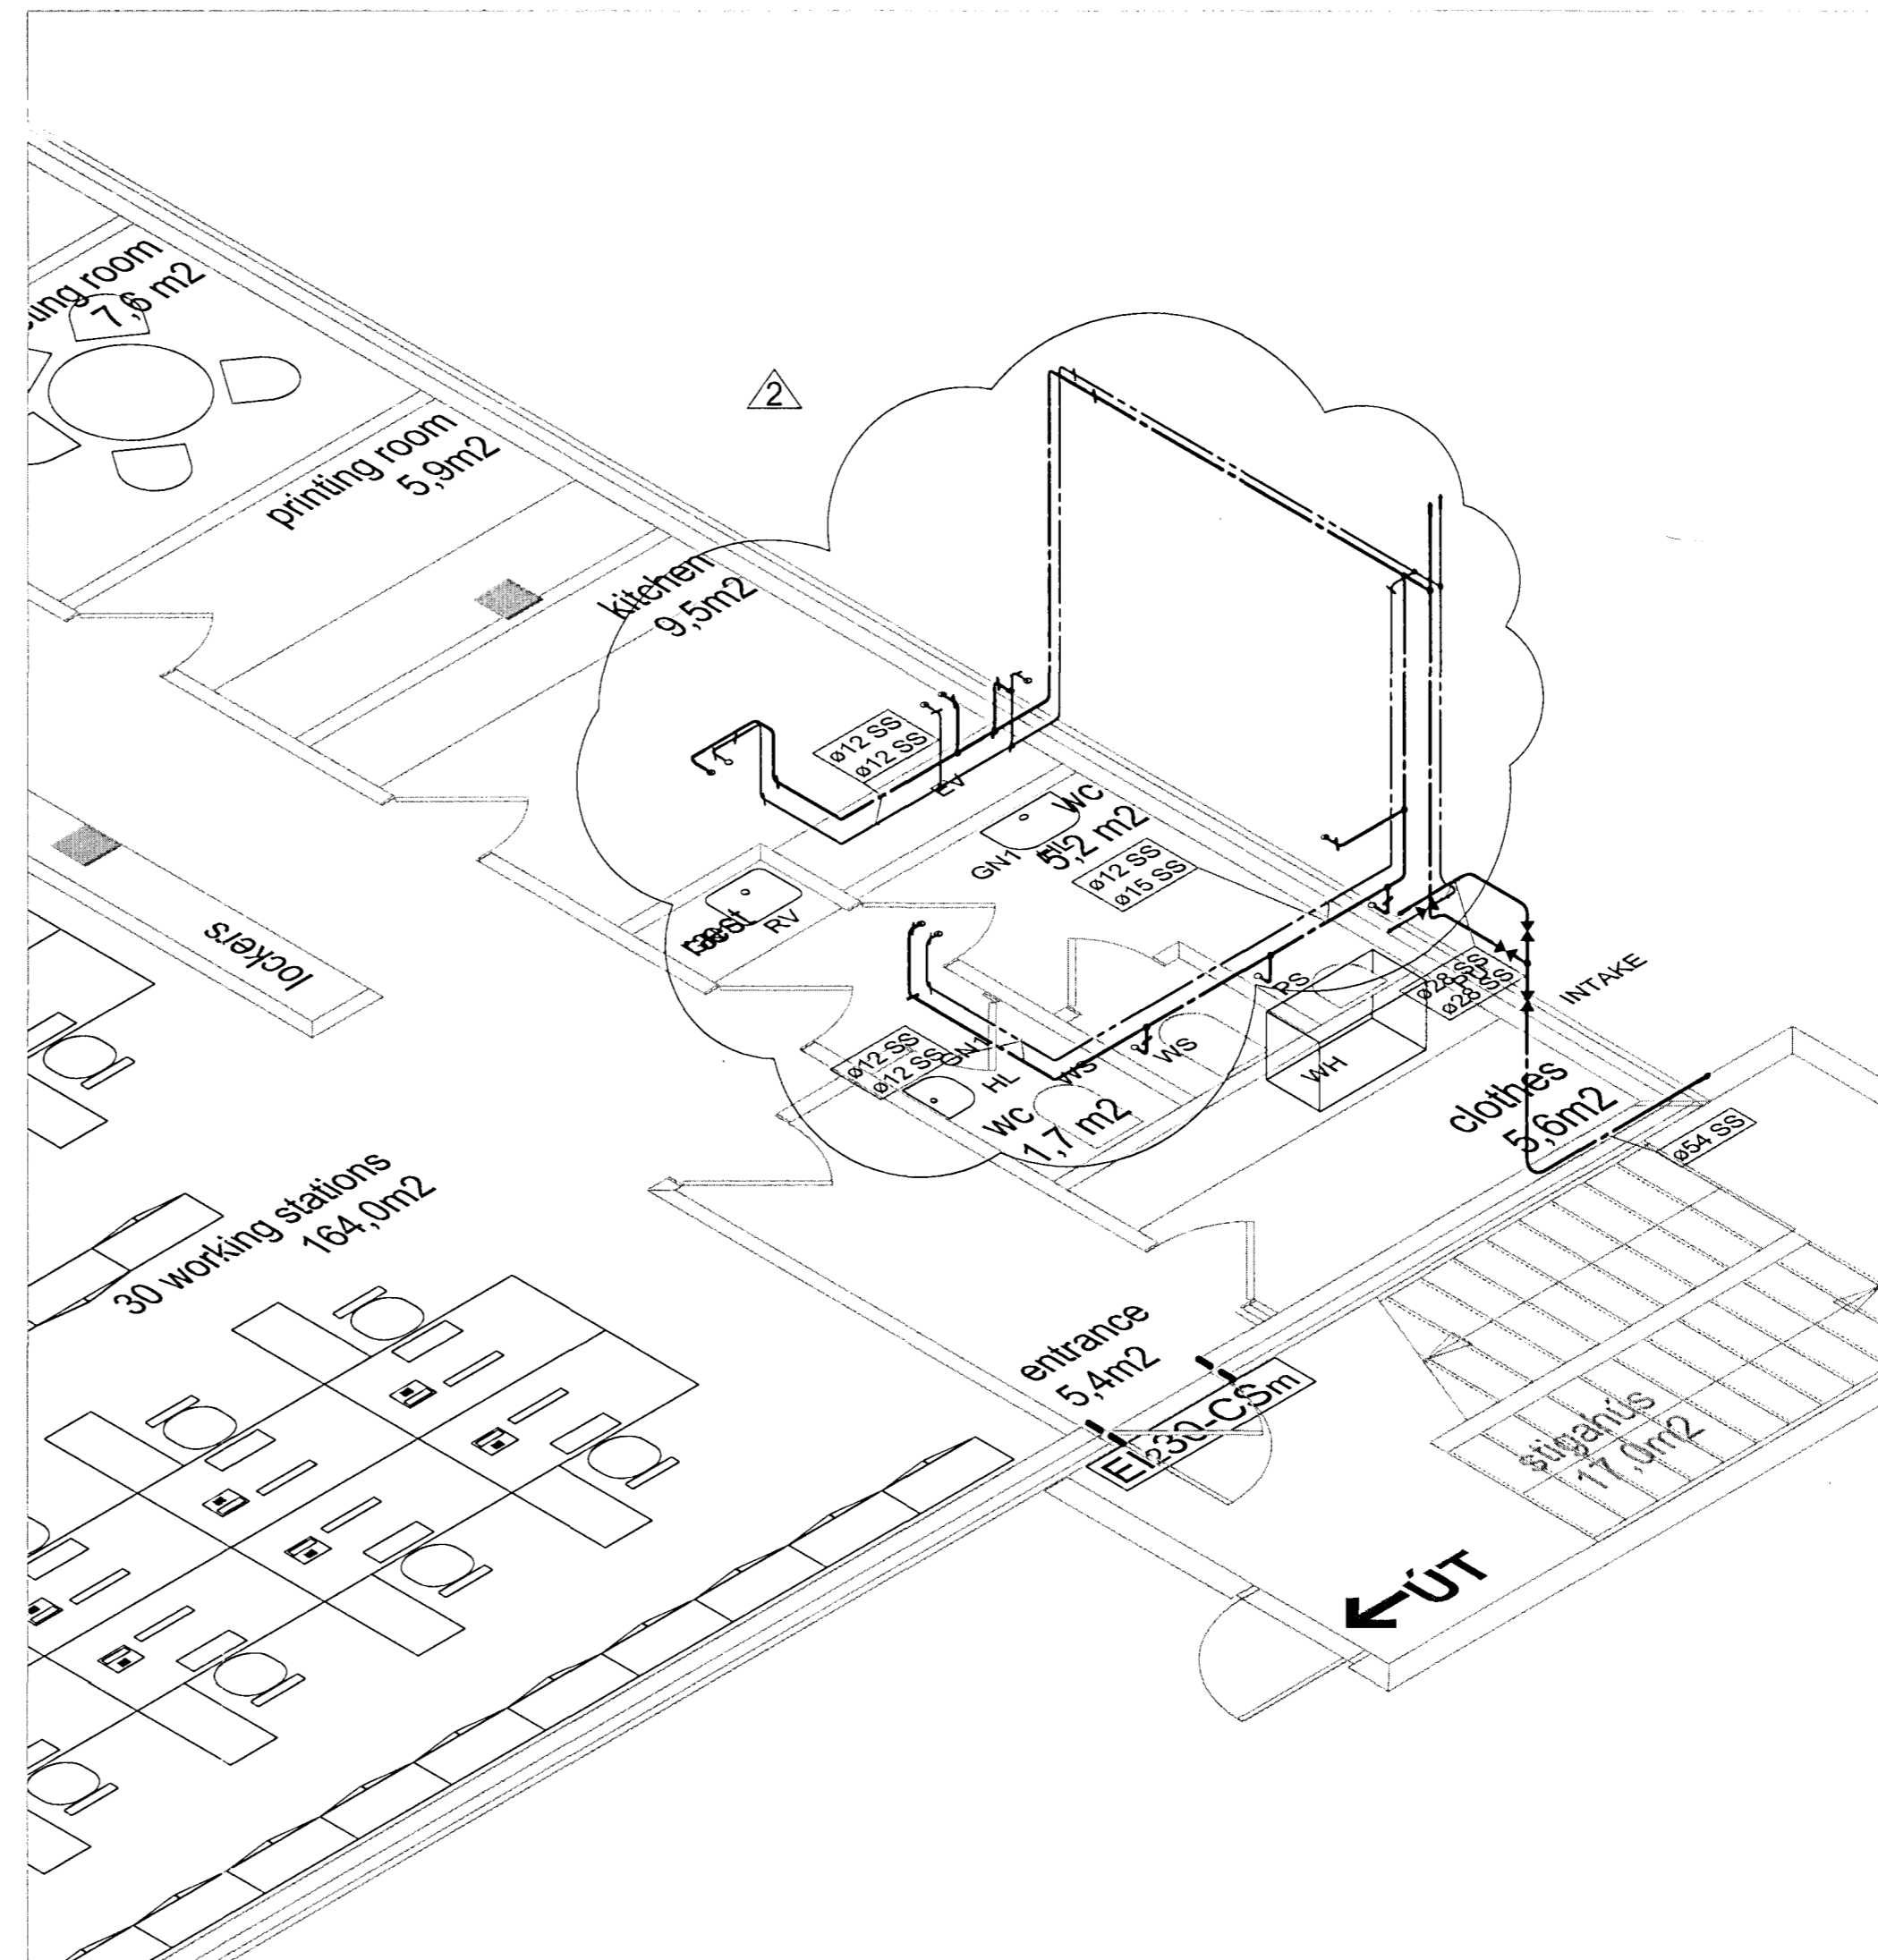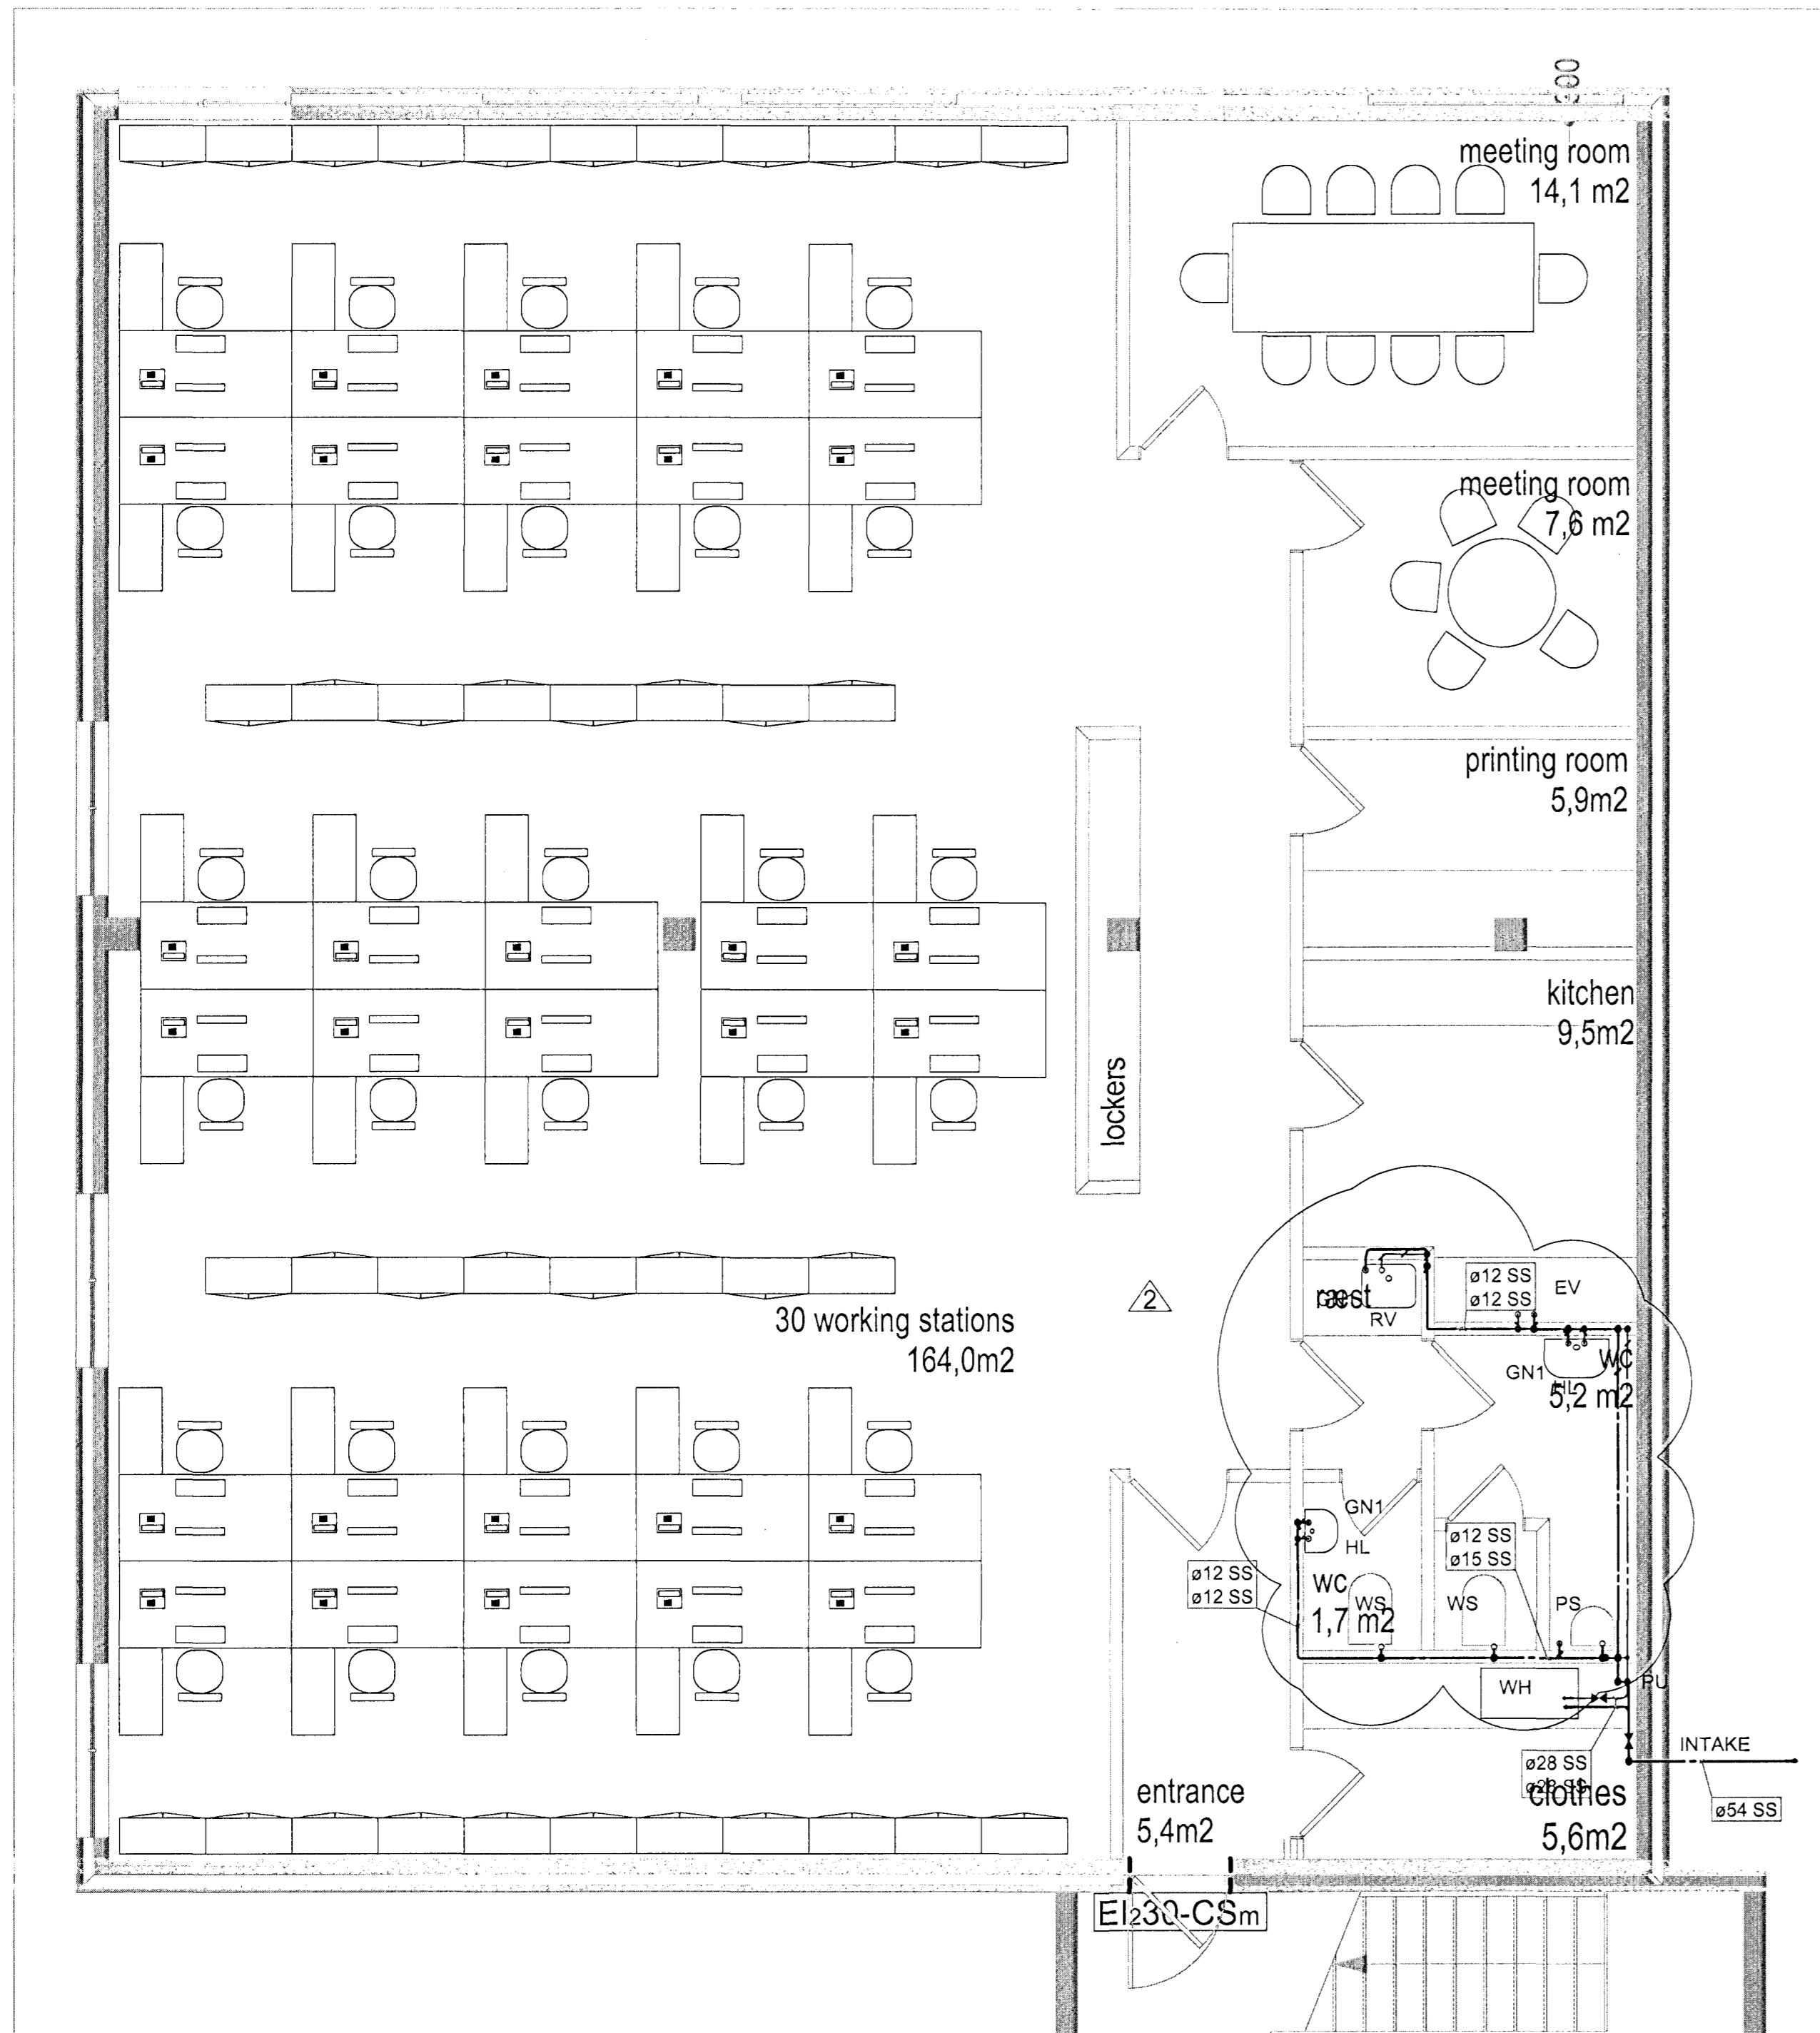


LEGEND:

ALL TAP WATER PIPES SHALL BE STAINLESS STEEL AND ALL DISTRIBUTION PIPES SHALL BE INSULATED.

- HOT TAP WATER PIPE
- COLD TAP WATER PIPE
- SS STAINLESS STEEL
- K BOTTOM CODE OF PIPE
- FH FIRE HOSE
- HL WASH BASIN
- WS TOILET WALL HANGED
- RV CLEANING SINK
- EV KITCHEN SINK
- WH ELECTRIC WATER HEATER, 16kW
- PU PIPE GOES UP TO ANOTHER LEVEL/DRAWING
- PD PIPE GOES DOWN TO ANOTHER LEVEL/DRAWING

Skýringar:
Legend:

2	TAPWATER POINTS AND PIPES	2011.09.09	KB	BF																
1	ISSUED FOR CONSTRUCTION	2011.02.23	MGM	BAL																

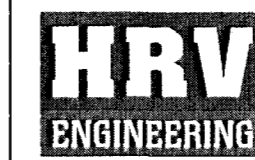

Dagsetning / Date	2010.11.26
Hannað / Designed	MGM
Verktaki / Supplier	HRV
Tekn.númer / Supplier drw.no.	IPU-872-K5-507-003
Sampykkt / Approved	YRF / Önkð
HLÚT af: / Part of:	BAL

IPU-872 -- SITE OFFICE		Flokkur nr.:	Bláð nr.:	Næsta bl. nr.:
TAP WATER SYSTEM		Kostn.nr.-Ceno. / Búnr.-Eq.no		
1st FLOOR		AKS		
PLAN & ISOMETRIC		ISAL		
RioTinto Alcan		Alcan Iceland Ltd Stauravík IS-222 Hafnarfordur Ísland		
ISAL Tífráð og skráð, dags / ISAL Checked, date		ISAL Tífráð, dags / ISAL Approved, date		