Samþykkt þann
26 OCT 2012
Byggingafulltrúinn í Hafnarfjörði
F.h. Sigurður Steinar Jónsson

Nick Indriðason
Kt. 181144-3949 NI

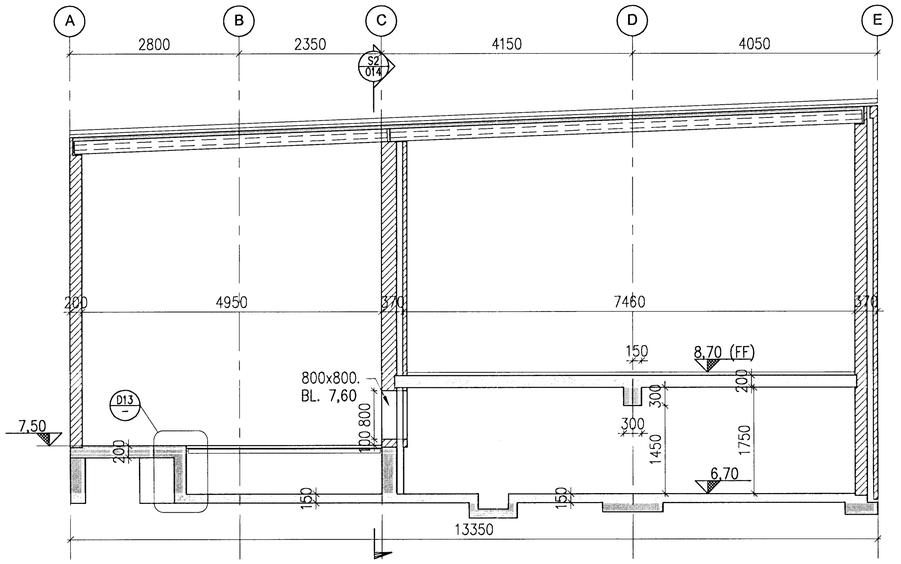

S3 / 011 SECTION 1:50

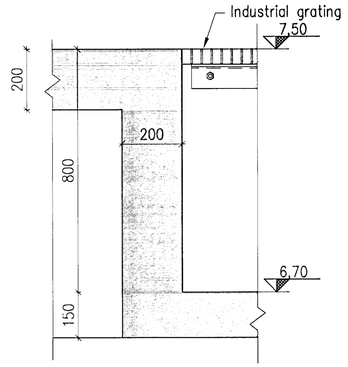

D13 / - DETAIL 1:10

1:10 0 100 500 1000mm
1:50 0 1000 5000mm

Skýringar:
Legend:
Prefabricated elements are shown on contractors drawings

Útg nr Rev no	Lýsing Description	Dagsetning Date	Han/Tkn Des/Drw	Yfirf Ckd	Notk heim Suppl Rel	Notk heim ISAL Rel
6	Record drawing	2012.09.20	GMG	NI	PG	

This drawing is the property of Rio Tinto Alcan Iceland Ltd. and handed out for personal use only. It may neither be copied nor made available to others without permission of Rio Tinto Alcan Iceland Ltd. The receiver is liable for any misuse.

Stærð: Format: A1 Mkv.: Scale: 1:10, 1:50
Dimensions without tolerances according to ISO 2768-1 medium.

HRV & HATCH JOINT VENTURE ISAL PRODUCTION UPGRADE

Dagsetning / Date: 2011.02.14
Hannað / Designed: HFB
Teikn / Drawn: HFB/ÁFV
Verktaki / Supplier: HRV
Teikn.nr.verktaka / Supplier drw.no.: IDP-212-DA-062-016
Samþykkt / Approved: NI
Yfirf / Chkd: HjH
Hluti af: / Part of:

IPU 212 – SUBSTATION 140
GENERAL LAYOUT
SECTION AND DETAIL
Teg.teikningar / Dwg. type: FORMWORK

Rio Tinto Alcan
ISAL Alcan Iceland Ltd Straumsvík IS-222 Hafnarfjörður Iceland

Flokkur nr.: | Blað nr.: | Næsta bl.nr.:
Kostn.nr.-Cono. / Bún.nr.-Eq.no: 4011 16406
AKS: UB140
Teikn.nr. ISAL /Drw.no. of ISAL: 251415
Breyt./Rev.: A

ISAL Yfirfarið og skráð, dags / ISAL Checked, date
ISAL Samþykkt, dags / ISAL Approval, date

C:\IDP\01 IDP\200 – Utilities\210 Electical energy supply\Drawings\Architectural\IDP-212-DA-062-016.dwg