


Samþykkt þann
 26 OCT 2012
 Byggingafulltrúinn / Hafnarfróði
 F.h. Sigurður Steinar Jónsson

Níels Indriðason
 Kt. 181144-3949
 NI

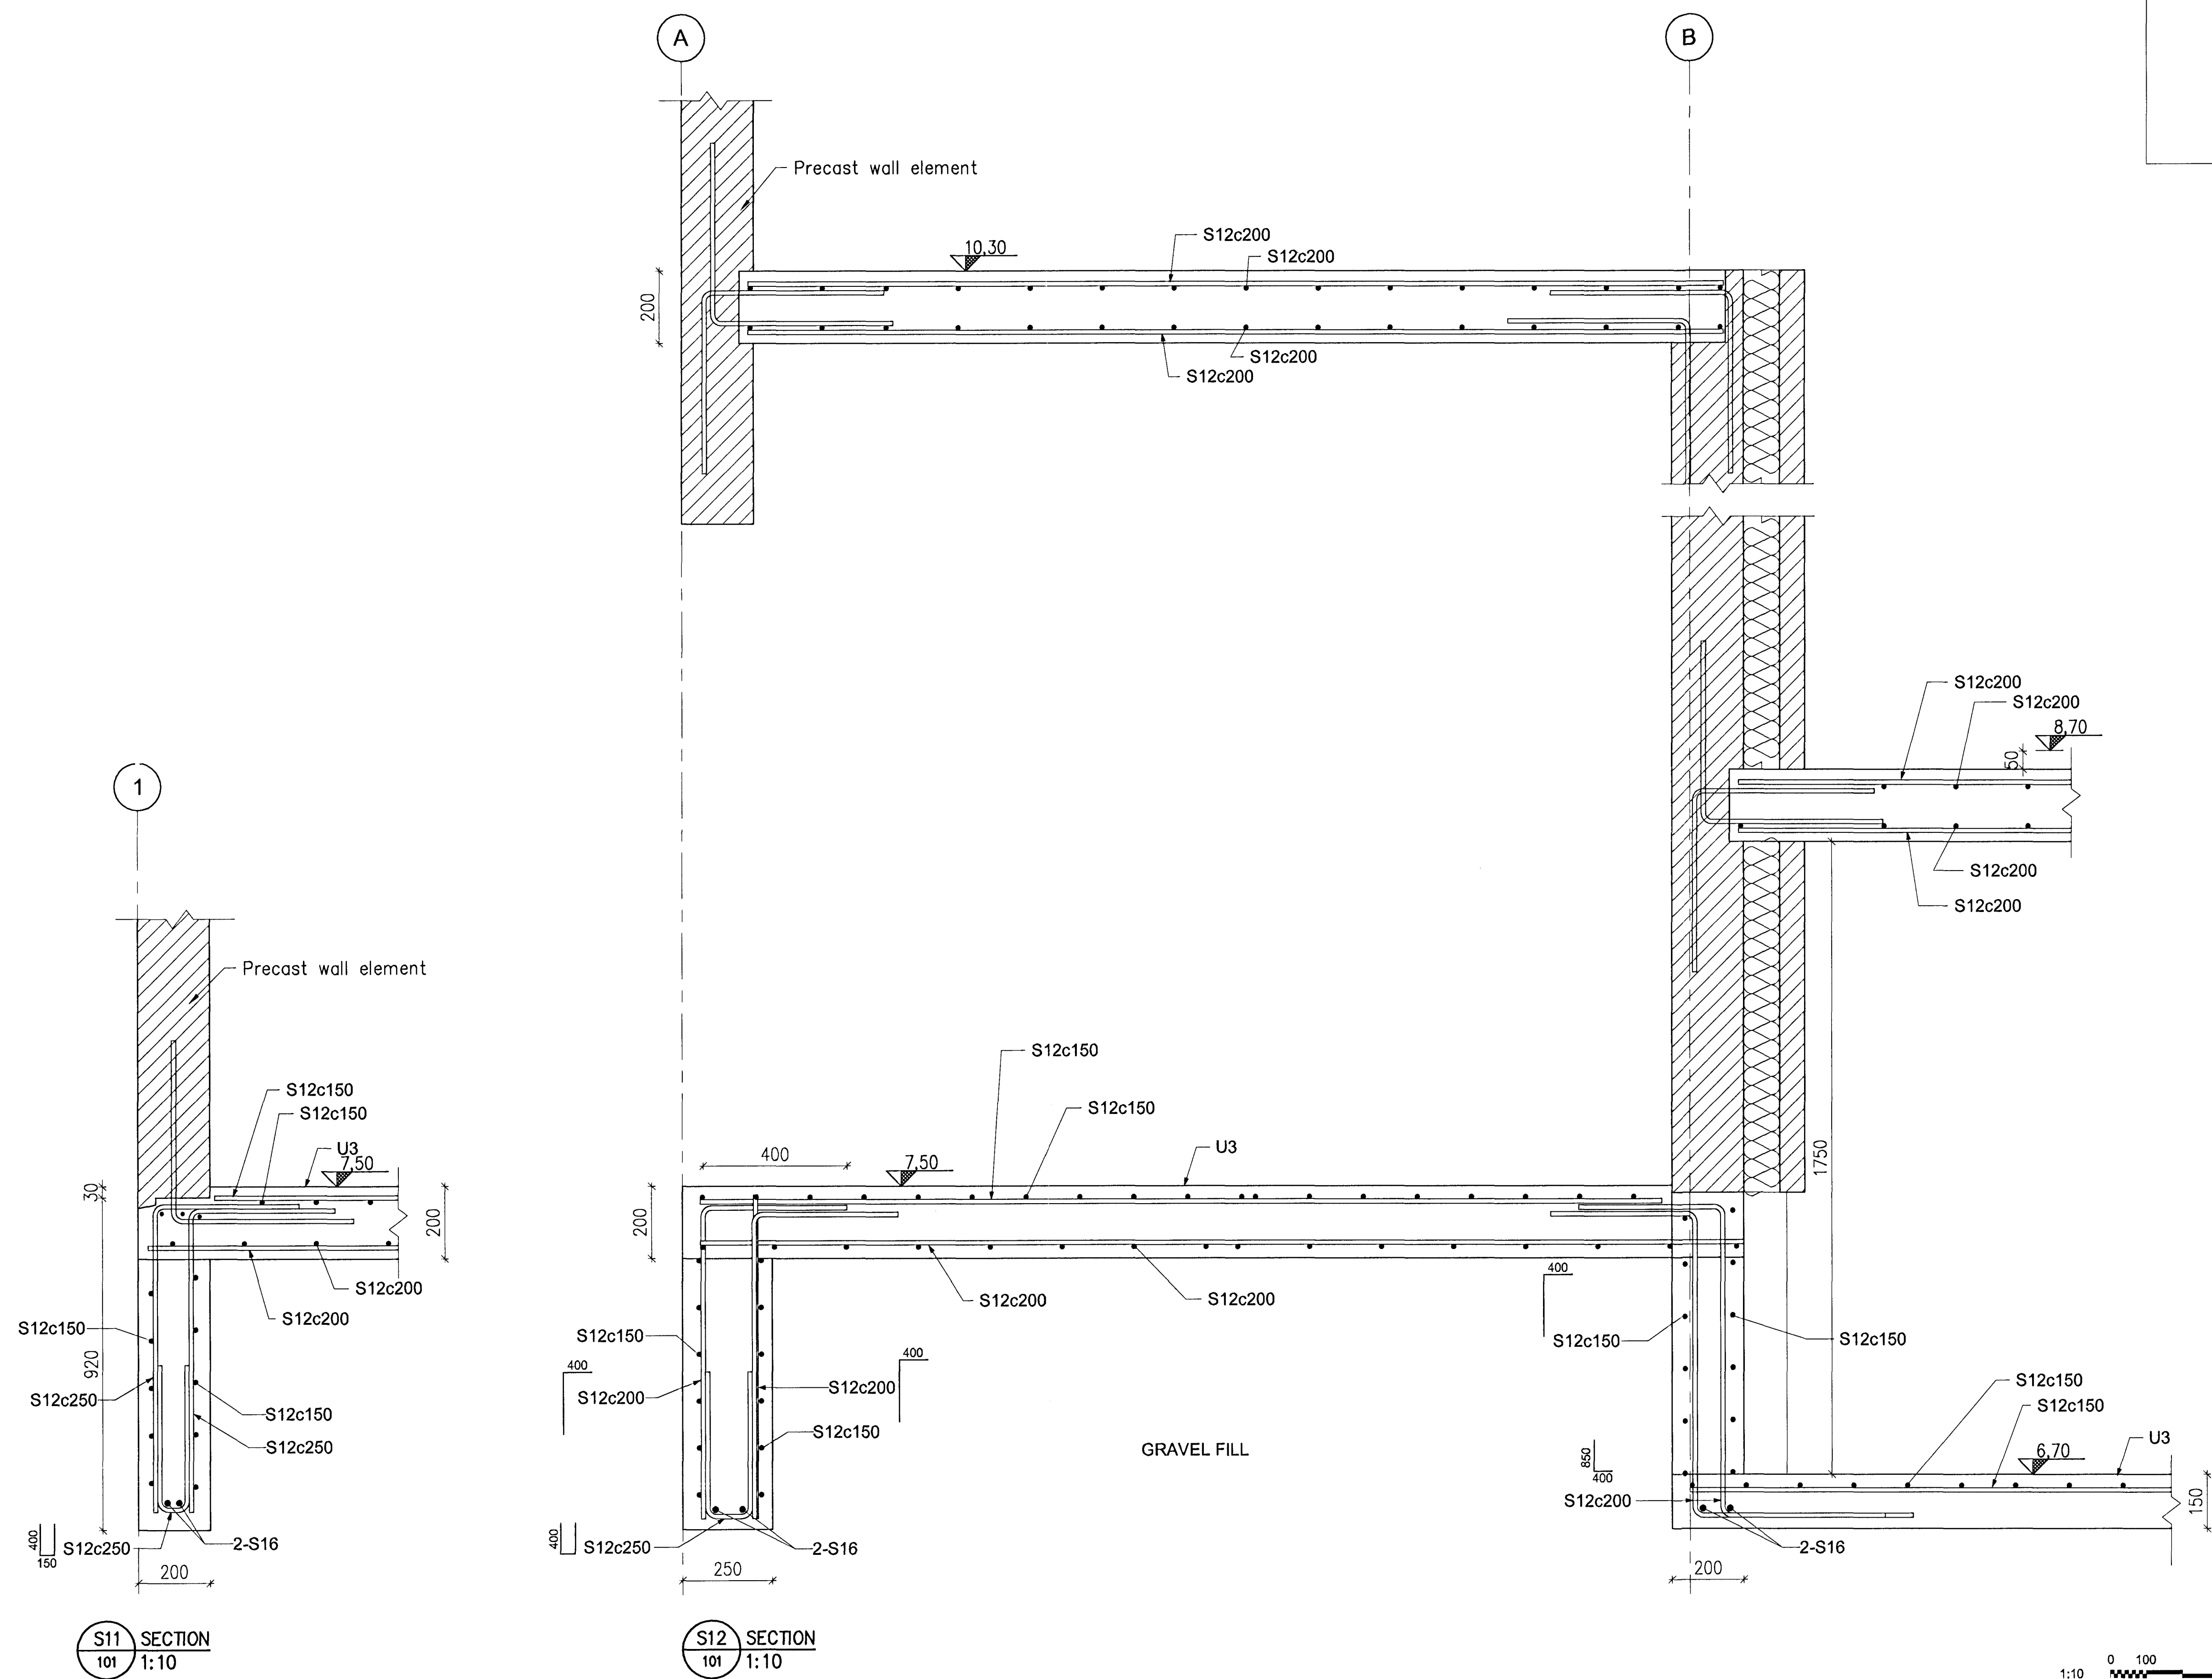

Skýringar:
 Legend:
 Prefabricated elements are shown on contractors drawings

6	Record drawing	2012.09.20	CMG	NI	FG	reka
Ólg. nr	Lýsing	Dagsetning	Hon./Tkn	Yfir	Notk. heim	Notk. heim
Rev. no	Description	Date	Des./Dw	Old	Suppl. Ref	ISAL Ref

This drawing is the property of Rio Tinto Alcan Iceland Ltd. and handed out for personal use only. It may neither be copied nor made available to others without permission of Rio Tinto Alcan Iceland Ltd. The receiver is liable for any misuse.			
Dagsetning / Date	2011.02.14	Hannað / Designed	Tekin / Drawn
Höfundur / Author	HFB	Verktaki / Supplier	HRV
Tekn.nr.verkþoka / Supplier drw.no.	IDP-212-CA-062-105	Yfir / Chkd	HJH
Sambýkkt / Approved	NI	Hluti af / Part of:	

IPU 212 - SUBSTATION 140		Flokkur nr.:	Blað nr.:	Nesta bl. nr.:
CIVIL WORK		Kostn.nr.-Ceno. /	Bán.nr.-Eq.no	
SLAB, SECTIONS		4011	16406	
REINFORCEMENT		AKS	UB140	
		Tekn.nr. ISAL / Drw.no. of ISAL	Breyt./Rev.	
Alcan Iceland Ltd Straumavík IS-222 Hafnarfordur Ísland		251422	A	
ISAL Yfirráð og skráð, dags / ISAL Checked, date		ISAL Samþykkt, dags / ISAL Approved, date		