Samþykkt þann
26 OCT 2012
Byggingafulltrúinn í Hafnarfirði
F.h. Sigurður Steinar Jónsson

Nicki Indriðason
Kt. 181144-3949

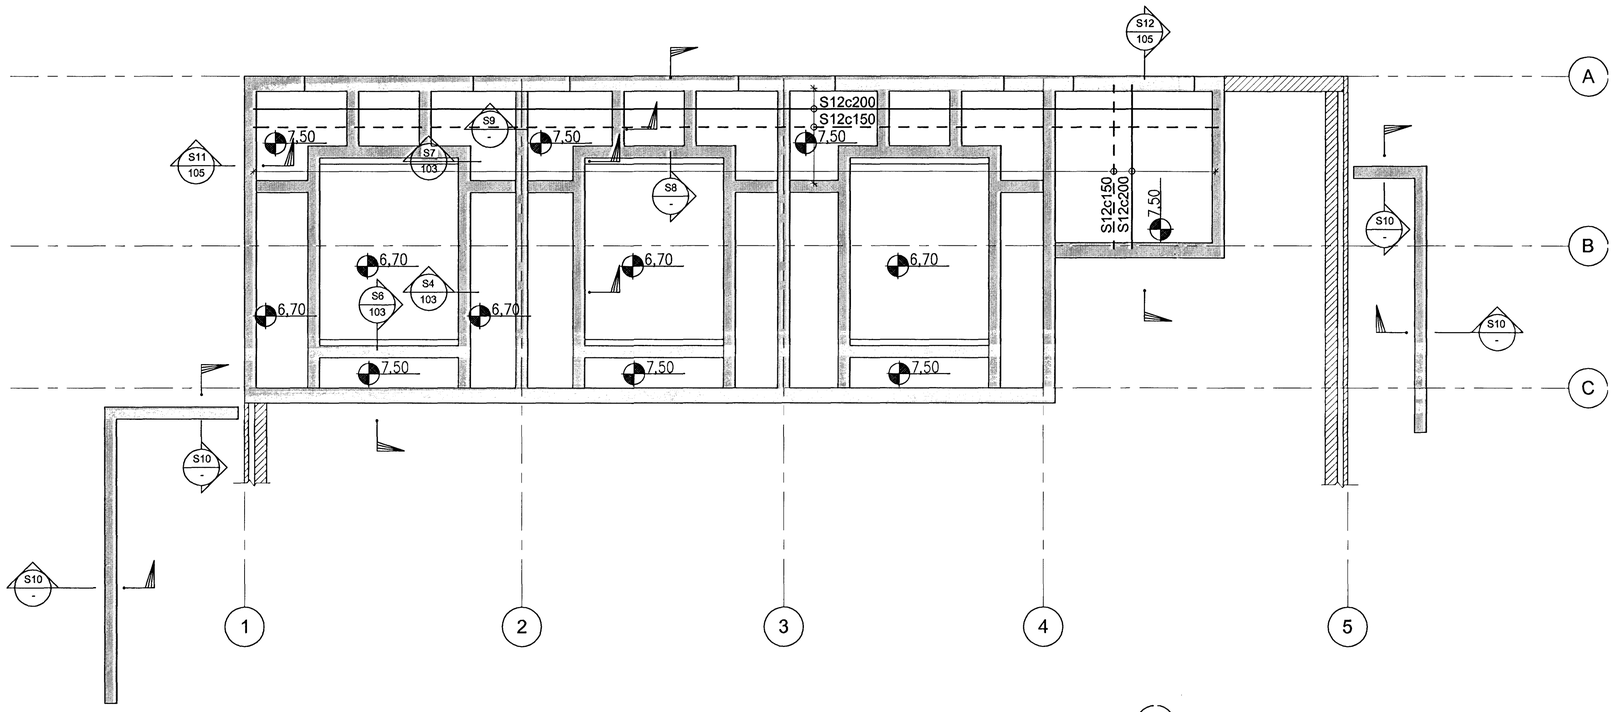

PLAN, LEVEL 7.50, 1:50

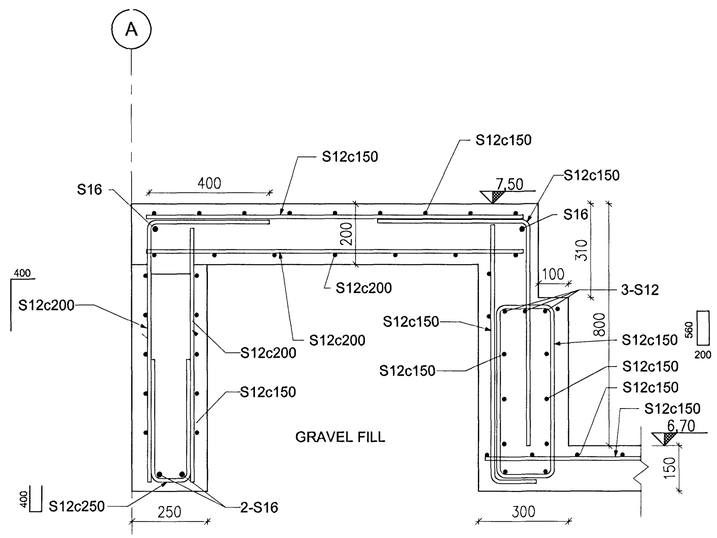

S8 SECTION - 1:10

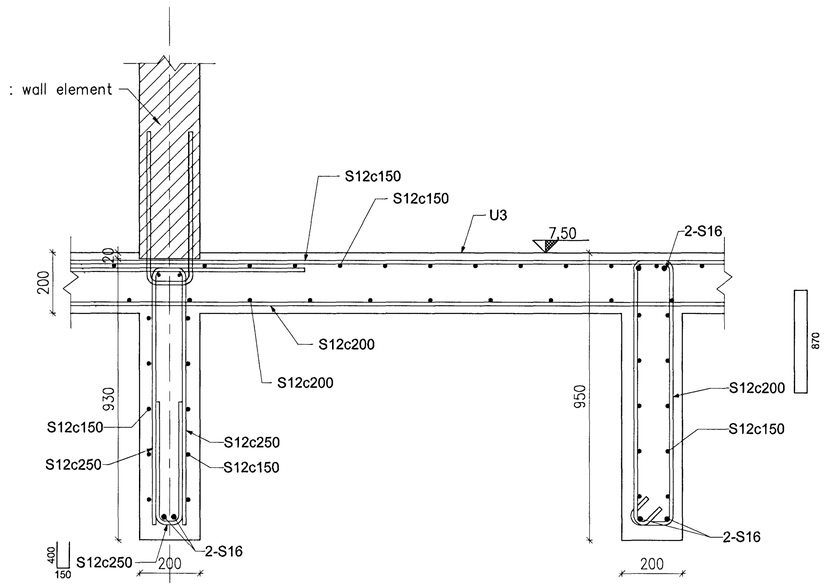

S9 SECTION - 1:10

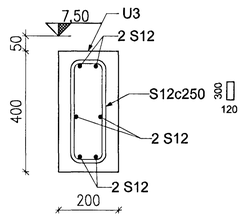

S10 SECTION - 1:10

1:10 0 100 500 1000mm

1:50 0 1000 5000mm

Skýringar:
Legend:
Prefabricated elements are shown on contractors drawings

C:\IDP\01 IDP\200 – Utilities\210 Electical energy supply\Drawings\Civil\IDP-212-CA-062-104.dwg

Útg nr Rev no	Lýsing Description	Dagsetning Date	Han/Tkn Des/Drw	Yfirf Ckd	Notk heim Suppl Ref	Notk heim ISAL Ref
5	Record drawing	2012.09.20	GMG	NI		

This drawing is the property of Rio Tinto Alcan Iceland Ltd. and handed out for personal use only it may neither be copied nor made available to others without permission of Rio Tinto Alcan Iceland Ltd. The receiver is liable for any misuse.

Stærð / Format: A1 Mkv. / Scale: 1:10, 1:50
Dimensions without tolerances according to ISO 2768-1 medium.

HRV & HATCH JOINT VENTURE ISAL PRODUCTION UPGRADE

Dagsetning / Date	2011.02.14
Hannað / Designed	HFB
Teikn / Drawn	HFB/AFV
Verktaki / Supplier	HRV
Teikn.nr.verktaka / Supplier drw.no.	IDP-212-CA-062-104
Samþykkt / Approved	NI
Yfirf / Chkd	HjH
Hluti af: / Part of:	

IPU 212 – SUBSTATION 140
CIVIL WORK
SLAB, PLAN AND SECTIONS
Teg.teikningar / Dwg. type: REINFORCEMENT

Rio Tinto Alcan
ISAL
Alcan Iceland Ltd
Straumsvik
IS-222 Hafnarfjordur
Iceland

Flokkur nr.:	Bloð nr.:	Nasta bl.nr.:

Kostn.nr.-Cono. / Bún.nr.-Eq.no
4011 16406
AKS
UB140

Teikn.nr. ISAL /Drw.no. of ISAL	Breyt./Rev.
251421	A

ISAL Yfirfarið og skráð, dags / ISAL Checked, date
ISAL Samþykkt, dags / ISAL Approval, date