



OFNATAFLA OFNAGERS -RANTAL

OFN NR.	HITAKORF KCAL/T	LENGD MM	HÆD MM	TENGING ALIC
11	800	1400	400	C-D
12	700	1400	400	C-D
13	8500	4500	400	C-D

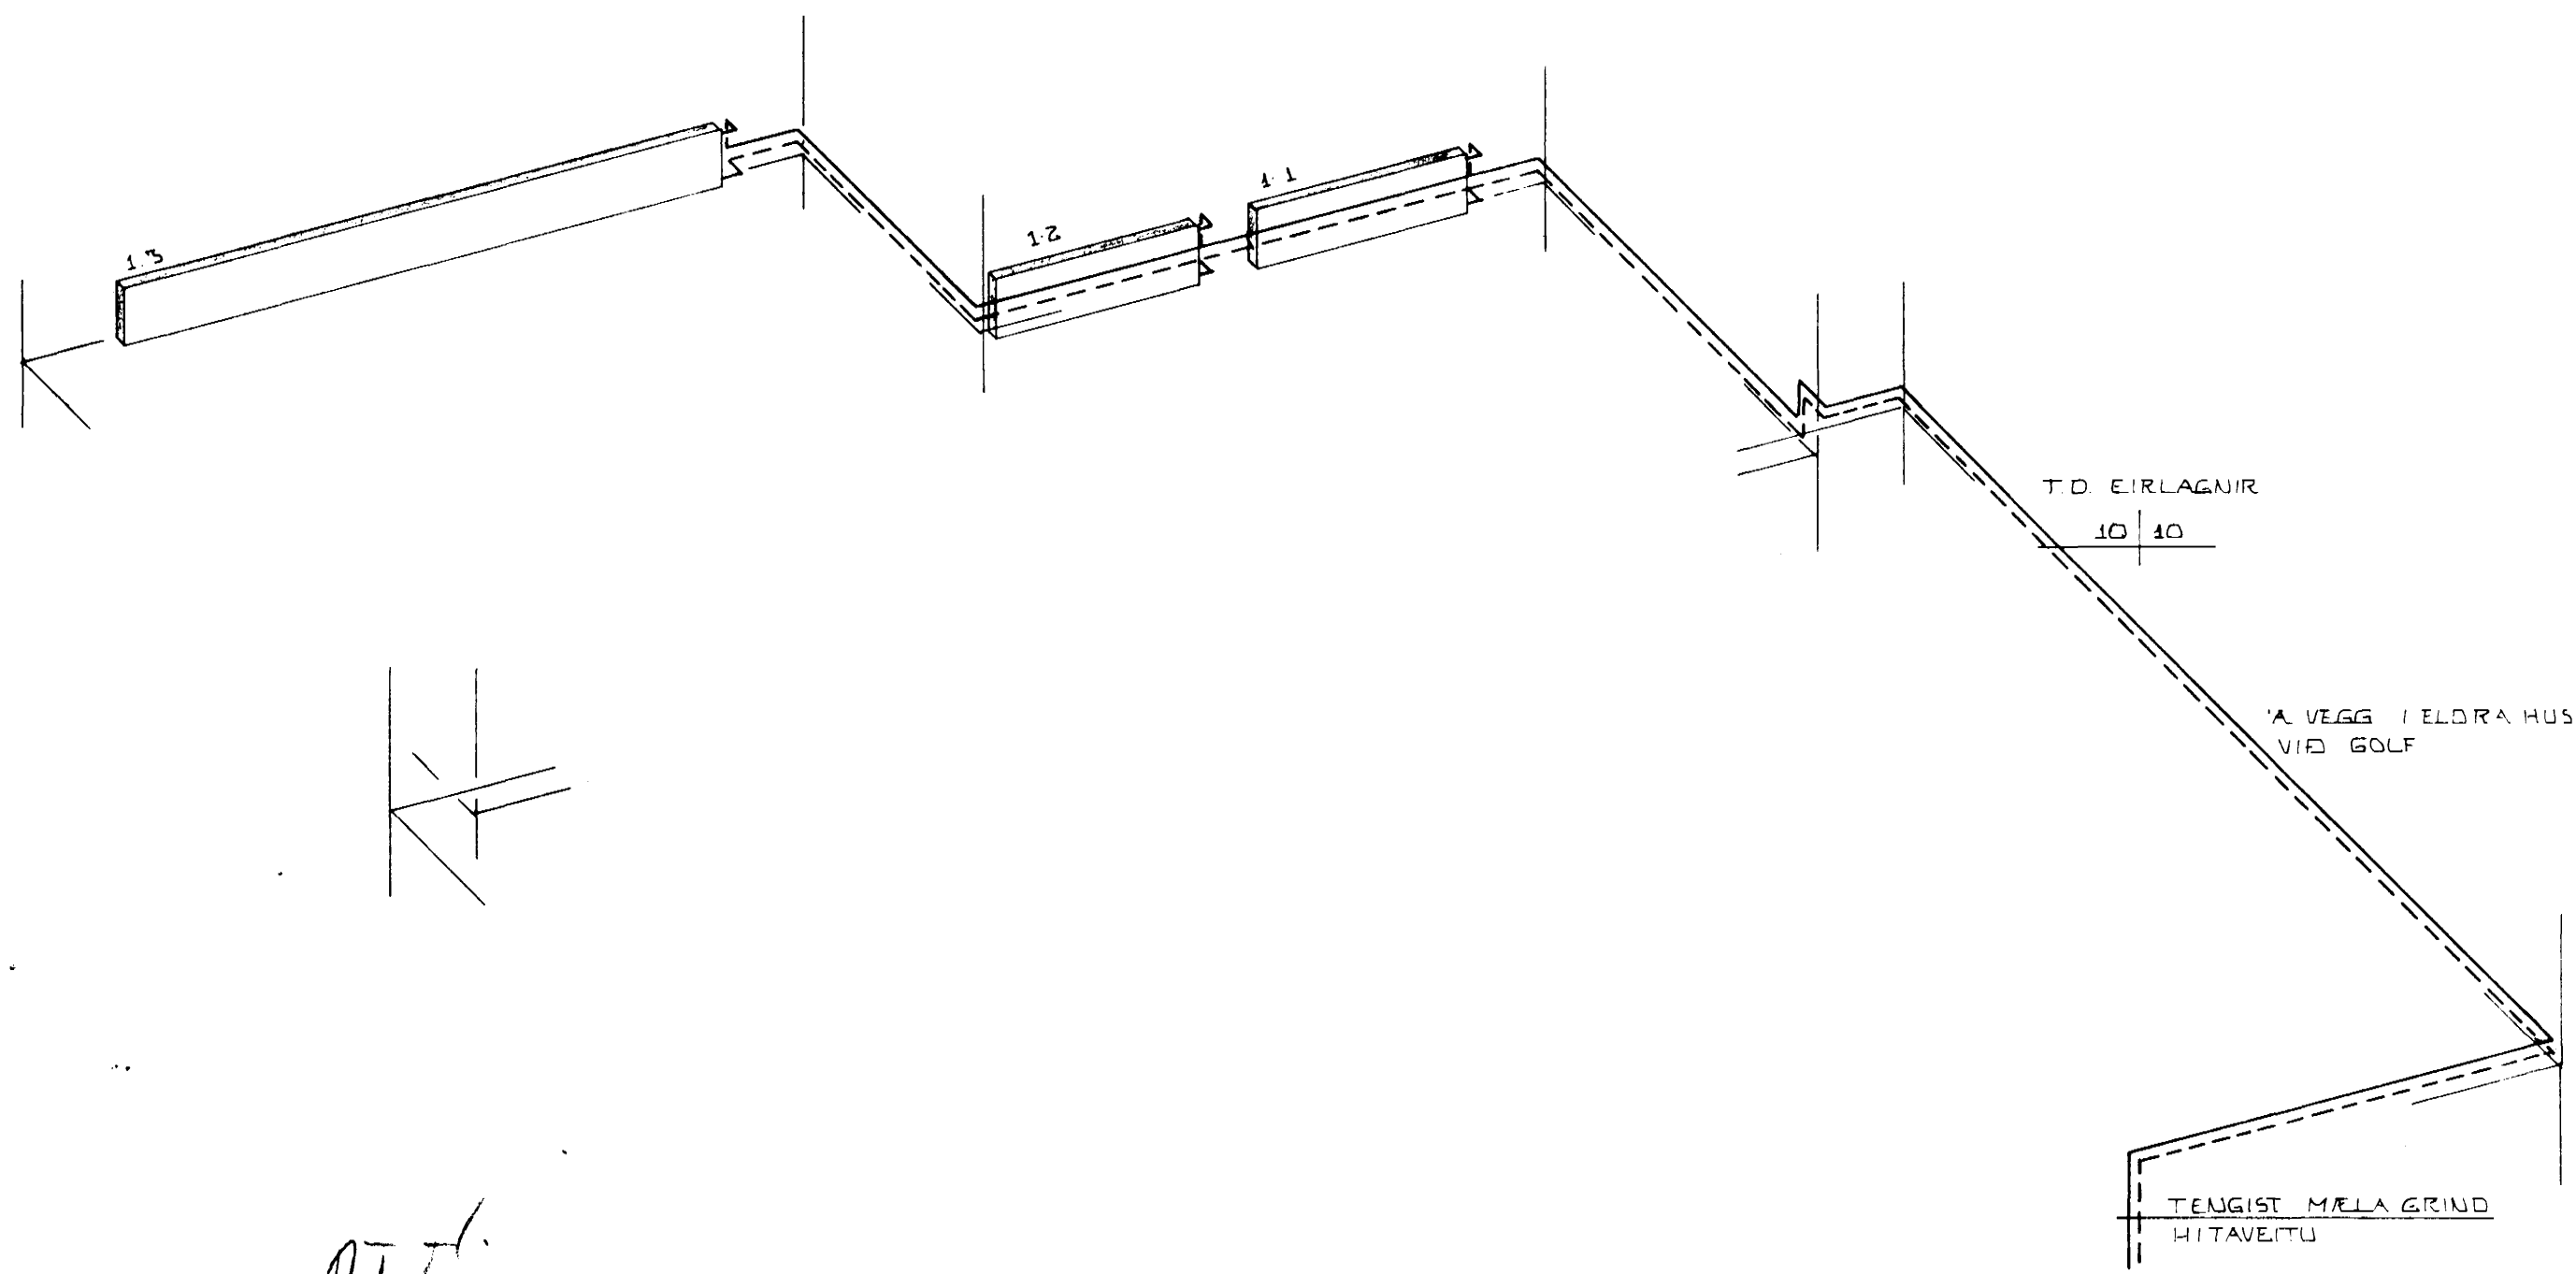


ATT.
EIT HERR B.
EINKI OFN

KERFISMYND 1:50

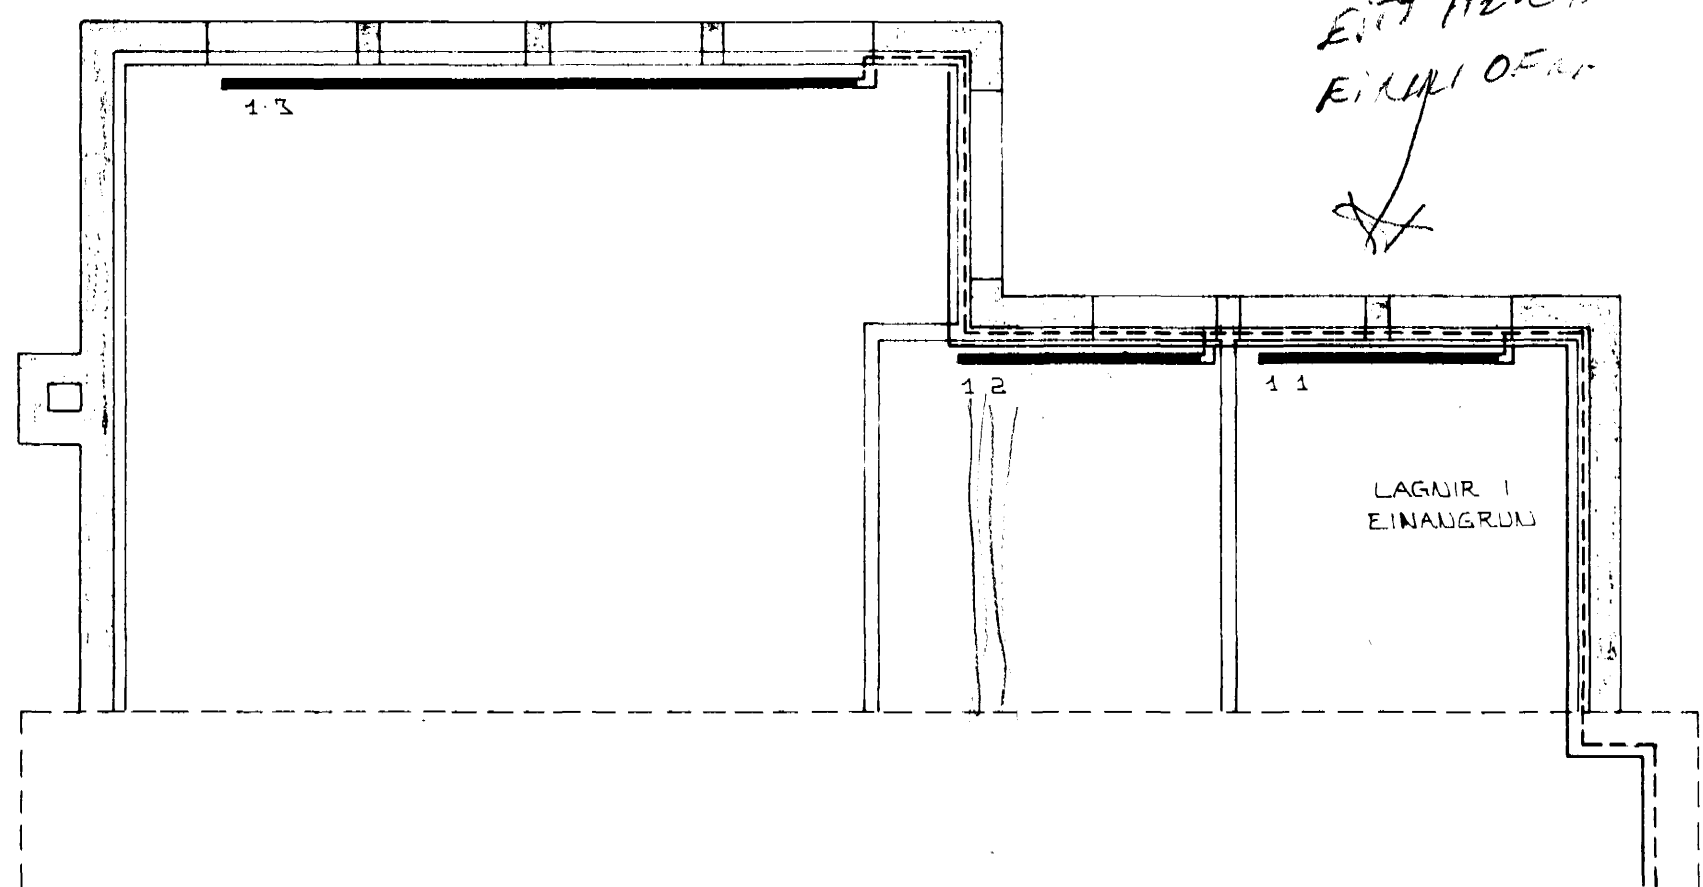

GRUNNUMYND 1:50

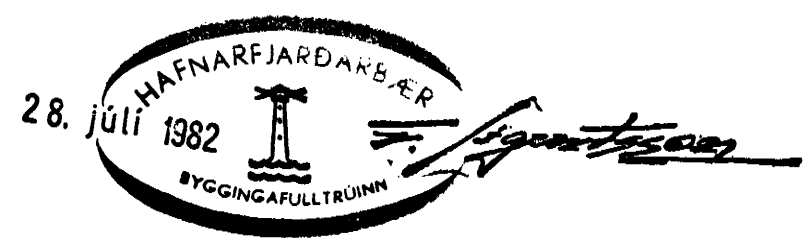

ARNARHRAUN 10 HAFNARFIRÐI VIÐBYGGING	DAGS 820714
HITALAGNIR	REIKN. 219
MÆLIKV 1:50	TEIKN. WYS
SIGURÐUR ÞORLEIFSSON TÆKNIPRÆÐINGUR	VERK NR.
STRANDGÖTU 11 HAFNARFIRÐI SÍMI 54754	TEIKN. NR.