

Skýringar:

| ÚTGÁFA | LAGSETNING | TEIKNAD | YFIRFARD | SAMÞYKKI |
|--------|------------|----------|----------|----------|
| 02 | SEP 03 | SI/Ó.D.J | Ó.D.J | |

EDLI Breytingar REYNDARTEKNING

LYKLIMYND:

| Dagur | Hannaf | Yrit | Samp. | Stad |
|----------|----------|-------|-------|------|
| 14.03.01 | SI/Ó.D.J | Ó.D.J | | A1 |


AFL Verkfæðistofa
Bíldshóla 14
110 Reykjavík
Sími 587 6465

Grúnskóli í Áslandi
Krfúds 1, Hafnarfirði

Tafla T0.1
Einlínumynd

| | | |
|-------|-----|--------|
| Feril | Ugn | Stödur |
| = | + | + |

| | | |
|--------------|------|--------------|
| Tekn. nr. | Útg. | Bl. |
| 238-00-40-02 | 02 | 02 |
| Tekn. nr. | Útg. | Bl. |
| | | Næsta útgáfa |

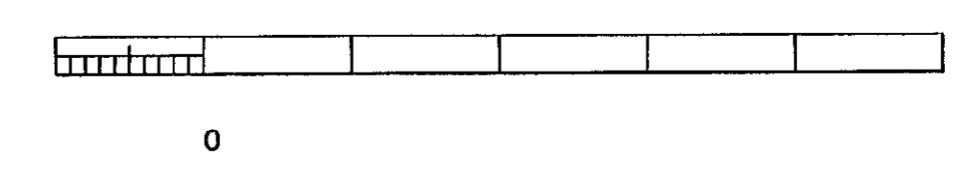

H. Adonsskili / AFL reifingaskil / Útprintar / 238-00-40-01