


Skýringar:


| | | | | |
|--------|------------|----------|----------|----------|
| UTGÁFA | DAGSETNING | TEKNIÐ | YFIRFUND | SAMMYNKT |
| 02 | SEP 03 | S./Ó.D.J | Ó.D.J | |

EDLI BREYTINGAR REYNDARTEIKNING

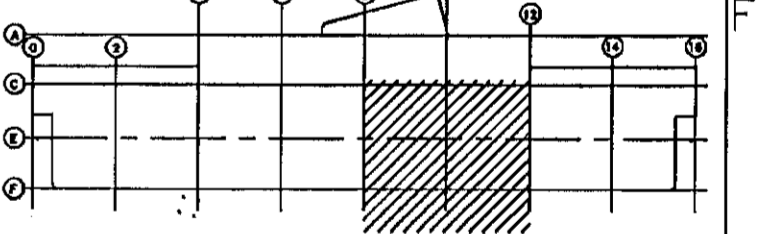

| | | | | |
|----------|----------|--------|-------|------|
| Dags. | Hannsó | Yfirt. | Samp. | Íbúð |
| 27.12.00 | S./Ó.D.J | Ó.D.J | | A1 |


AFL Verkfræðistofa
Bíldshöfða 14
110 Reykjavík
Sími 587 6465

Verkefni
Grunnskóli í Áslandi
Kriúðs 1, Hafnarfirði

2.hæð Lampaplan
Grunnmynd 5

| | | |
|-------|------|--------|
| Forli | Lögn | Staður |
| = | + | + |

| | | |
|-----------|------|-------------|
| Tekn. nr. | Útg. | Skr. |
| 238-02-30 | 02 | 17 |
| Tekn. nr. | Útg. | Bl. |
| | | 18 |
| | | Nýasta útg. |

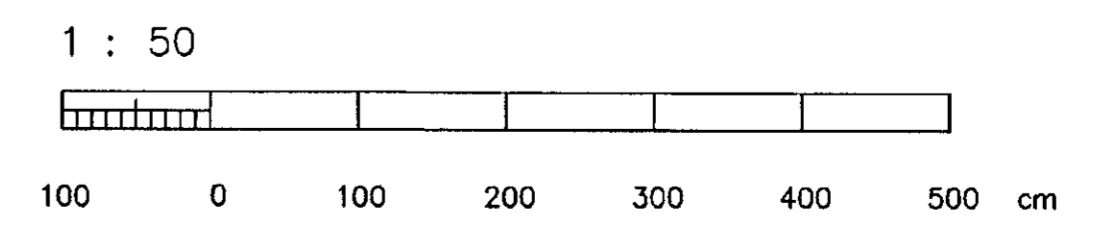

H: Áslandskóli/AFL rafmagnshlutí/Útrentani/238-02-30-01