


Skýrtingar:

UTGAFA	DAGSETNING	TEIKNAD	YFIRFARAD	SAMÞYKKT
08	SEP 03	S./Ó.D.J.	Ó.D.J.	

EDLI Breytingar REYNDARTEIKNING

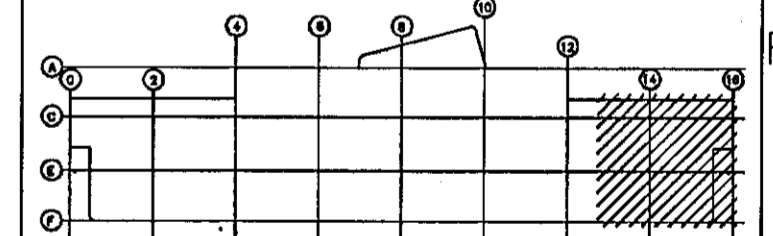

Dag.	Hannad	Yftr.	Samb.	Rao
27.04.01	S./Ó.D.J.	Ó.D.J.		A1


AFL Verkfræðistofa
Bíldshöfða 14
110 Reykjavík
Sími 587 6465

Verkefni
Grunnskóli í Áslandi
Kruús 1, Hafnarfjörð

1. hæð - Gagnalagnir og loftnet
Grunnmynd 6

Fell	Lögn	Stödur
=	+	+

Tekni. nr.	Úp.	Sks.
238-01-50	08	12
Tekni. nr.	Úp.	Sks.
		Næsta tölur

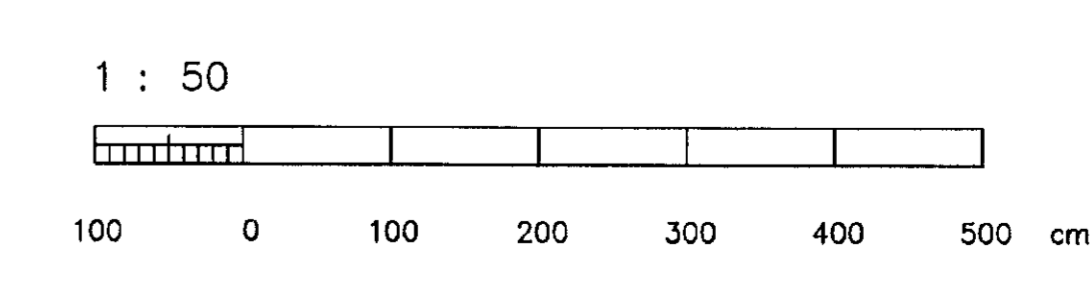

H: Áskilduáskil / Úprentunir / 238-01-50-06