


RÚMMYND VATSLAGNA, 1:50

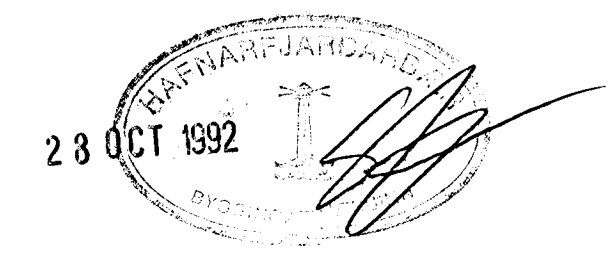

DI	20.10.92	LÖGNUM Í STEYPIBADI BREITT	4.21
BR NR	DAGS	EDLI BREVTINGAR	SIGN
VALLARHÚS HAUKA ÁSVÖLLUM			DAGS FEB. 92
NEYSLUVATNSLAGNIR, RÚMMYND			HAUJAR 4.21
			TEIKNAD 4.21
			VERK NR 9212
MALKV. 1:50			BLAD NR
SIGURÐUR ÞORLEIFSSON TEKNIFRÉÐINGUR F.T.F.I.			2-05
STRANDGÖTU 11 HAFNARFIRÐI SÍMI 54751/54255			