


GRUNNMYND. 1:50

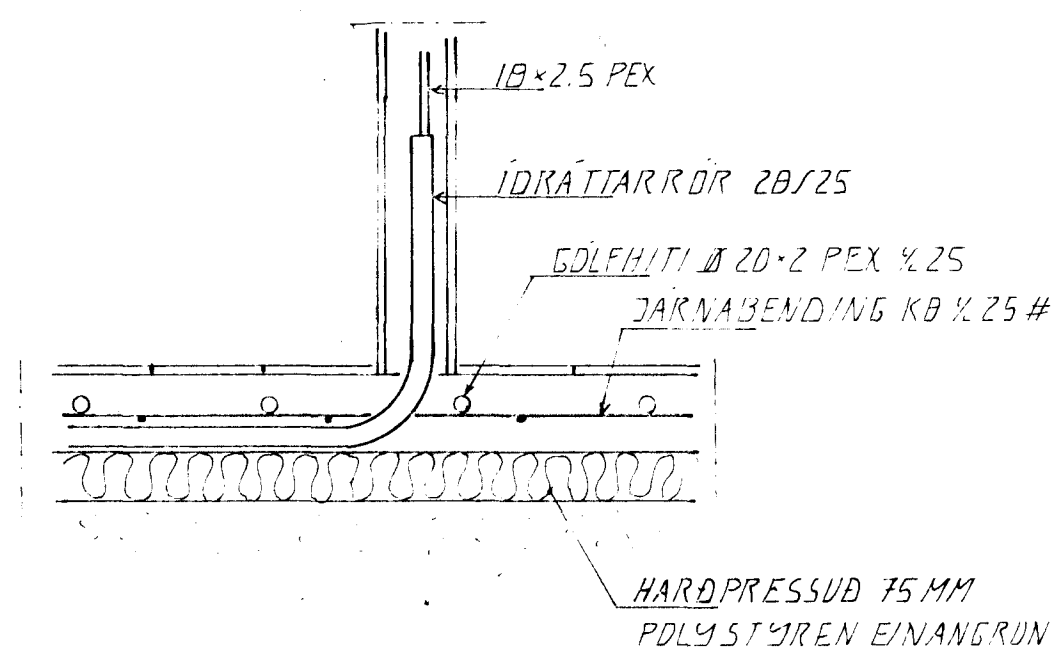

SNID I GOLF/VEGG. 1:10

28 OCT 1992

DI	20.10.92	LOGNUM I STEYPIBADI BREI TT	
BR NR	DAGS	EDLI BREVINGAR	SIGN.
		VALLARHÚS HAUKA ÁSVÖLLUM	DAGS FEB. 92
		NEYSLUVATNSLAGNIR, GRUNNMYND	HAUNAB 27
			TEIKNAD 27
			VERK NR 9212
		MELIKV. 1:50	BLAD NR
		SIGURÐUR ÞORLEIFSSON TEKNIFRÆÐINGUR F.T.F.M.	2-03
		STRANDGÖTU 11 HAFNARFIRÐI SÍMI 54751/54255	