



útlit - NV

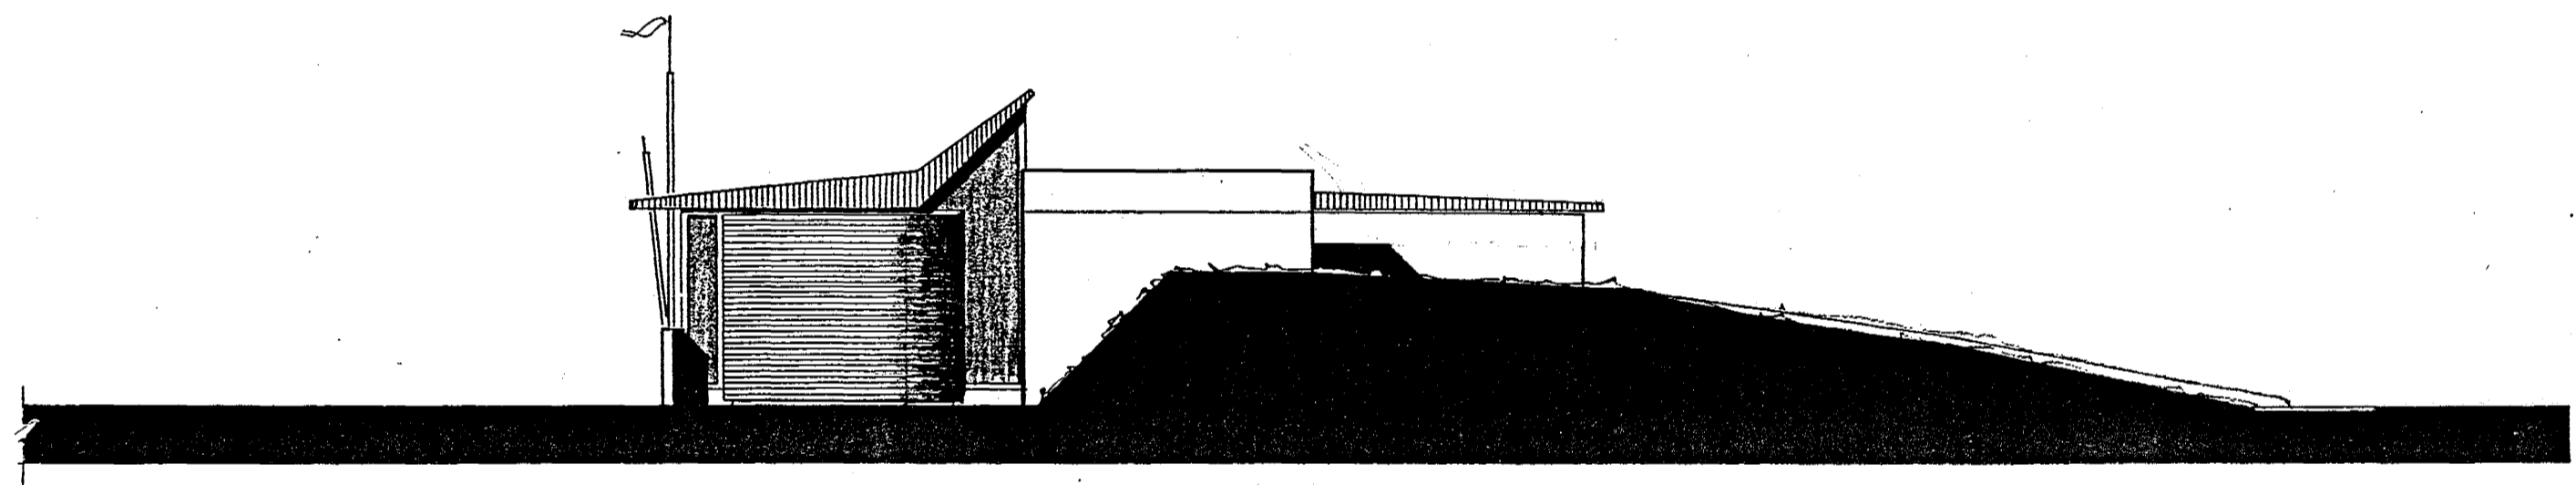

útlit - NA

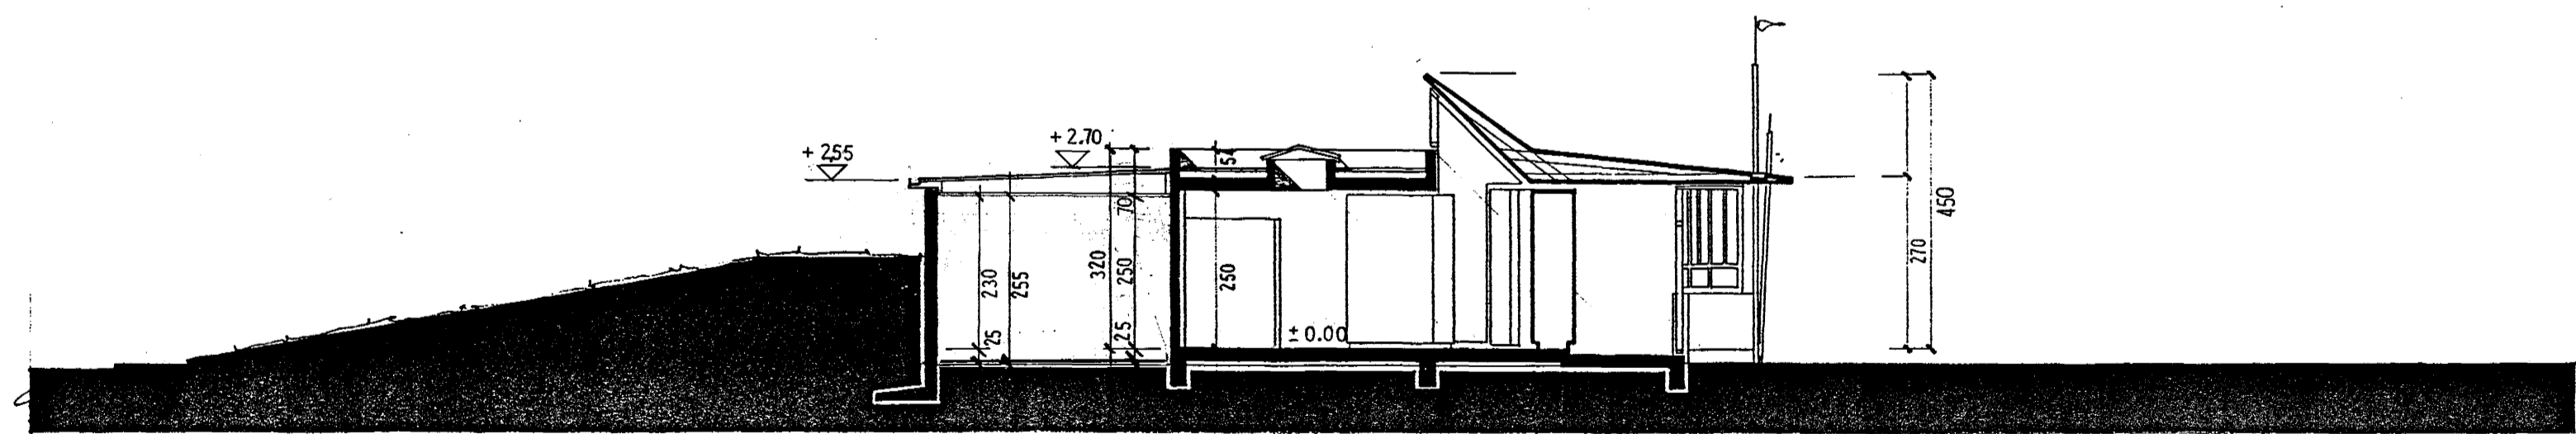

þverskurður

Á S V E L L I R - vallaehús HAUKA

dgs. 20. 04. 1991 mkv. 1.100

Breytt 12.10.97 byggt yfir port: geymsla *Talmepr.*

Pálmar Kristmundsson

PÁLMAR KRISTMUNDSSON ARKITEKT
 súðarvogi 36 - s: 678950 - 104 reykjavík