



SNID AA

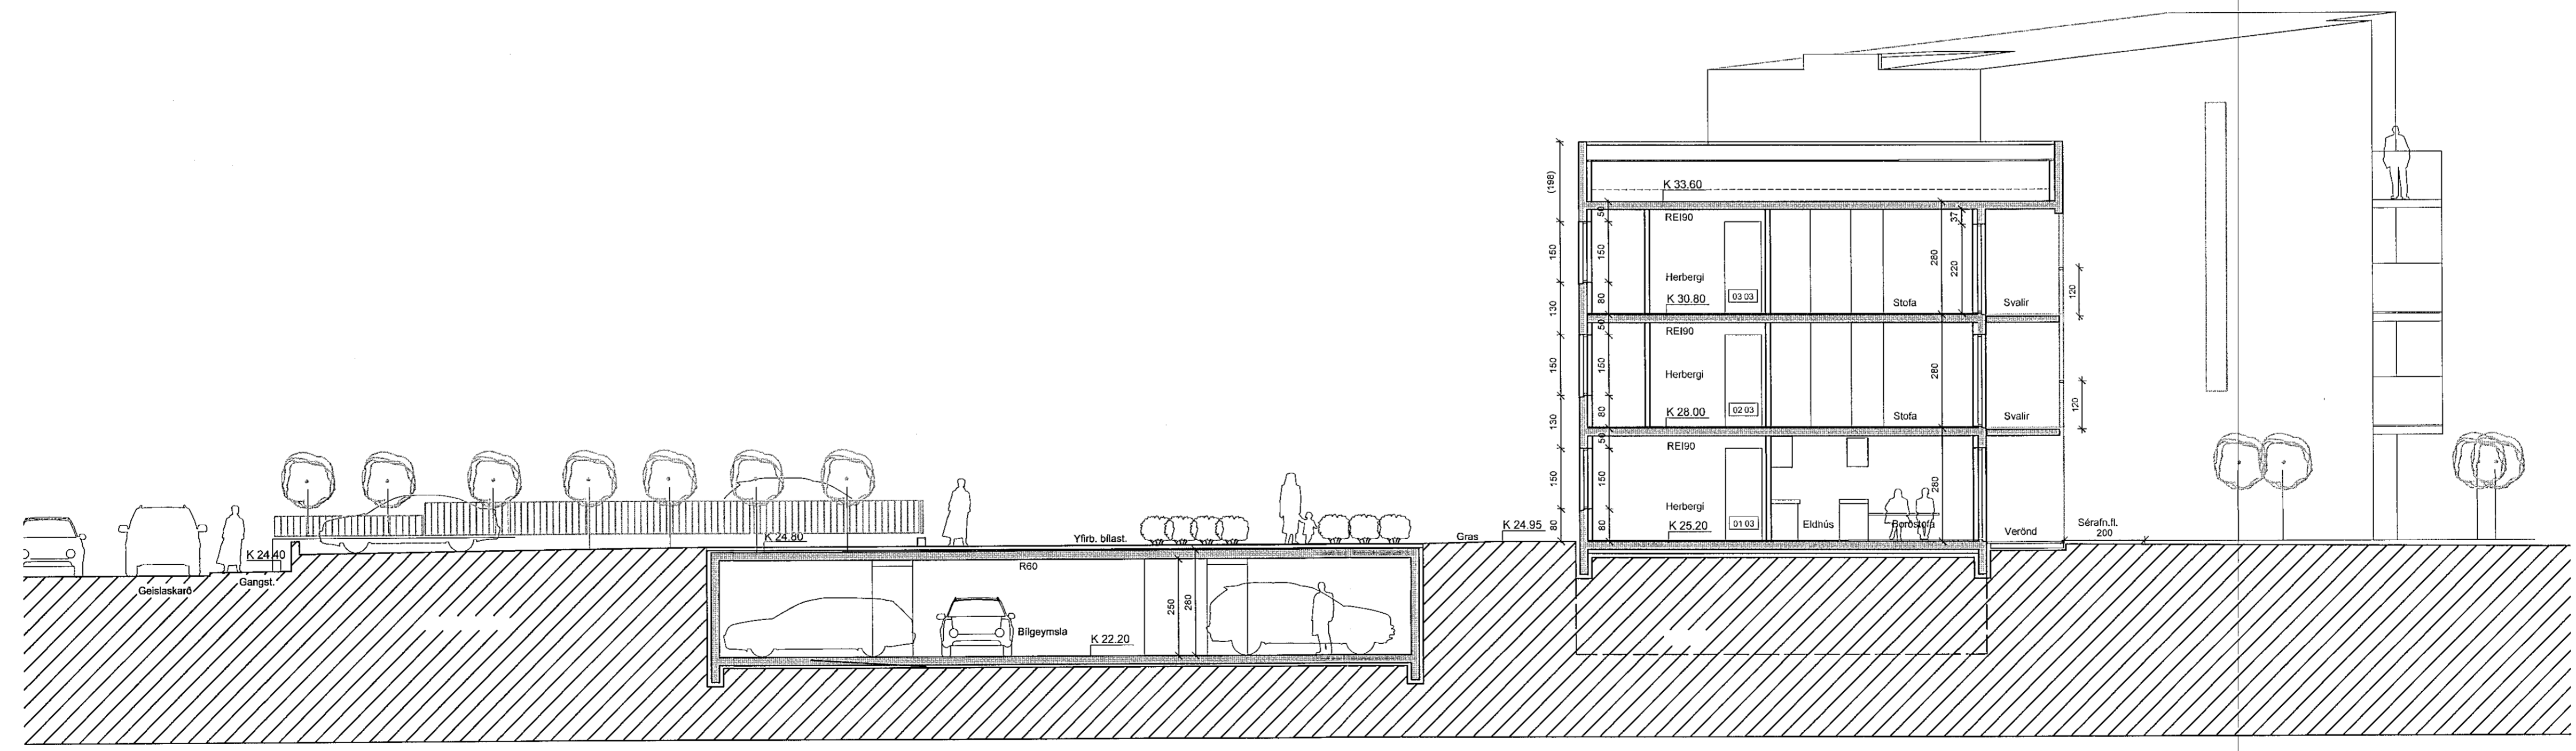

SNID CC

C:
B:
A: Áorðnar breytingar og stur. verkleiðningar og fylgibíó 25.11.2021
BREYTINGAR: DAGS:

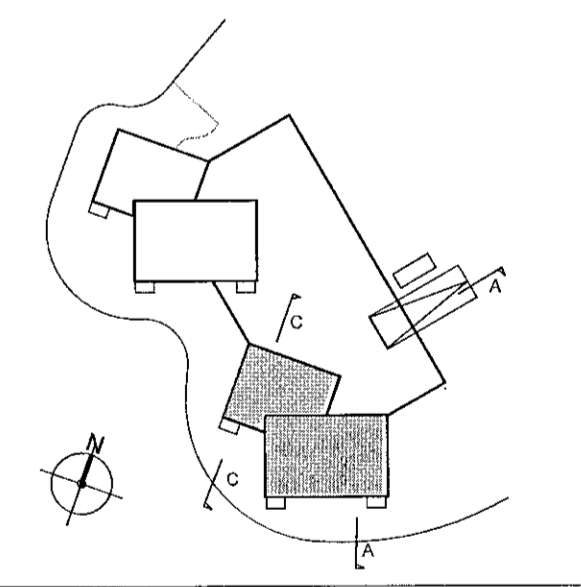

Geislaskarð 4-6 - Hafnarfirði Reitur 2
Geislaskarð 6 Matshluti 03 VERK: 1710-GEIS 4-6
SAS 5.1.2022 KVARDI: 1:100
DAGS: 10.01-18
TEIKN: BOS-GS
SNID-ÚTLIT SKRÁ: Grunnur.dwg

ÚTI INNI
ARKITEKTAR
ÞINGHOLTSSÍTR/ETI 27 101 REYKJAVÍK
SÍMAR 552 7660 & 562 7660 FAX 552 7661
NETFANG ut@utis VEFANG utis
BALDUR Ó. SVAVARSSON ARKITEKTAR FAI
JÓN HÖR ÞORVALDSSON ARKITEKTAR FAI
021256-5149 021256-7579