
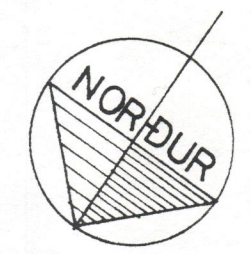
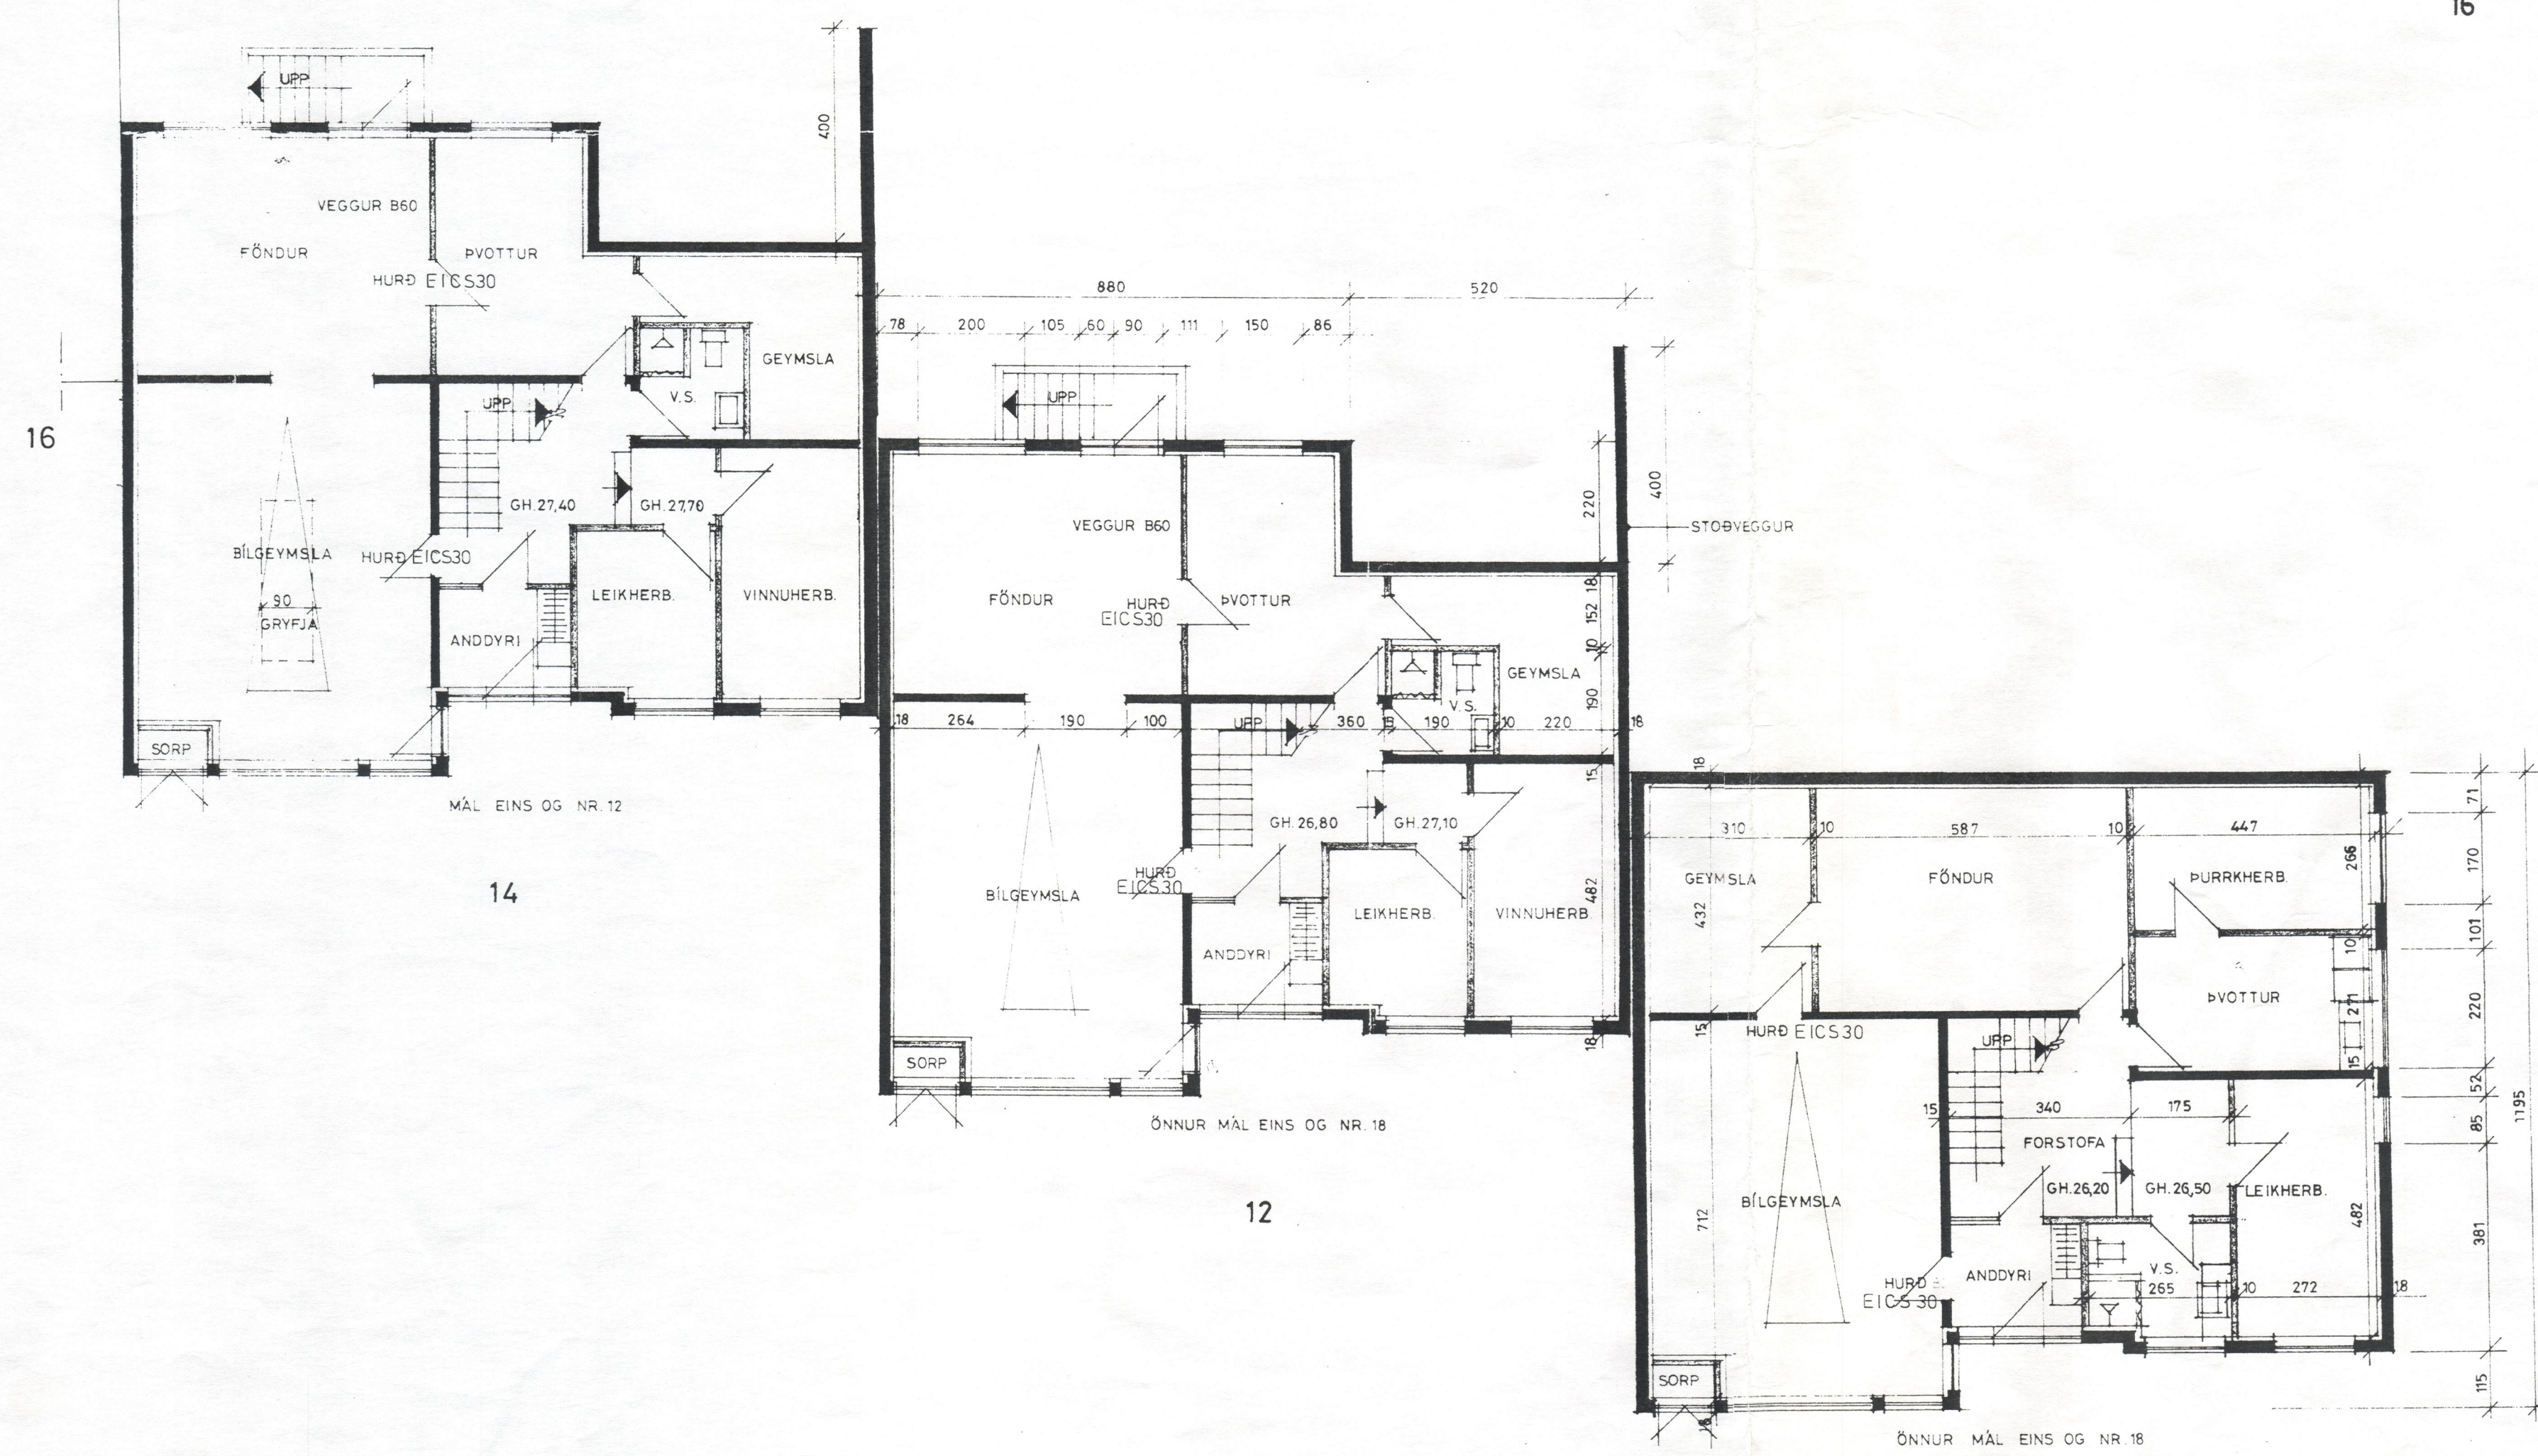


KJP

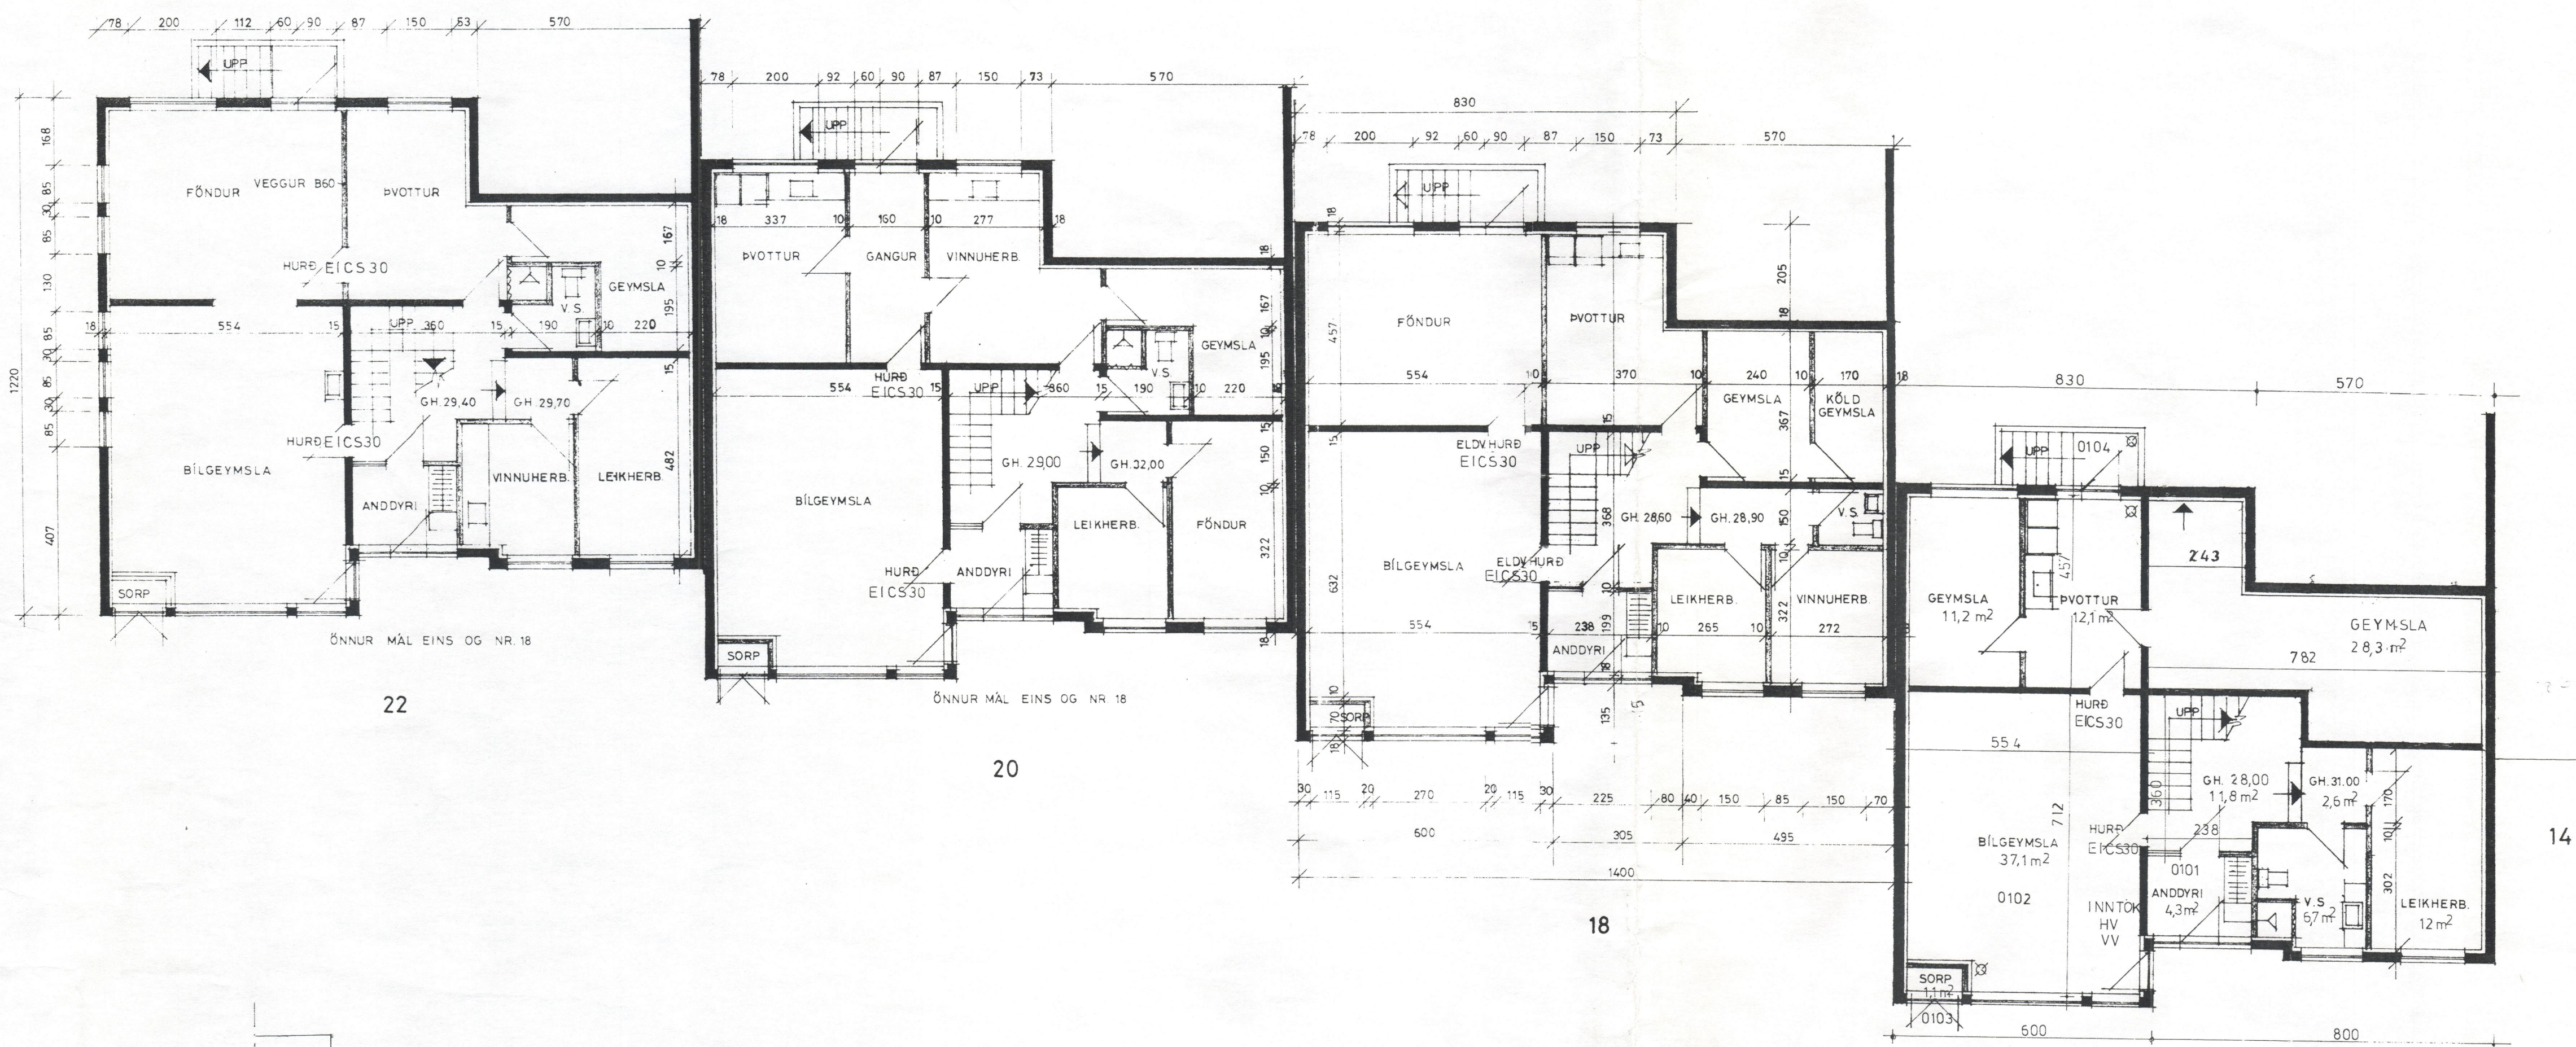

breytt 30.09'02 kj

O.K.Arkitektar ehf.	Nýbýlavegi 22
Lækjarhvamur 16	kf.700402-6140
grunnmynd neðri hæð	hannað Kristín Jónsdóttir
dags 17.07.2002	mk. 1:100
	nr. 4